



S. S. N^{os.} 179. & 182.

LENGTH B.P.	314'-0"
BREADTH EXT.	46'-6"
DEPTH MLD	23'-0½"

— SCALE $\frac{1}{2}" = 1$ FOOT. —

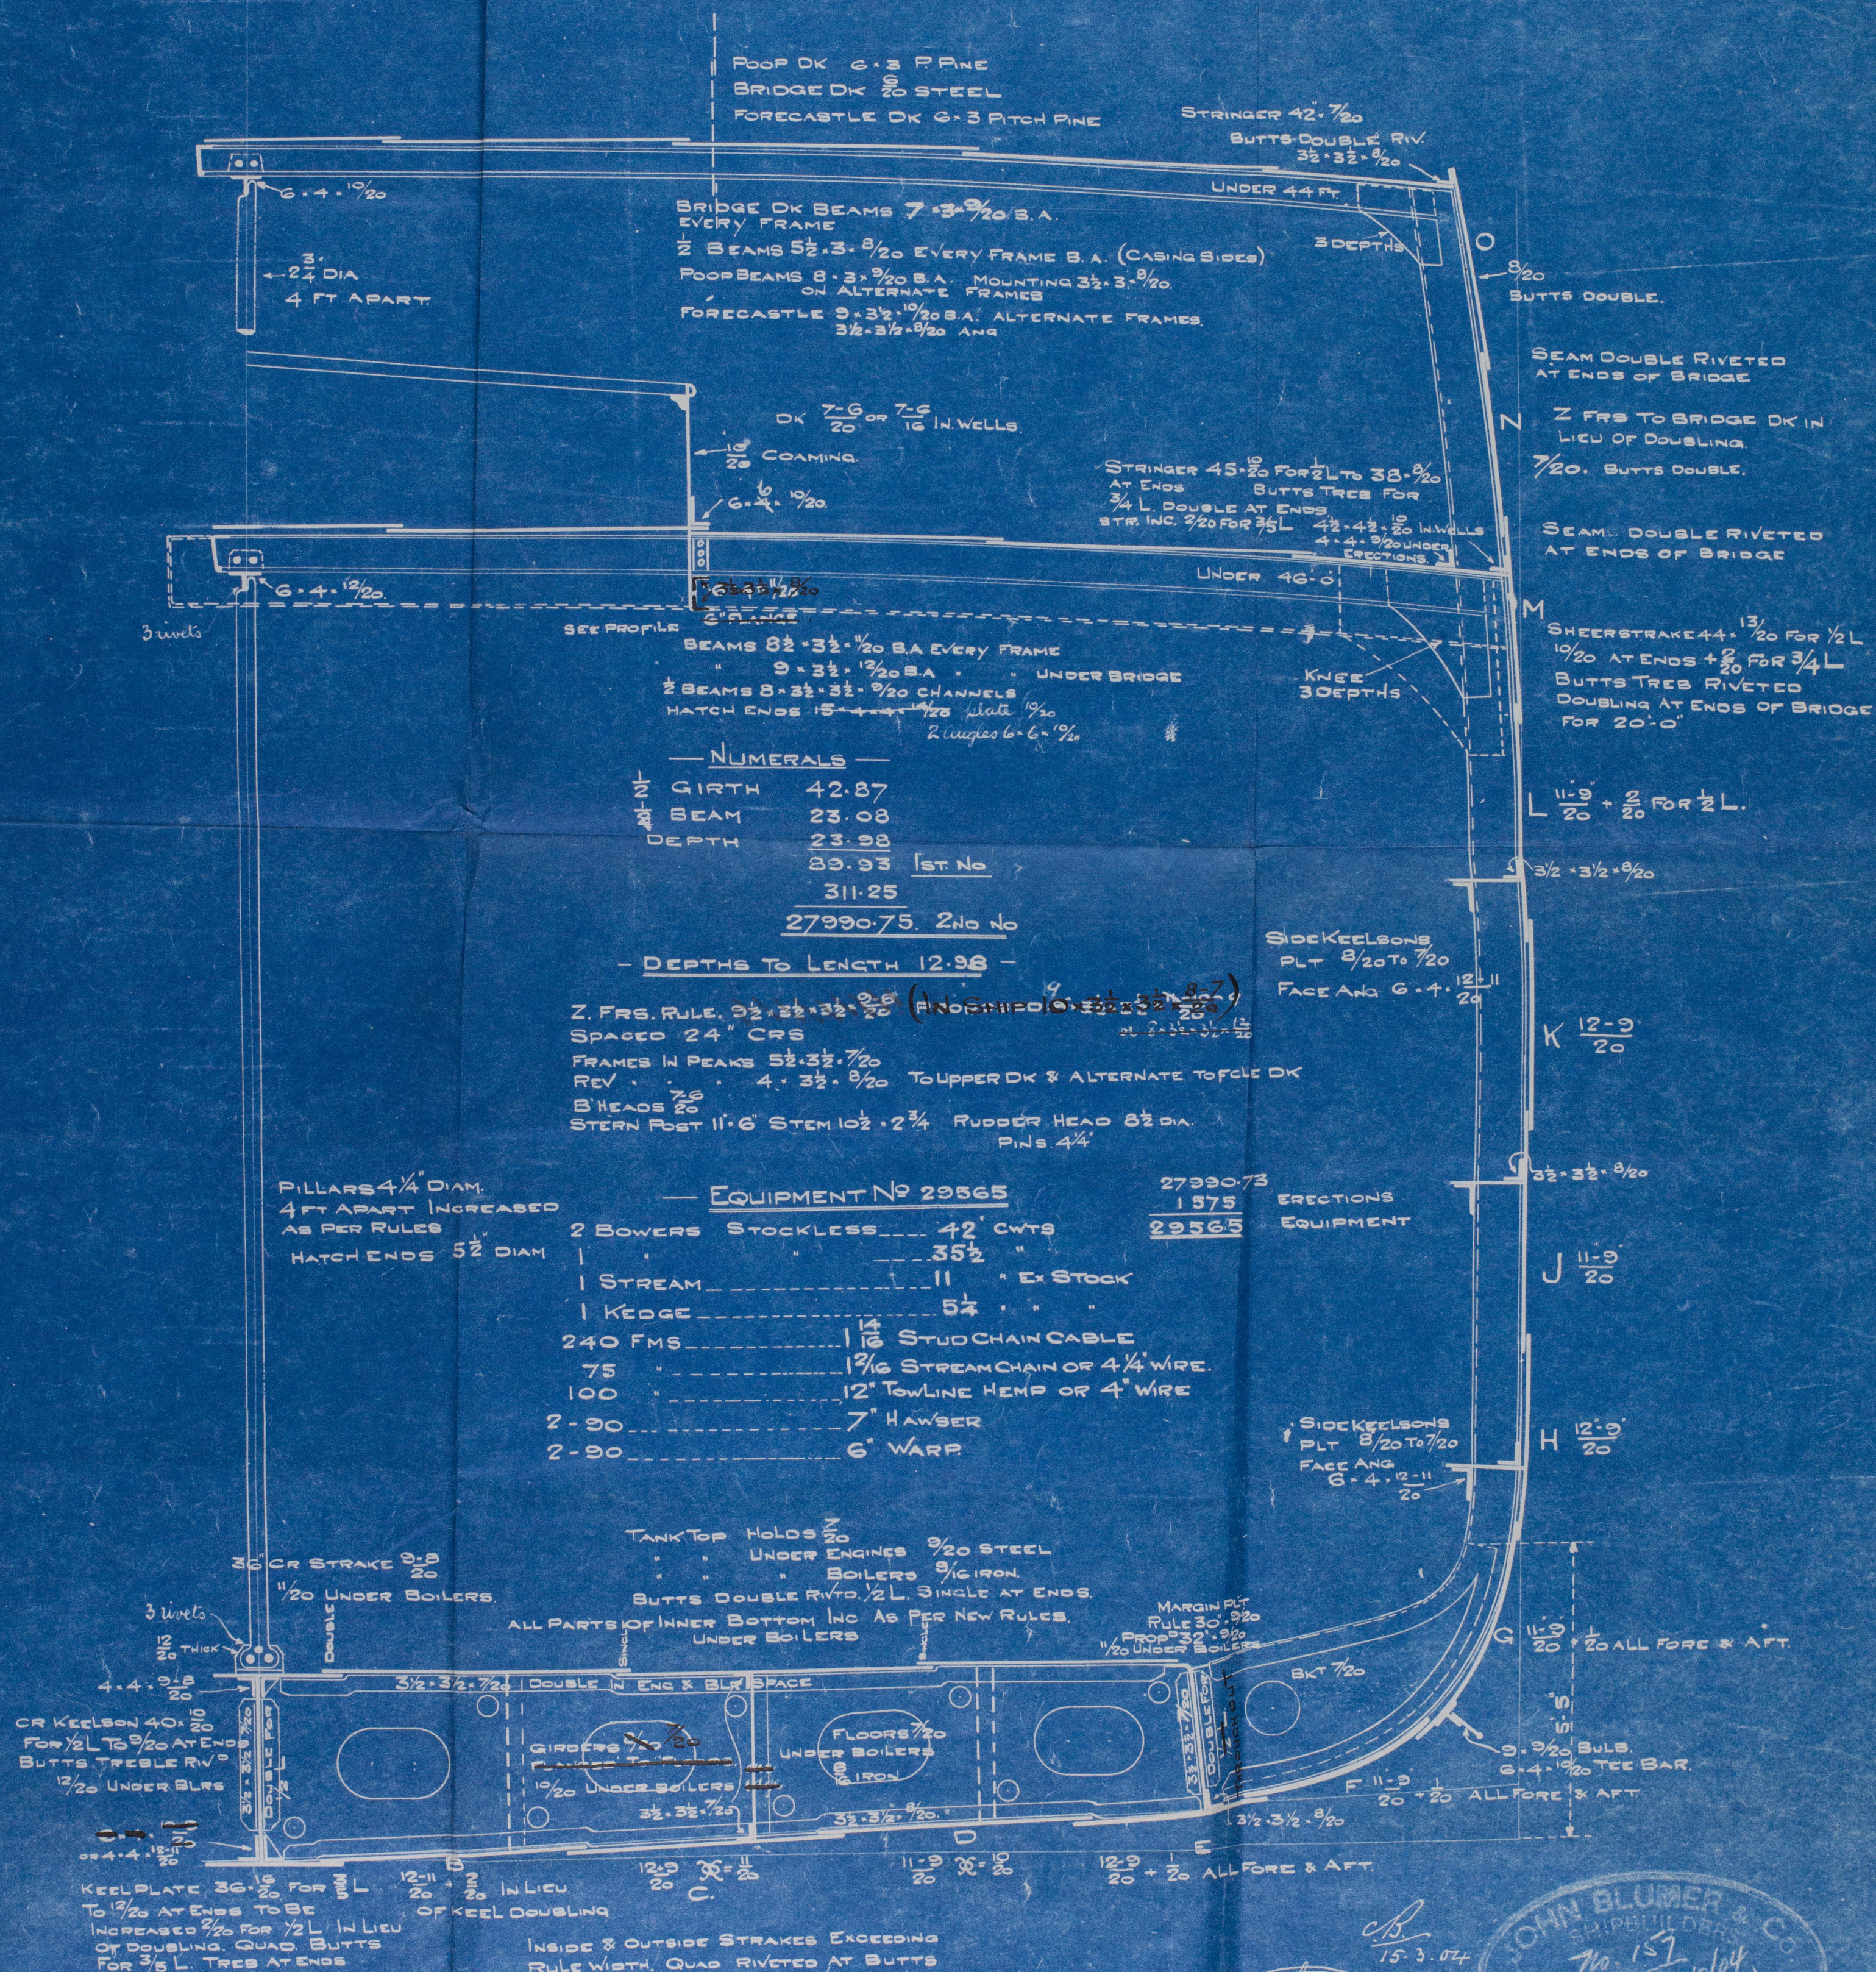

JOHN BLUMER & CO
SHIPSUILDERS
NORTH DOCK
25/05. SUNDERLAND

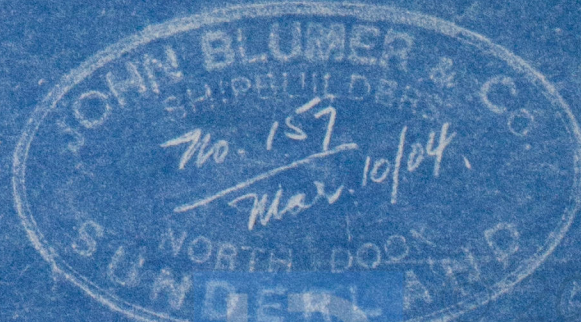

Messrs John Blumer & Co


20 182

N.S. "SPENNYMOOR"

Friendship Section
(as built)






Sld. F. E. No. 22273

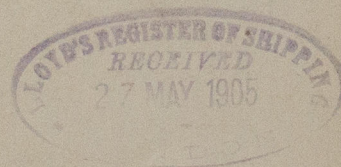

© 2020

Lloyd's Register
Foundation

W1251-0020

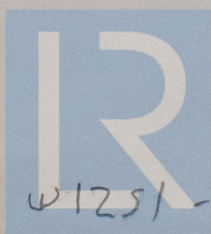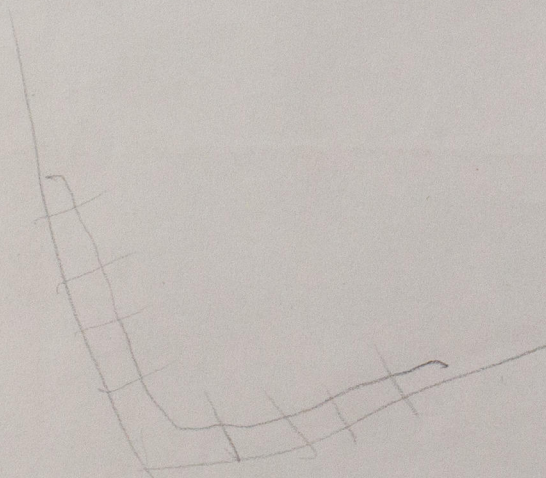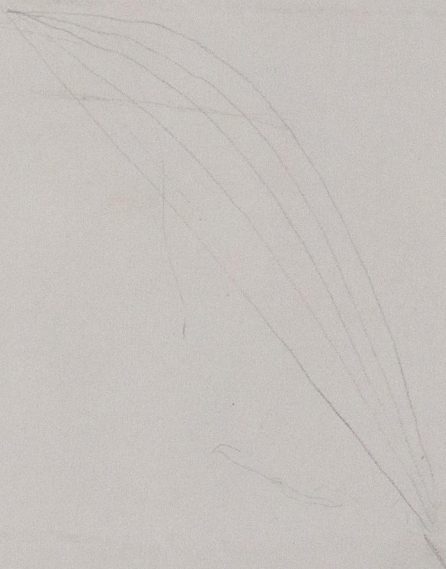

© 2020

Lloyd's Reef
Foundation