

MIDSHIP SECTION.

SCALE 1" = 1'-0"

TO CLASS LLOYDS "A" FOR TOWING PURPOSES.

PRINCIPAL DIMENSIONS.

LENGTH B.P. 70'-0" LENGTH O.A. 74'-6 1/2"

BREADTH MLD. 16'-0" DEPTH AT CENTRE 4'-5"

DEPTH " 4'-0"

PILLARS TO SURVEYORS SATISFACTION.


SHIP DRAWING No 2742.

~~ANCHORS, CHAINS & WARPS.~~

~~1 ANCHOR, 2 1/2 CWTs EX STOCK. 1 ANCHOR 1 CWT. EX STOCK.~~

~~60 FATHOMS, 5/8 STD LINK CHAIN. 90 FATHOMS 4 MANILLA.~~

~~16 FATHOMS, 1/5 THREAD TARRED HEAVING LINE.~~

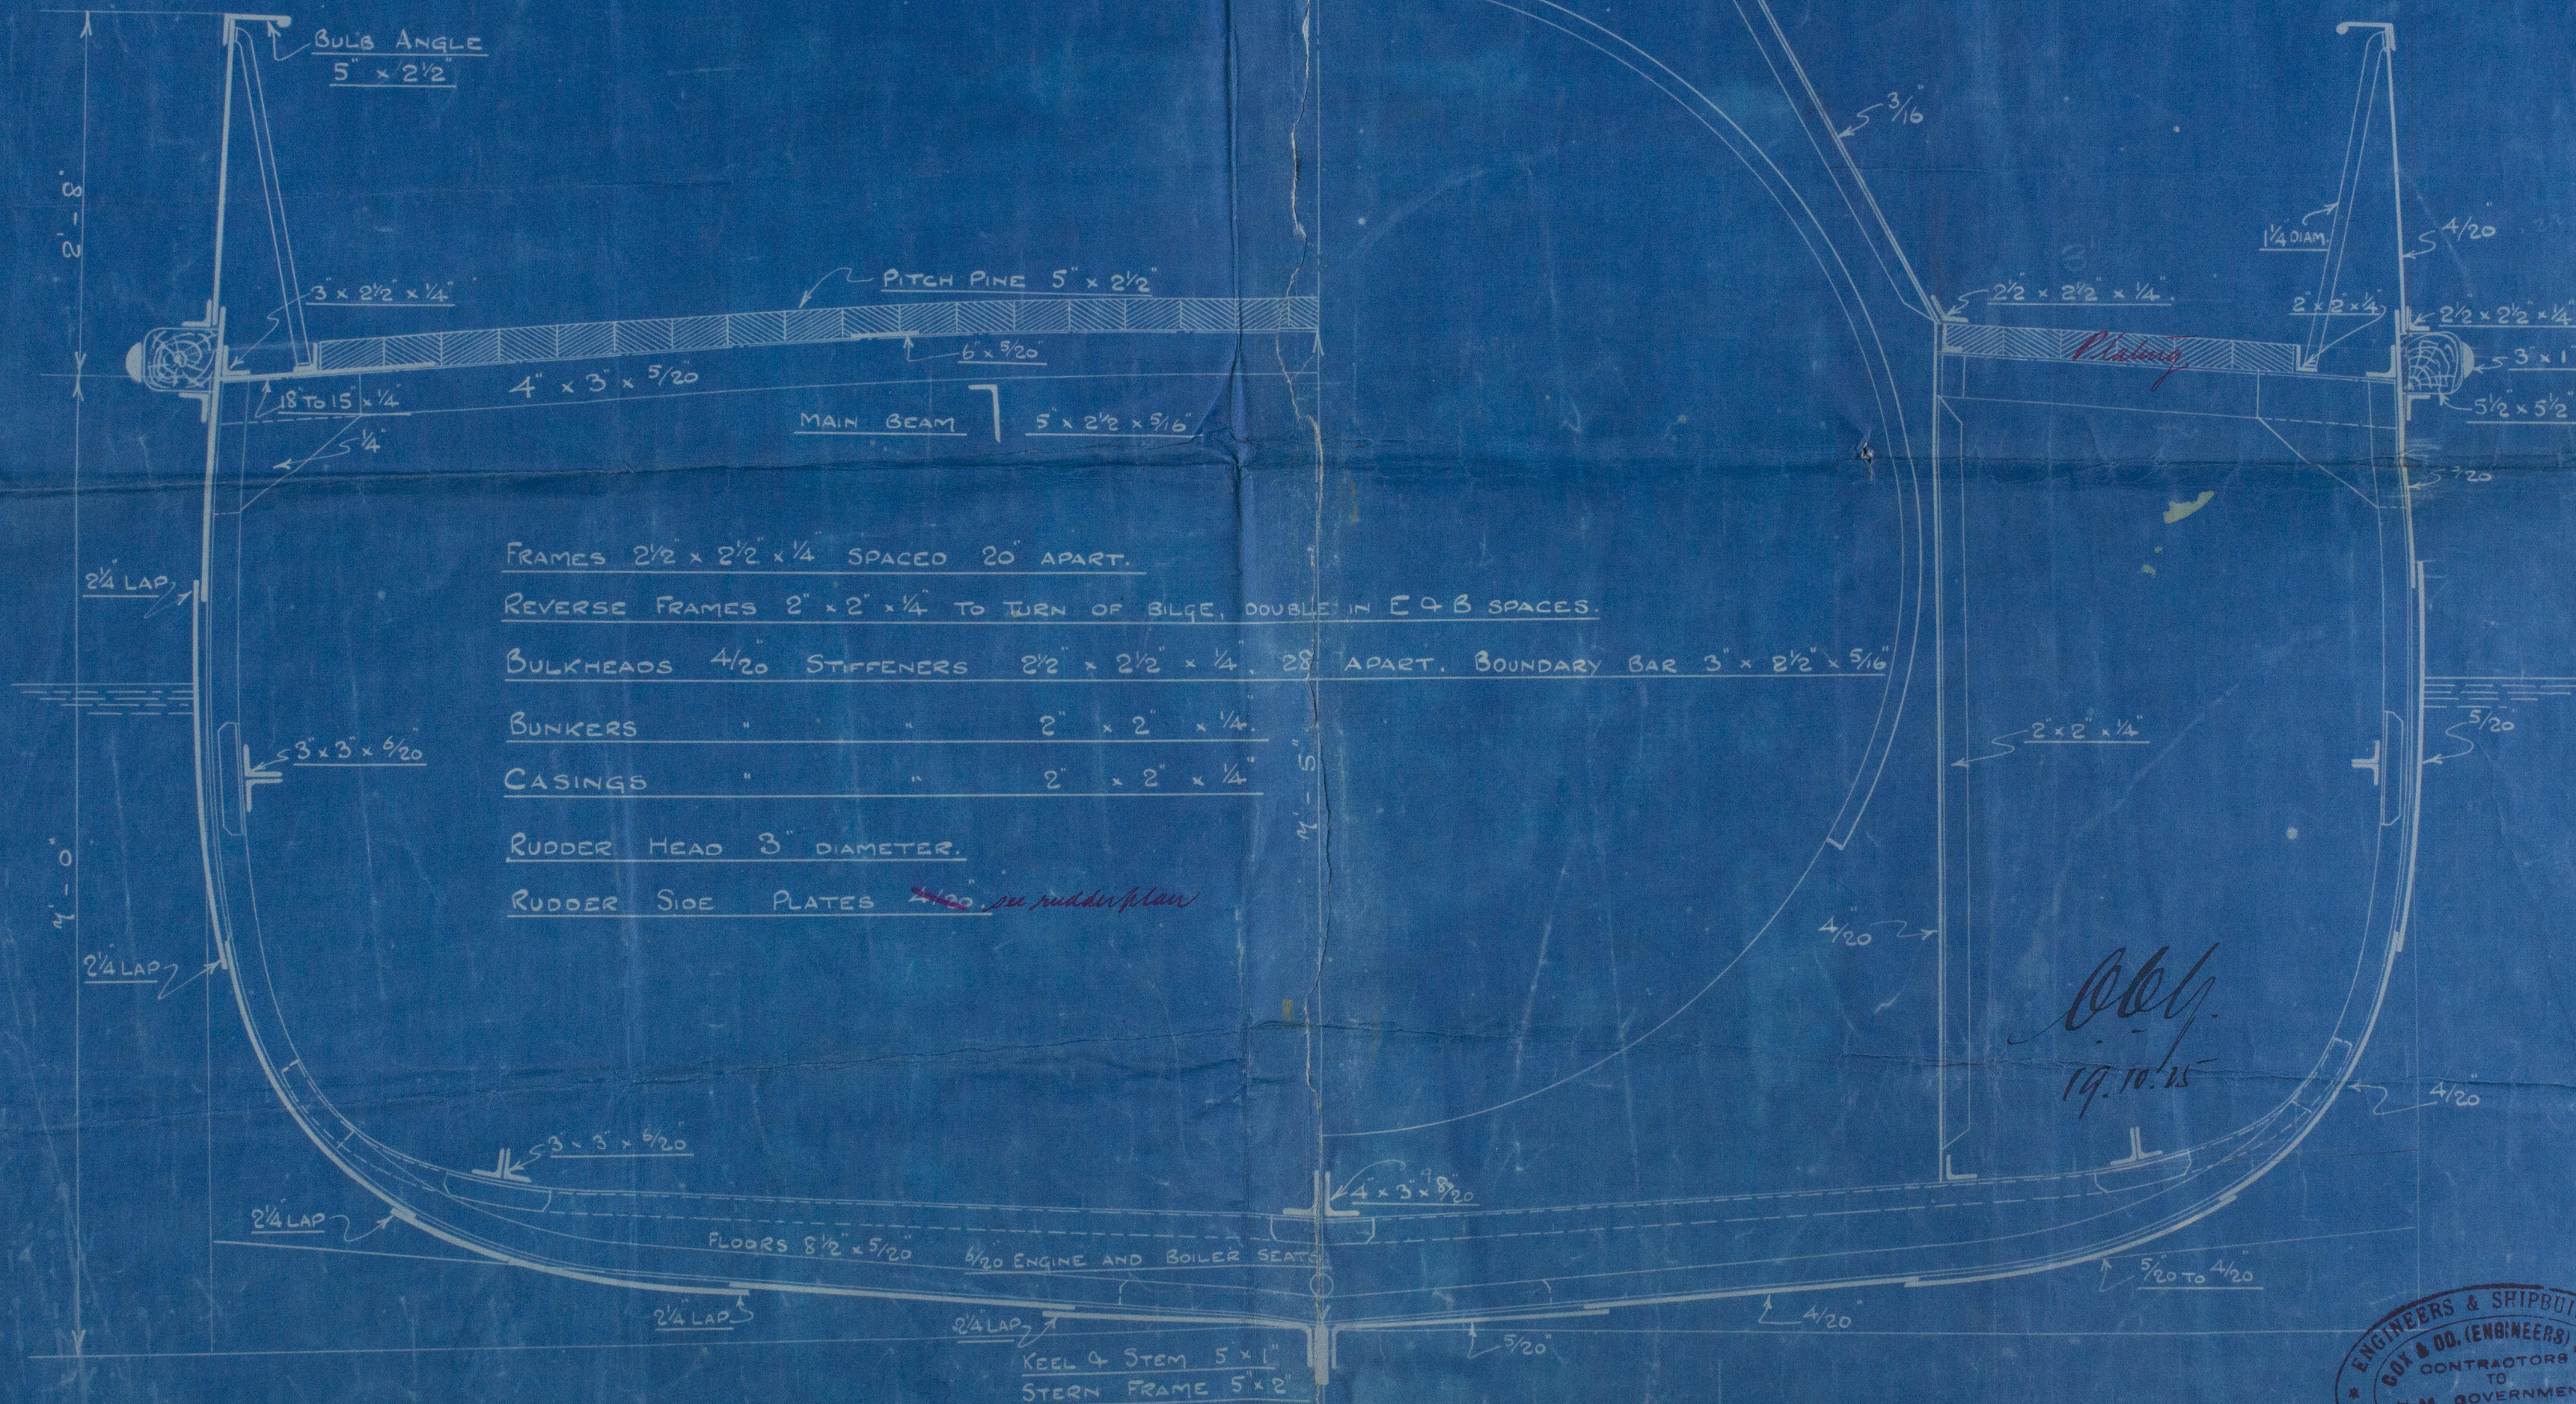

SHIP

No 190.




How's Rep
11251-0207

Box & Co's 190

5^u / 5^u Heydon

Midship Section

REMAINT

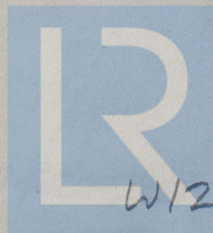

© 2020

Lloyd's Register
Foundation

W12 SF-0287