



PLAN No. 293
 FOR ENCLOSURE TO
Messrs. Lloyd's Register of Shipping
 FROM
 COCHRANE & SONS, LTD.
 SHIPBUILDERS, SELBY.
 DATE 27.7.33.

STEEL SCREW MOTOR TUG No 1114. PROFILE & DECK PLAN

70'0" B.P. x 17'0" MLD x 8'6" MLD.

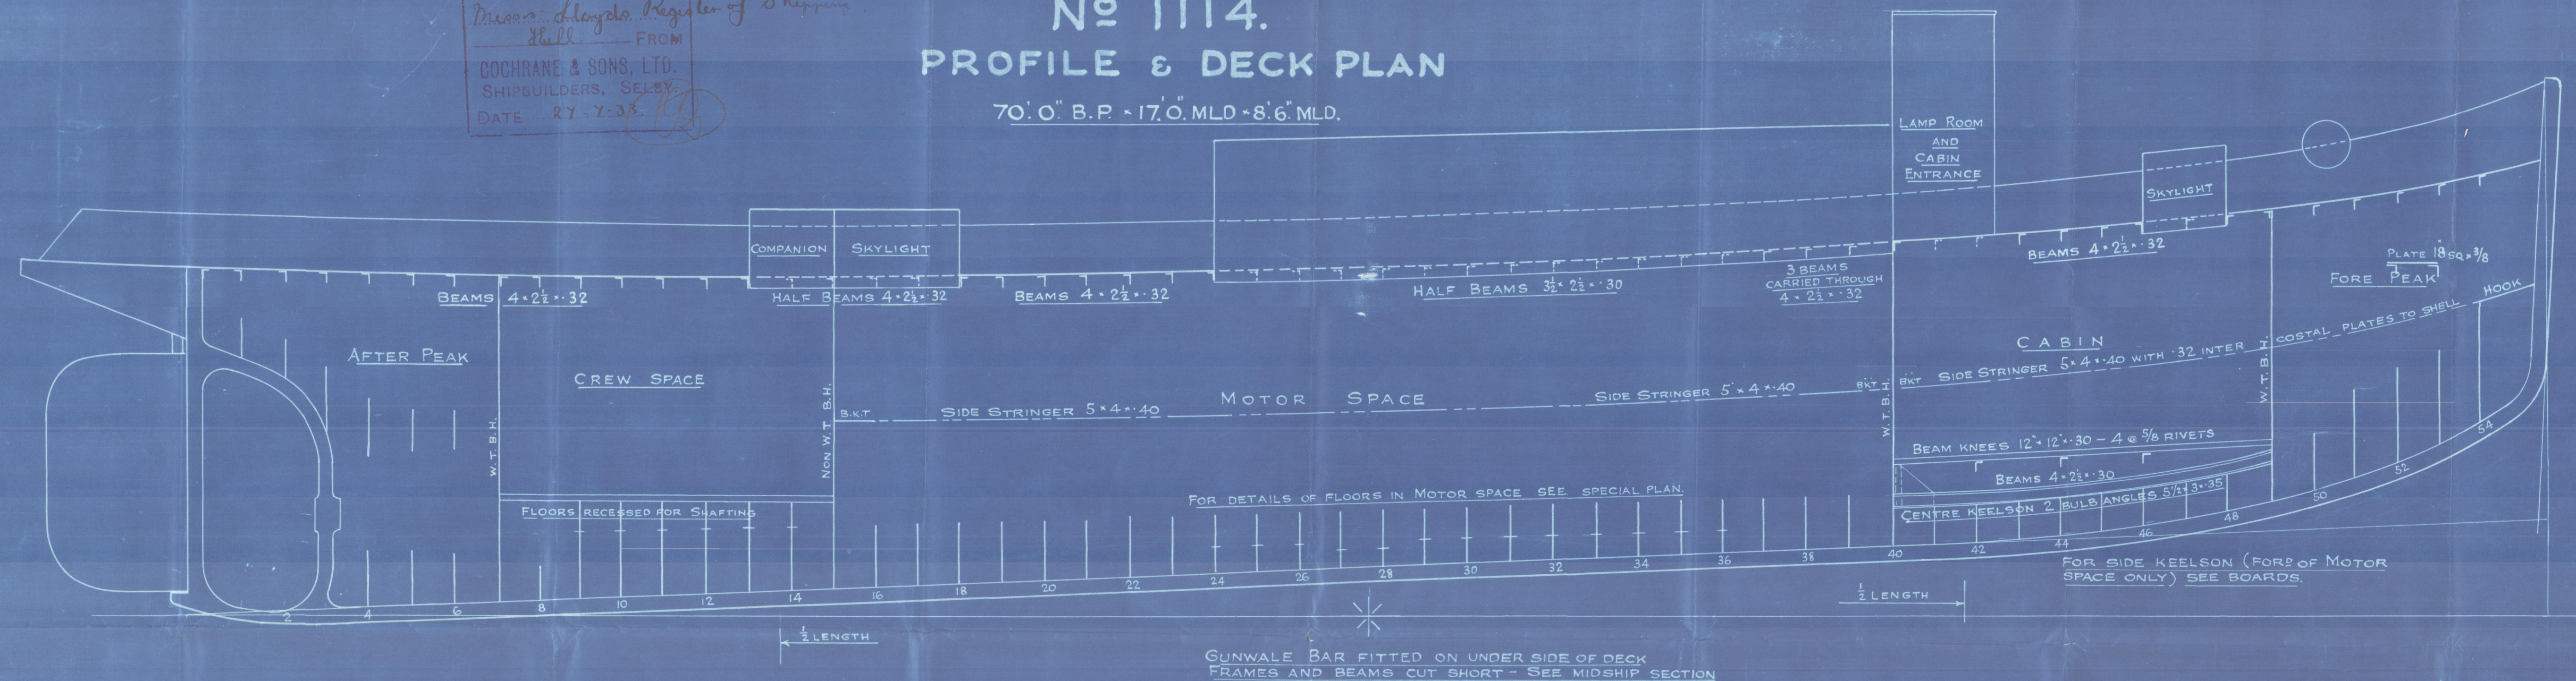

GUNWALE BAR FITTED ON UNDER SIDE OF DECK
 FRAMES AND BEAMS CUT SHORT - SEE MIDSHIP SECTION

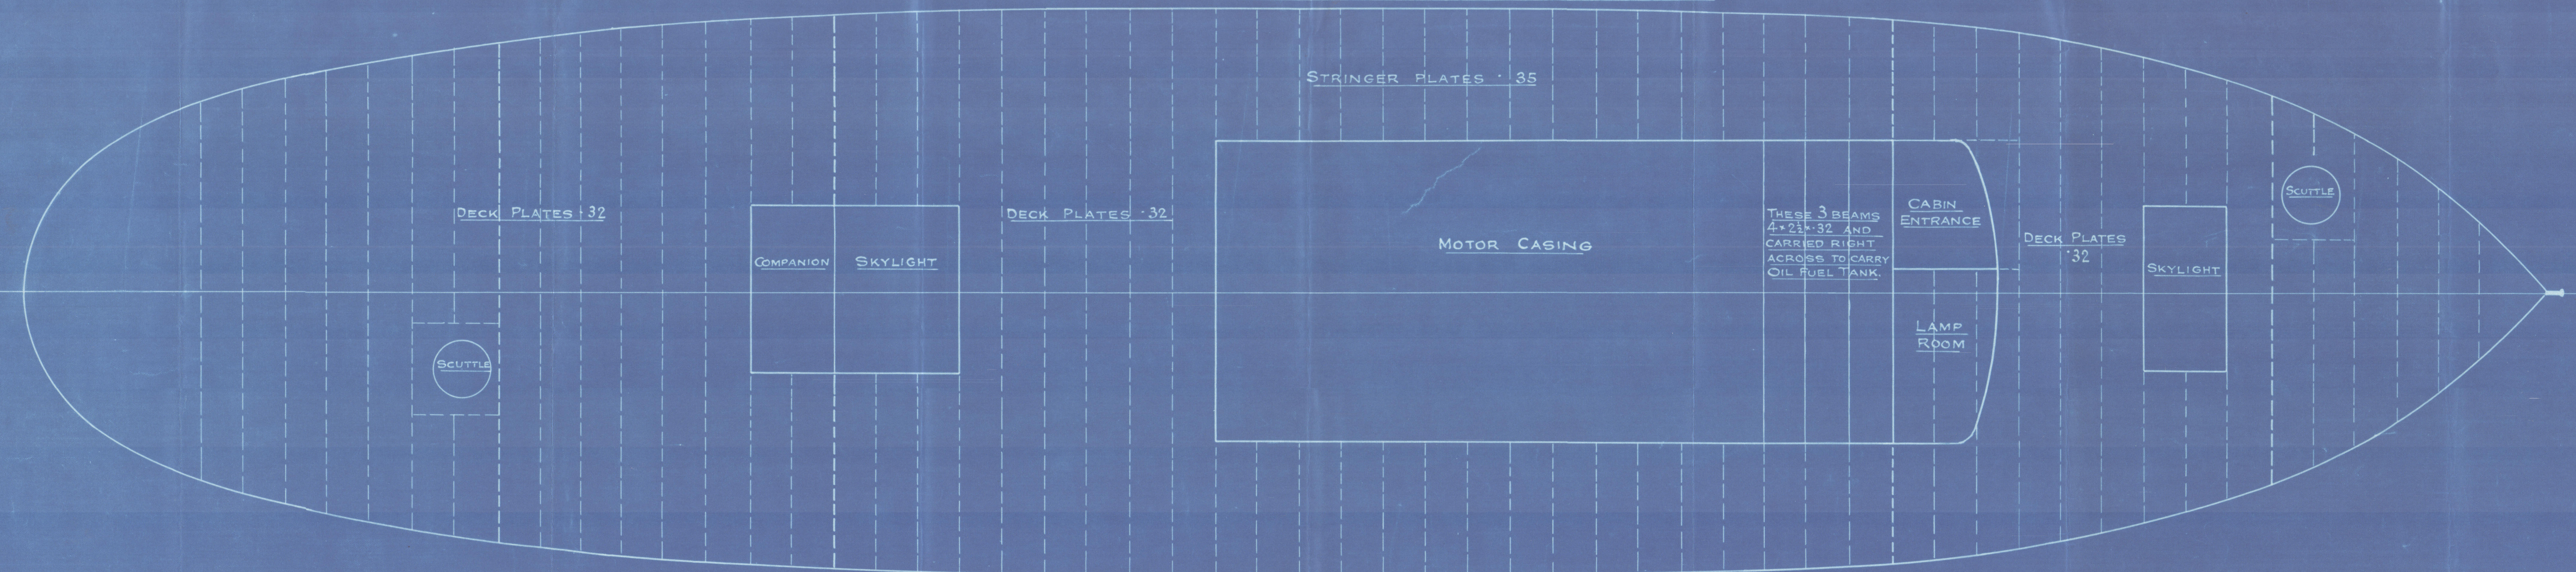

SCALE 3/8" INCH = 1 FOOT.

No 1114
Mason: Lloyd's
Profile of Shipping
Deck
(as built)
Cochrane & Sons Co

S.S. Alabama

WILL REPORT No. 43950



© 2020

Lloyd's Register
Foundation
W12 78-0100