

DIMENSIONS

LENGTH B.P.	325'-0"
BREADTH MLD.	44'-9"
BREADTH EXT.	48'-0"
DEPTH MLD.	24'-2 1/2"

S.S. N^o 191 1918 MIDSHIP SECTION.

CLASS 100. A1. LLOYDS


STEEL.



SCALE 1/2"=1 FT.



NUMERALS

B + D	Y1 98
L x (B + D)	23393
L/D TO MAIN DECK	13.41
L/D TO BRIDGE DECK	10.11
LONGITUDINAL No	23393
POOP 35' x 4' x 2 1/2"	184
BRIDGE 99' x 4' x 2 1/2"	589
FOUR 30' x 4' x 2 1/2"	182
MIDSHIP HOUSE 20' x 4' x 2 1/2"	82
ENDS HOUSE & CASING 63' x 4' x 2 1/2"	192
EQUIPMENT No	24622

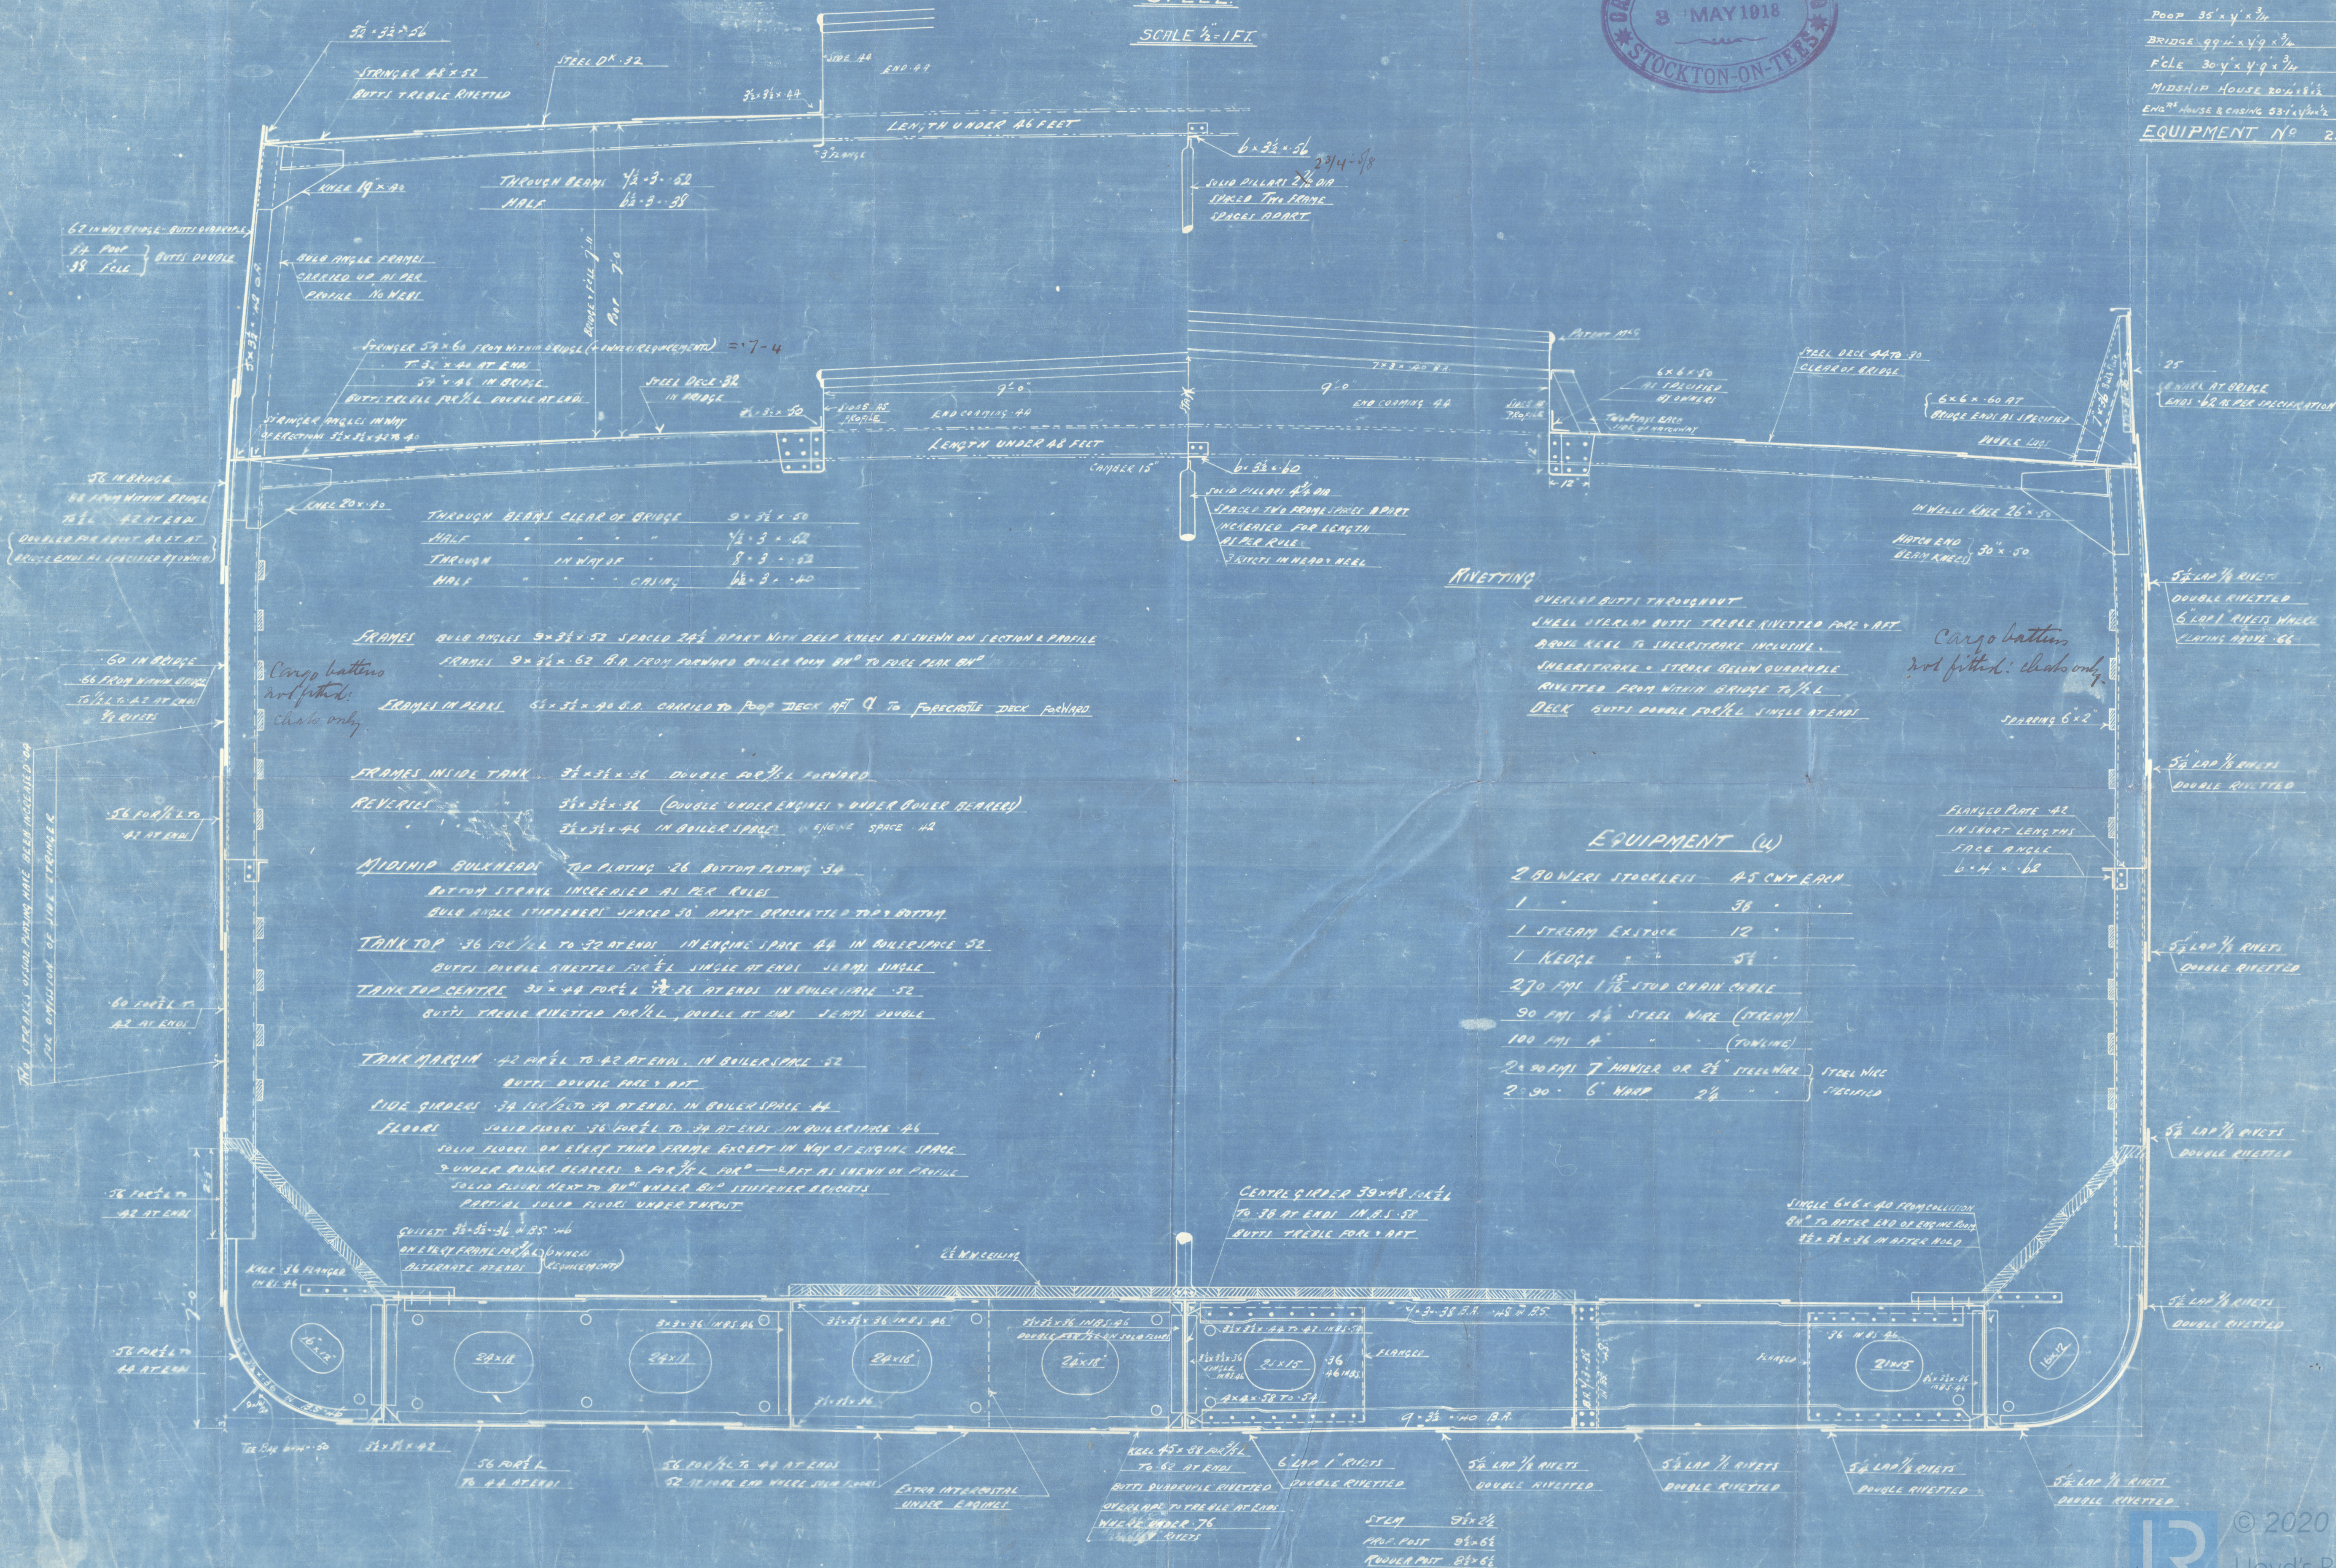

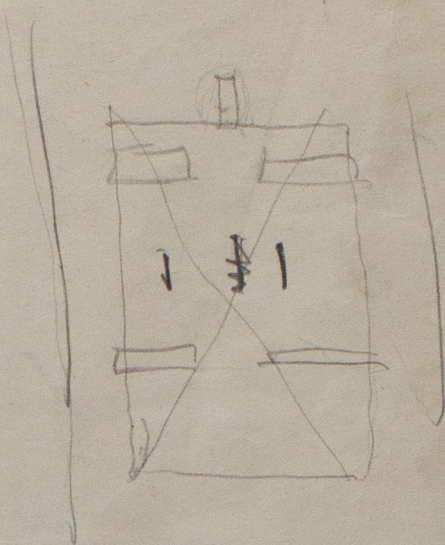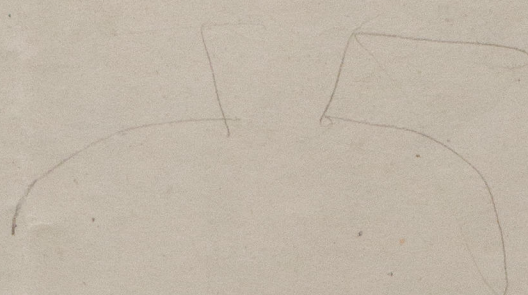

W1286-0177

Messrs Craig Taylor Hord
No 191.

Mid: Lie:
as built

S/S Maindy Lane
Mdb report No 10103.

RECEIVED
MAY 4 1918
LLOYD'S REGISTER
MIDDLEBOROUGH

RETAIN

W1286-0177



© 2020
Lloyd's Register
Foundation