


Nº 555 PROFILE & DECK PLAN

DIMENSIONS 136'8" B.P. x 23'6" x 13'0" H.L.


SCALE 1" = 1'

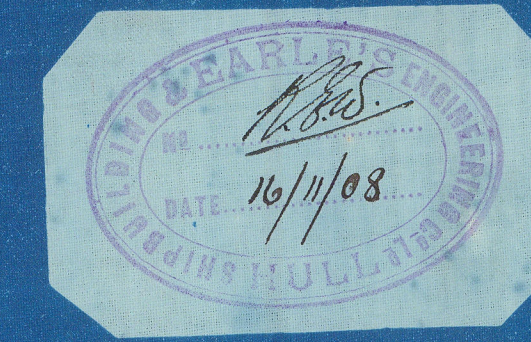

18.11.08.



The alterations in black show the positions of the bulkheads, beams, frames, etc. as amended.
asw.

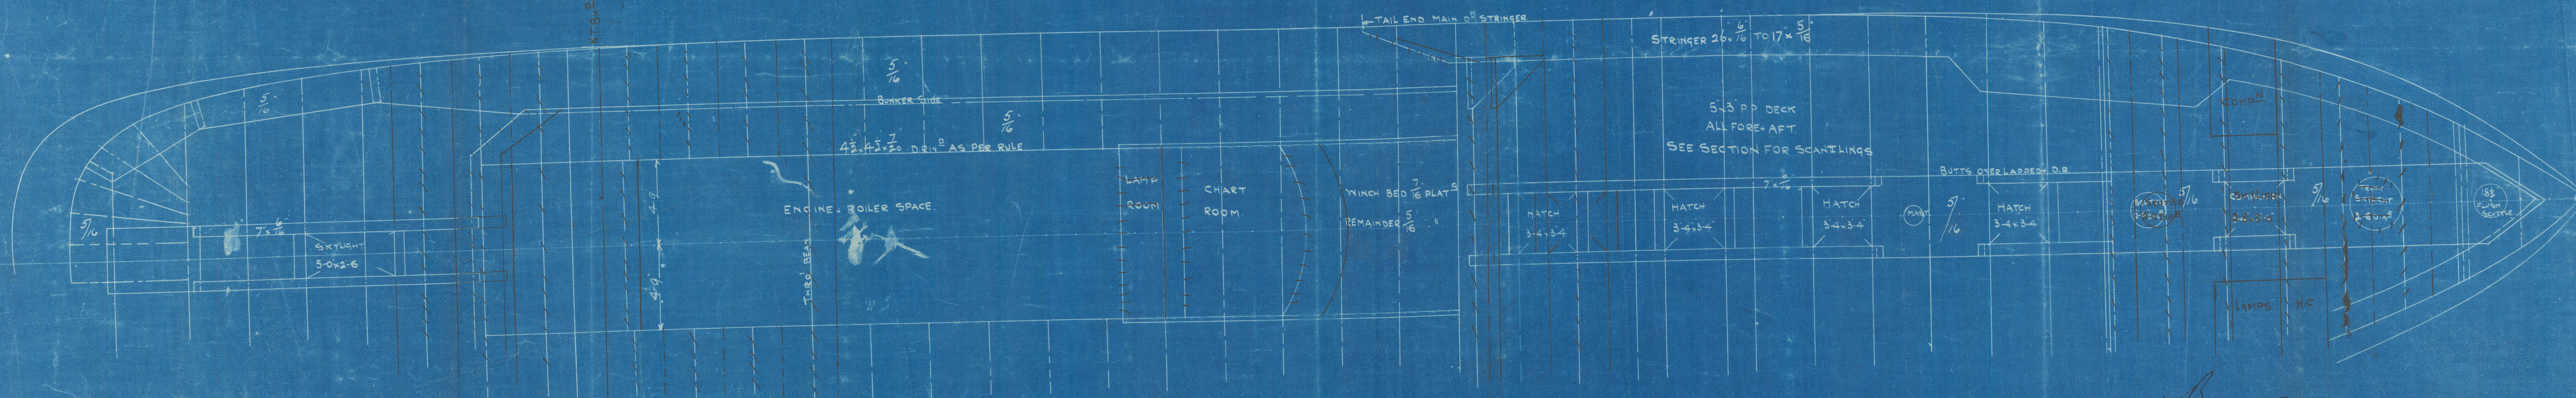

C.B.
18.11.08.

Earle's Co.

No 555.


Profile & Deck Plan.

of the ~~Yokohama~~ ~~Yokohama~~

Hull Report No 21. 113



RETAIN

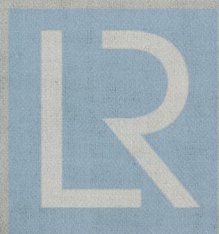

© 2021

Lloyd's Register
Foundation

W1297 - 0086