


— MIDSHIP SECTION —

— S. S. HOPPER BARGES Nos 354.5.6.7 —

— DIMENSIONS · 198'-0" × 32'-0" × 17'-6" MLD —

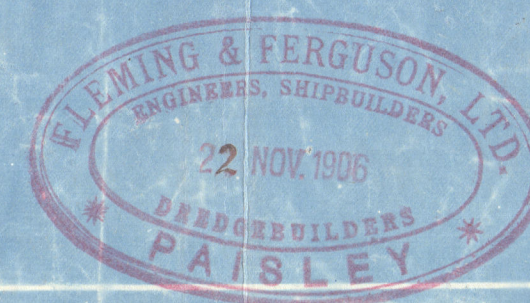

Midship Section
as built

"Thames" Conservancy
Hopper No 5.

Gls. npt. No. 24462

Stonehill

D 157



© 2020

Lloyd's Register
Foundation

W1306-0025