

LLOYDS	NUMERALS
LENGTH	363' 0"
BREADTH	52' 0"
DEPTH	24' 7 1/2"
+ 75' FOR B. 9 TWEEN DECK + 25' 5"	

B + D = 52' 0" + 25' 5" = 77' 5" TRANS. N°
L (B. D.) = 363' 0" + 77' 5" = 2812' 2" LONG. N°

DEPTH MOULDED TO UPPER DECK 24' 2"
C. D. B. (RULE 3' 9") 3' 9 1/2"
20' 11 1/2"

1/2 DIFF. RULE & ACTUAL TANK KNEE HEIGHT 3"
20' 8 3/4" + 2"

76 SHELTER DECK 10' 8 3/4"

EQUIPMENT	
LONG N°	2812
SHELTER TWEEN DECKS 363' 0" x 52' 0"	2178
FORECASTLE 62' 5' 0" x 34'	417
HOUSES 150' x 7' 7 1/2"	GIG
	31343' x

1 BOWER ANCHOR	50 1/2 CWTs. STOCKLESS
1 BOWER ANCHOR	55 1/2 CWTs. STOCKLESS
1 BOWER ANCHOR	48 CWTs. STOCKLESS
1 STREAM ANCHOR	15 CWTs. EX. STOCK
1 KEDGE ANCHOR	6 1/2 CWTs. EX. STOCK
270 FATHOMS	2 1/2 STD. CHAIN CABLE
90 FATHOMS	4 1/2 STEEL WIRE STREAM
120 FATHOMS	4 1/2 STEEL WIRE TOWLINE
4 x 90 FATHOMS	7 HAWSEYS AND WARPS

S.S. N° 25. S.S. PERSIANA


MIDSHIP SECTION.

SCALE 1/2 INCH = ONE FOOT

DIMENSIONS: 363' 0" B.P. x 52' 2 1/2" EX. x 33' 6" M.P. TO SHELTER DECK

CLASS LLOYDS *100 A.I. SHELTER DECK WITH FREEBOARD

FORECASTLE:
FRAMES SEE PROFILE OR BELOW
BEAMS SEE PROFILE
SIDE PLATING 40" BUTTS DOUBLE
STRINGER PLATE 34" BUTTS DOUBLE
DECK PLATING 34" UNDER WINDLASS 40" BUTTS SINGLE
STRINGER ANGLE 3 1/2" x 3 1/2" x 34"
PILLARS 3" DIA. 1" ROW
ADDITIONAL STRENGTHENING UNDER WINDLASS

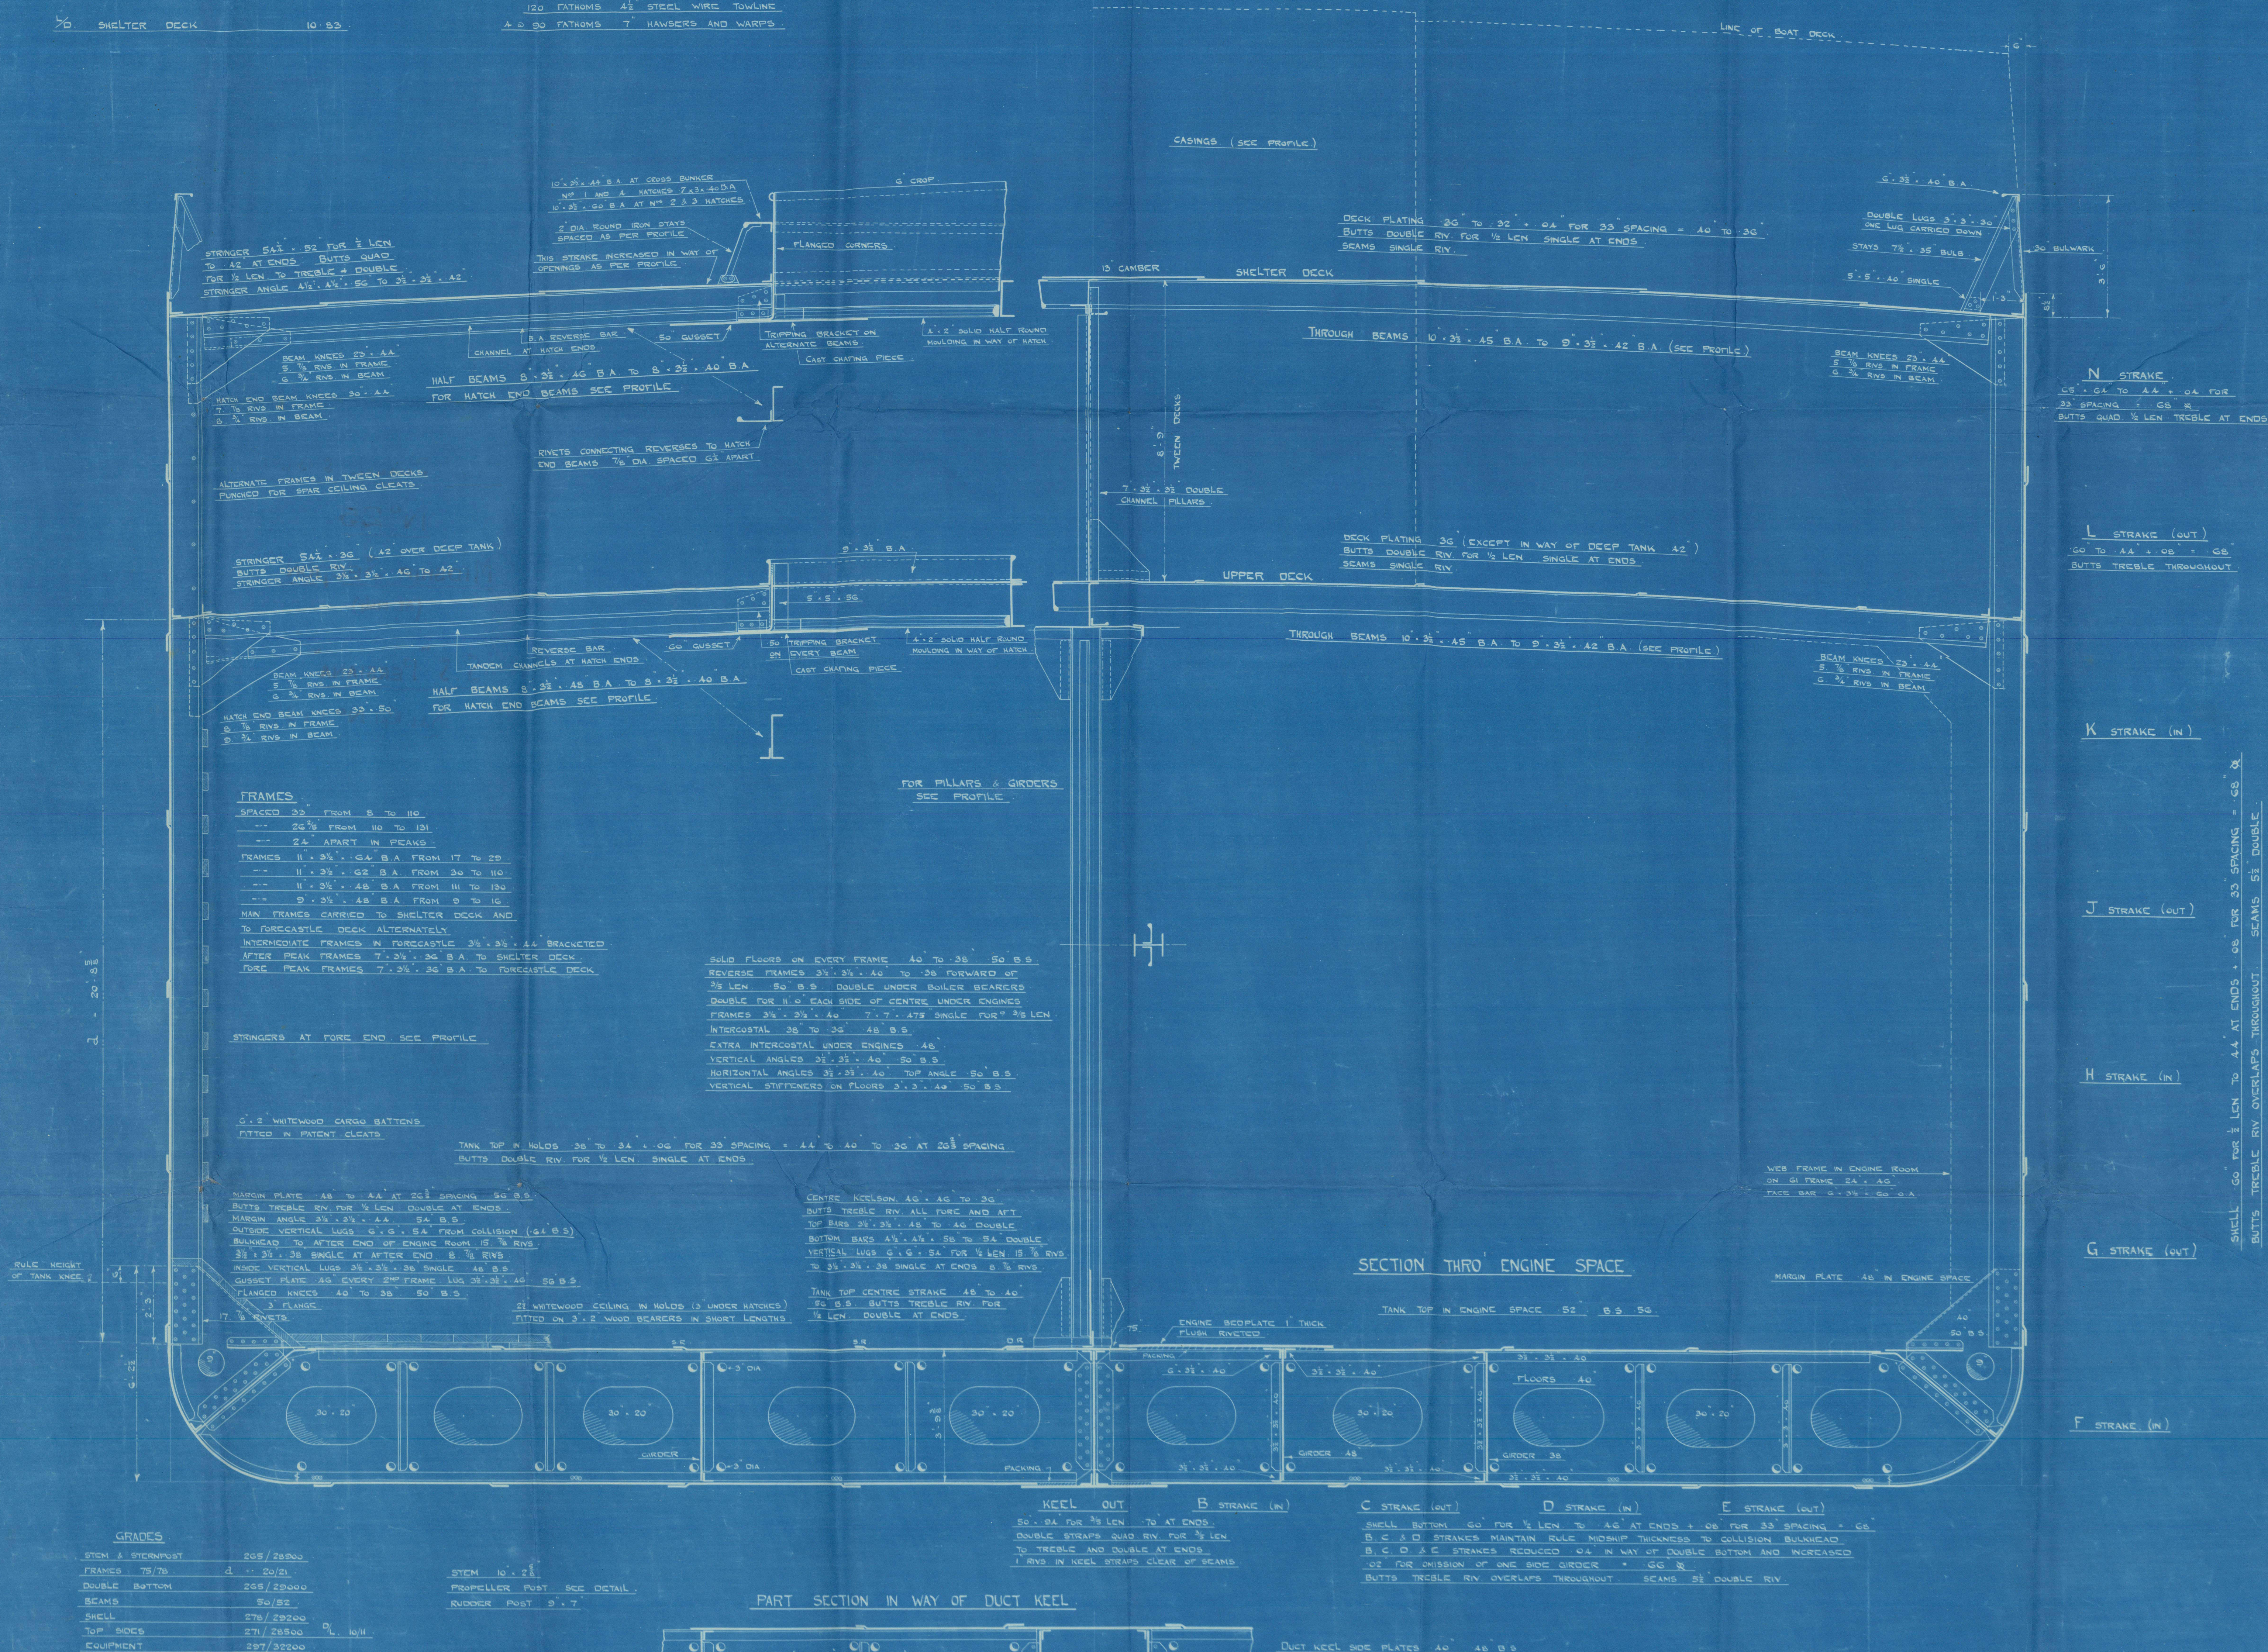

5.2009

Mess^r. Furner. S. B. 6^o 2^o

N^o 25

MIDSHIP SECTION

(As built)

S. S. "PERSIANA"

Ind. Rpt. N^o 11274



© 2021

Lloyd's Register
Foundation

W1357-0090