

N^o 192.

MIDSHIP SECTION

DIMNS: 116'-0" BP x 25'-5" x 9'-9" MD

SCALE: 1/2" = 1' ft

TO CLASS 100A1 AT LLOYDS.


EQUIPMENT No.

L(B-D) = 4078-0
 QURT DK. 40-3-25 = 130-0
 POOP DK. 34-7-75 = 178-0
 FC/LE DK. 78-2
 4464-2

L-D = 1131-0
 L(B-D) = 4078-0
 L/D = 11-9


EQUIPMENT.

1 BOWER ANCHOR 7 1/4 CWT. STOCKLESS.
 1 " " 7 " " "
 1 STREAM " 2 1/4 " EX. STOCK.
 165 FMS 7/8" STAD LINK CABLE.
 45 " 2 1/4" STEEL WIRE ROPE.
 75 " 2 1/4" Do.
 90 " 1 3/4" Do.

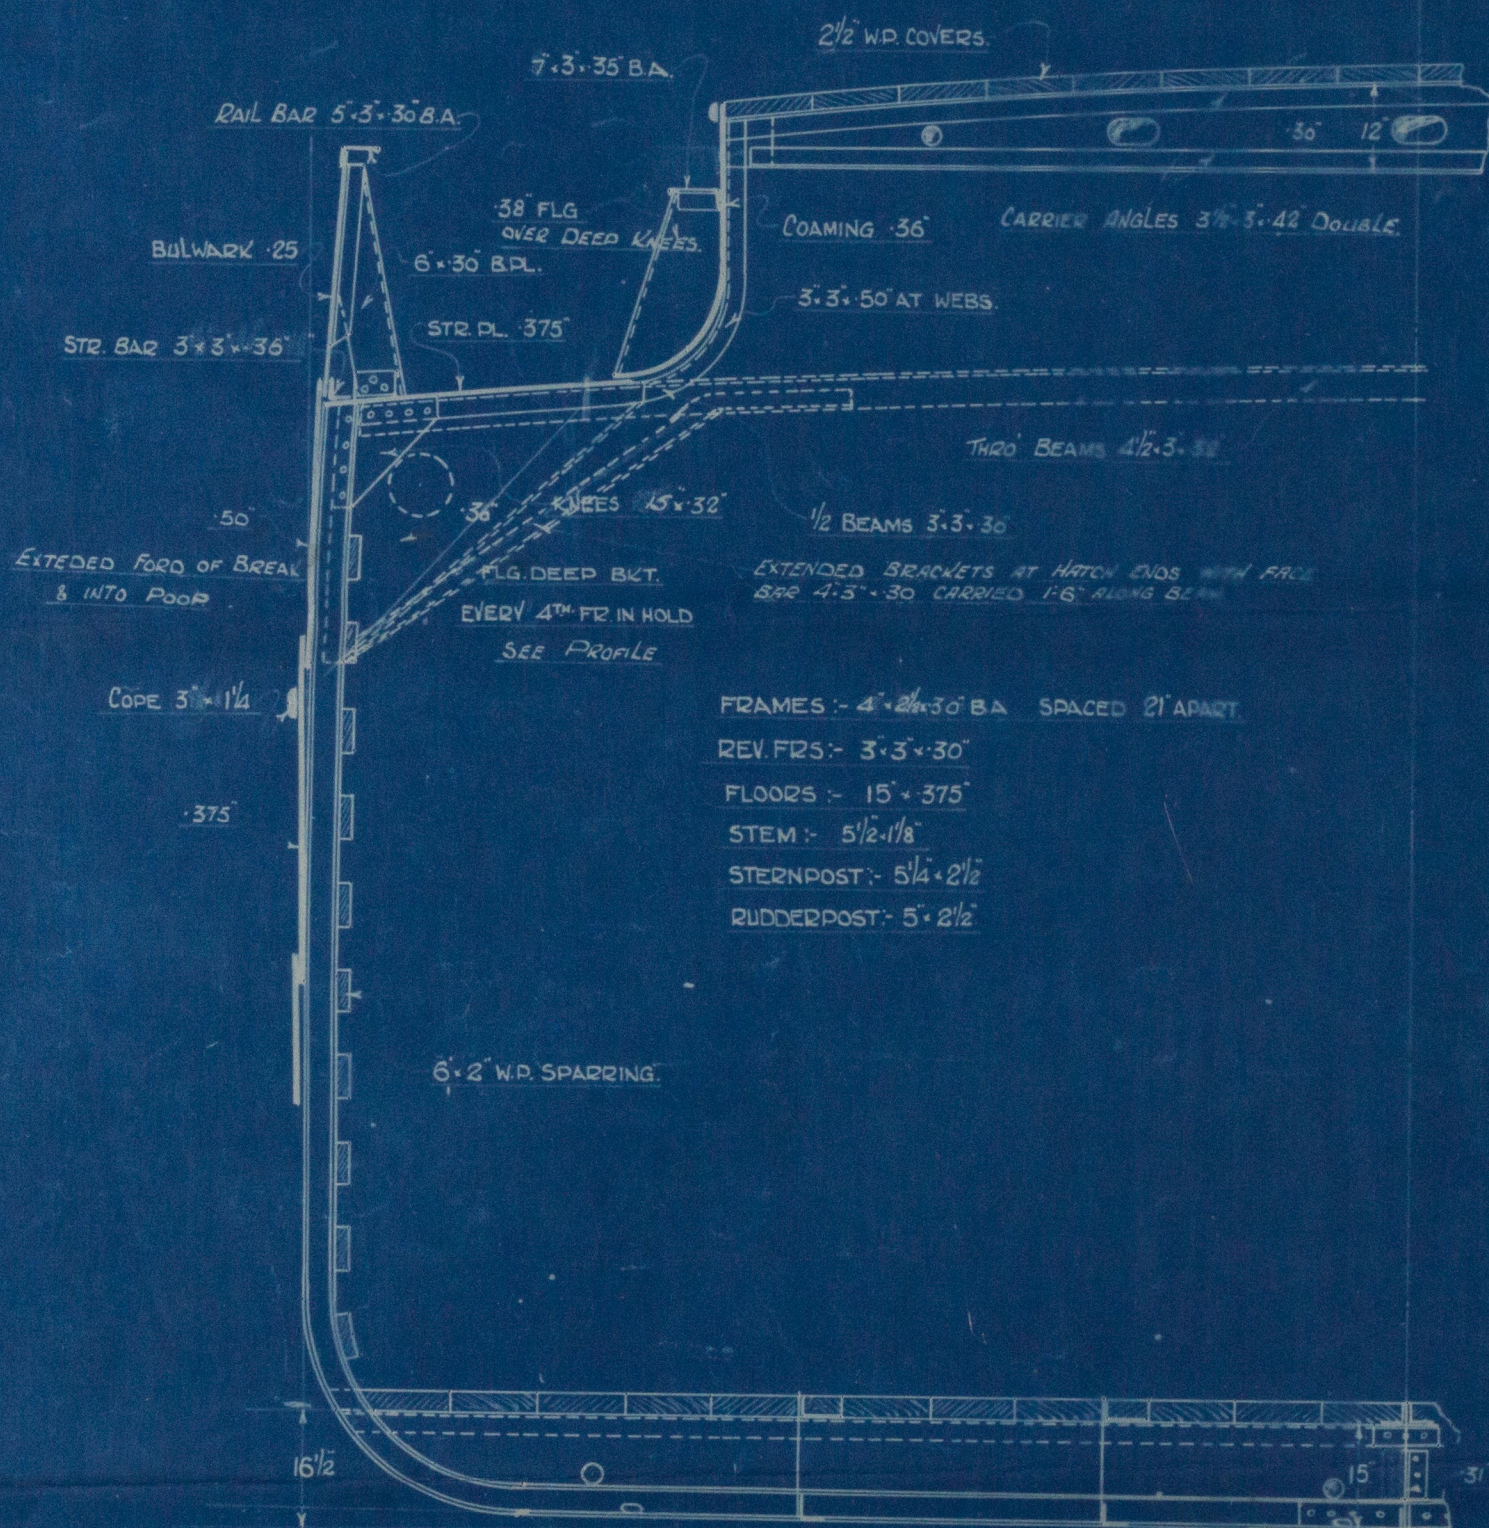

RIVETTING.

SHELL BUTTS & SEAMS D.R. THROUGHOUT.
 STR. BUTTS D.R. THROUGHOUT.
 KEEL BUTTS T.R. TO D.R.
 SHEERSTRAKE BUTTS D.R. EXCEPT AT BREAK OF Q.R. DK. WHERE T.R.
 RIVETS 3/4" DIA. THROUGHOUT.

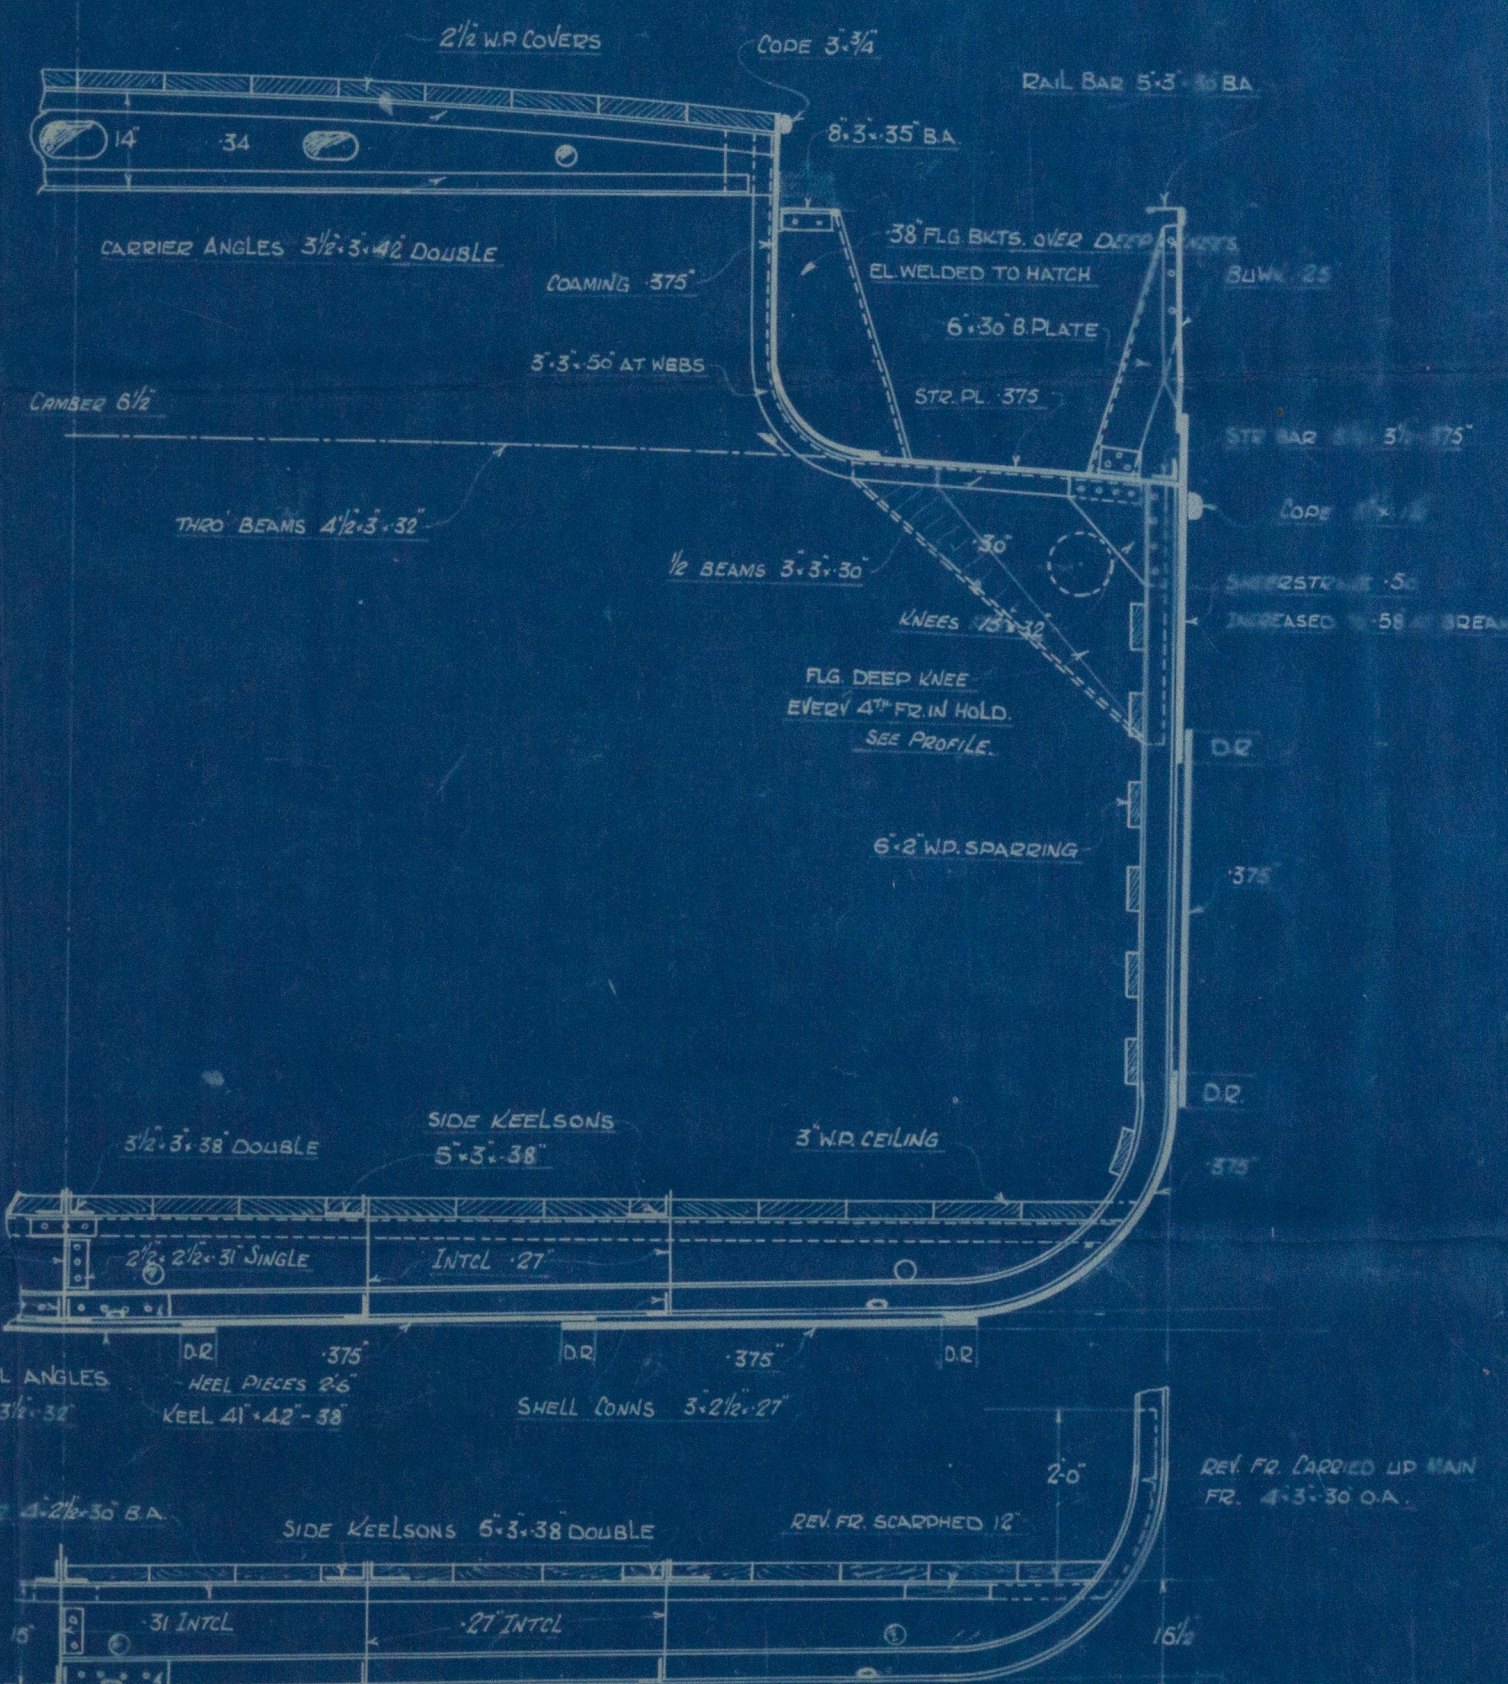

SECTION THRO' FLOORS.

FROM BREAK BND. TO FORE PEAK BND.



174
 1/2/35

GEO BROWN & CO

Nº 192

M. V. ARDUITY

MIDSHIP SECTION

As BUILT

GREENOCK 1ST ENTRY

REPORT Nº 19991.



© 2020

Lloyd's Register
Foundation

W144-0020