
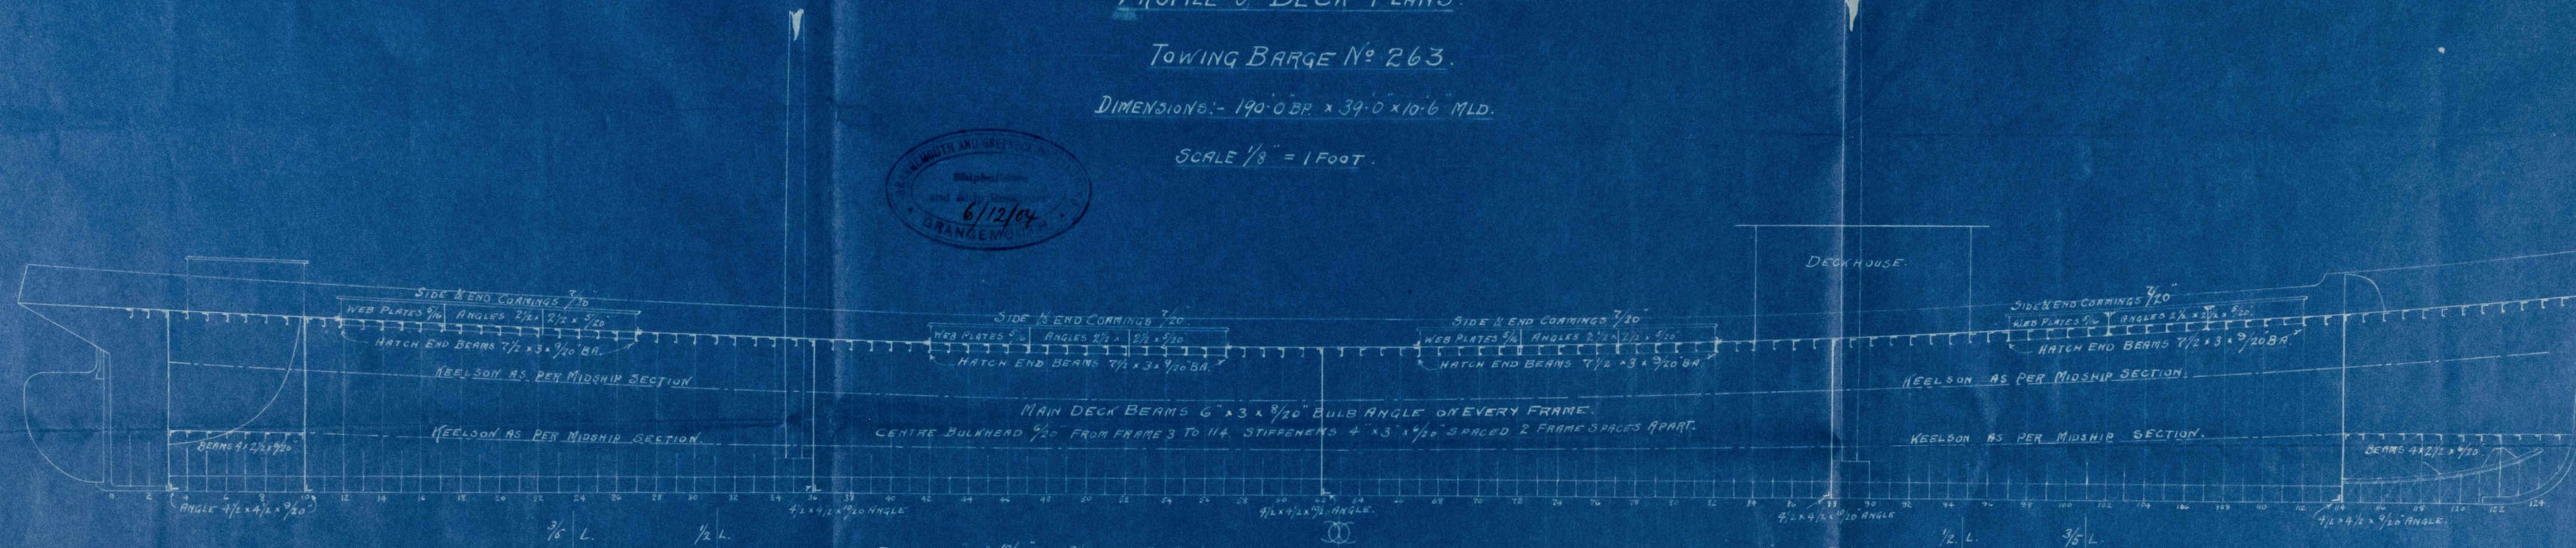


# PROFILE & DECK PLANS.

TOWING BARGE No 263.

DIMENSIONS:- 190' O.B.P. x 39' 0" x 10' 6" MLD.


SCALE 1/8" = 1 FOOT.

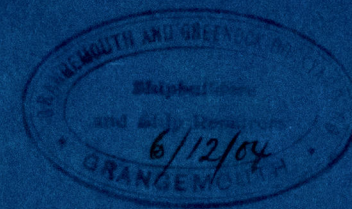

FRAMES 5" x 3" x 10/20 FOR 3/5 L. TO 5" x 3" x 9/20 ANGLE, SPACED 18" APART. REVERSE FRAMES ACROSS TOP OF FLOORS 2 1/2" x 2 1/2" x 5/20.

MAIN DECK STRINGER 78" x 3/8" FOR 1/2 LEN. TO 22" x 5/16" AT ENDS.

ALL DECK BEAMS TO BE FLUSH, SINGLE RIVETED STRAPS ALL FORE & AFT.

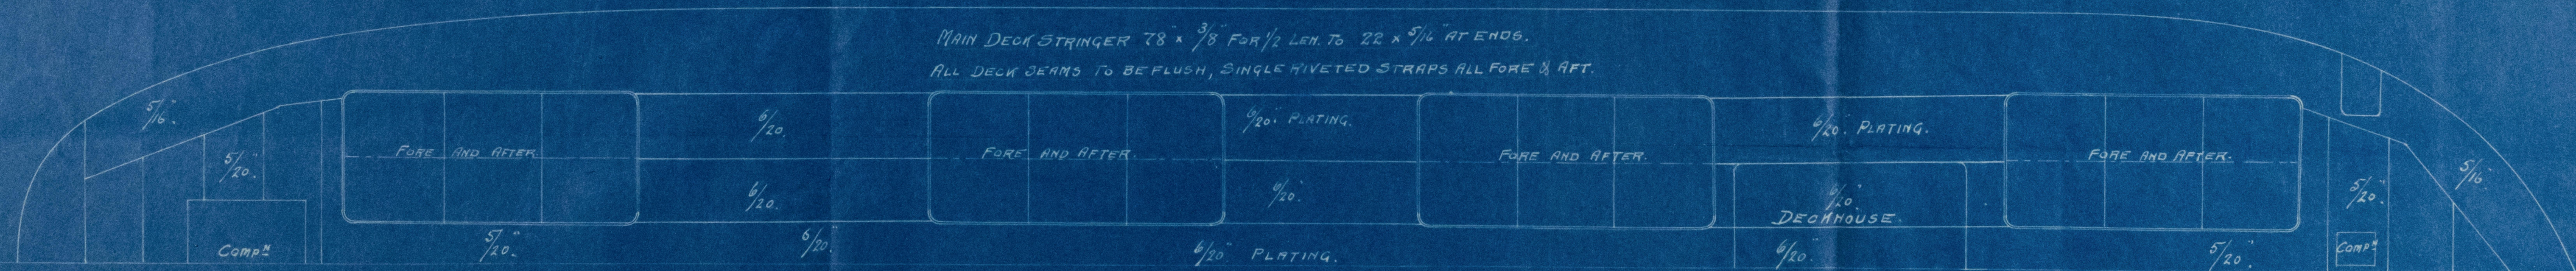



N<sup>o</sup> 263

"FORESTAL"

Profile & Deck plan

Mess. Grangemore

& Grangemore & Co

As built-

Lith. Rept N<sup>o</sup> 10926.

RETAIN



© 2021

Lloyd's Register  
Foundation

W1449-0030