




POOP DECK

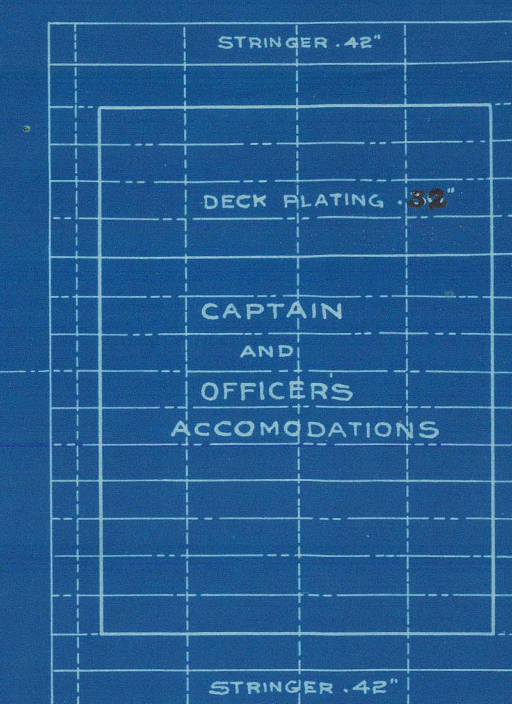


BRIDGE DECK

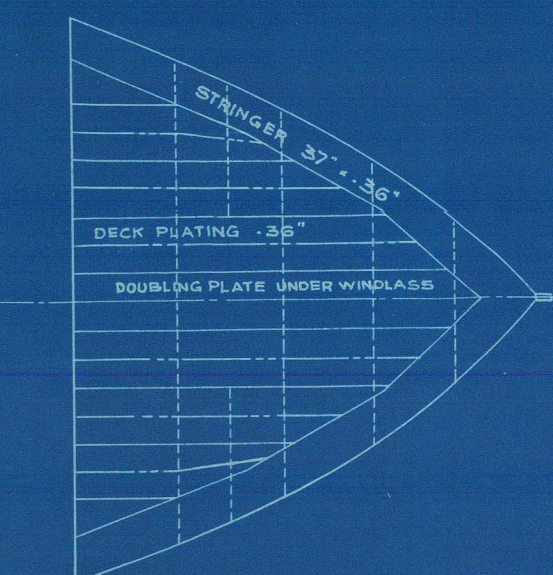


FORECASTLE DECK

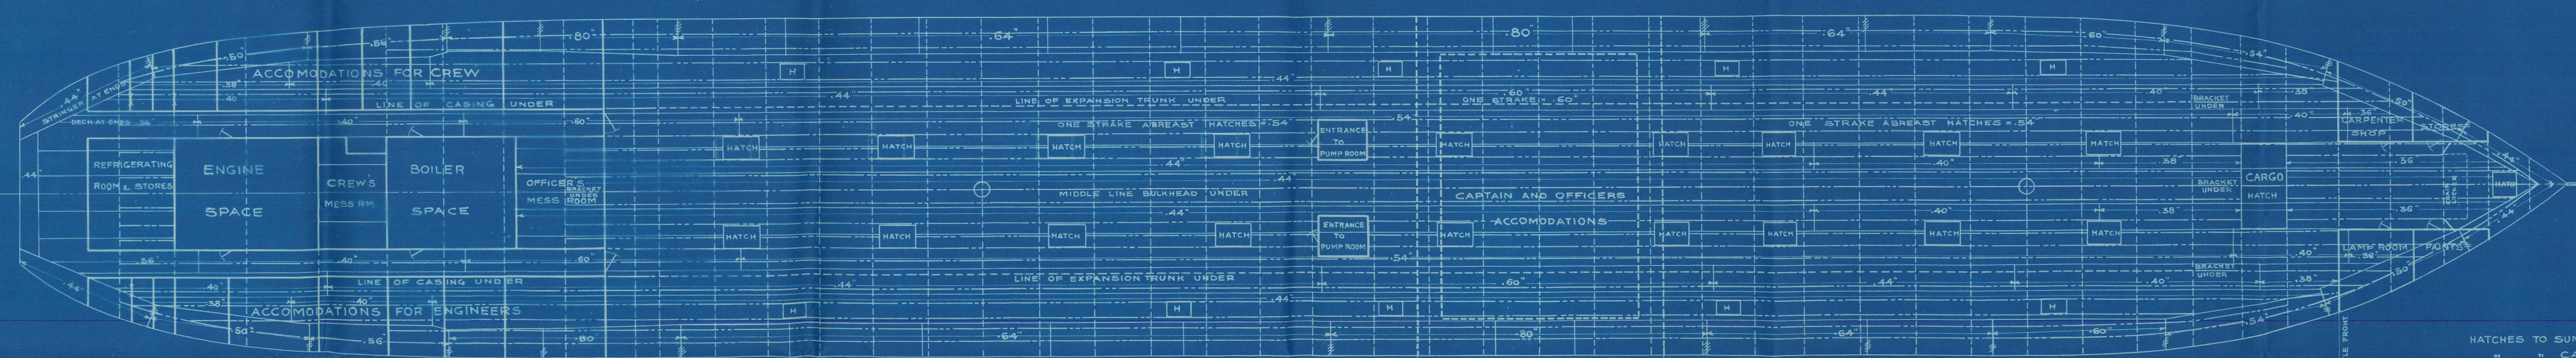

UPPER DECK

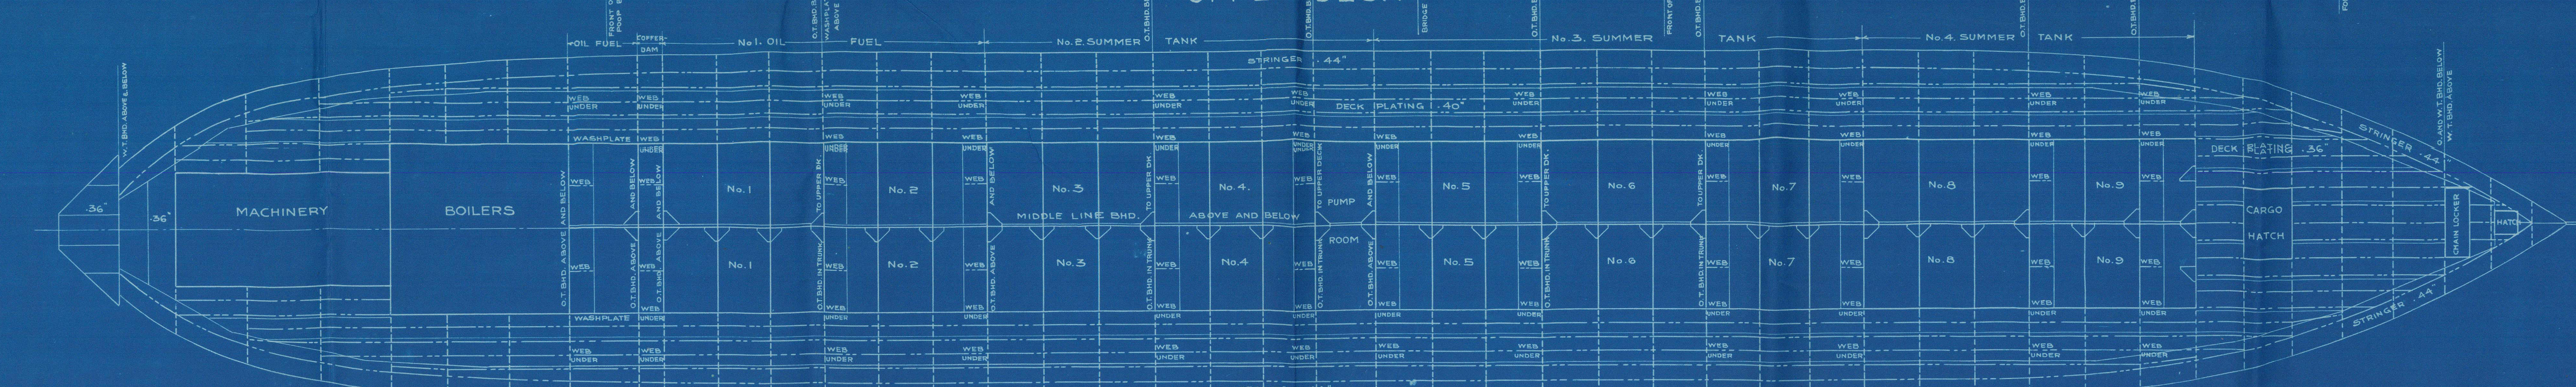

SECOND DECK

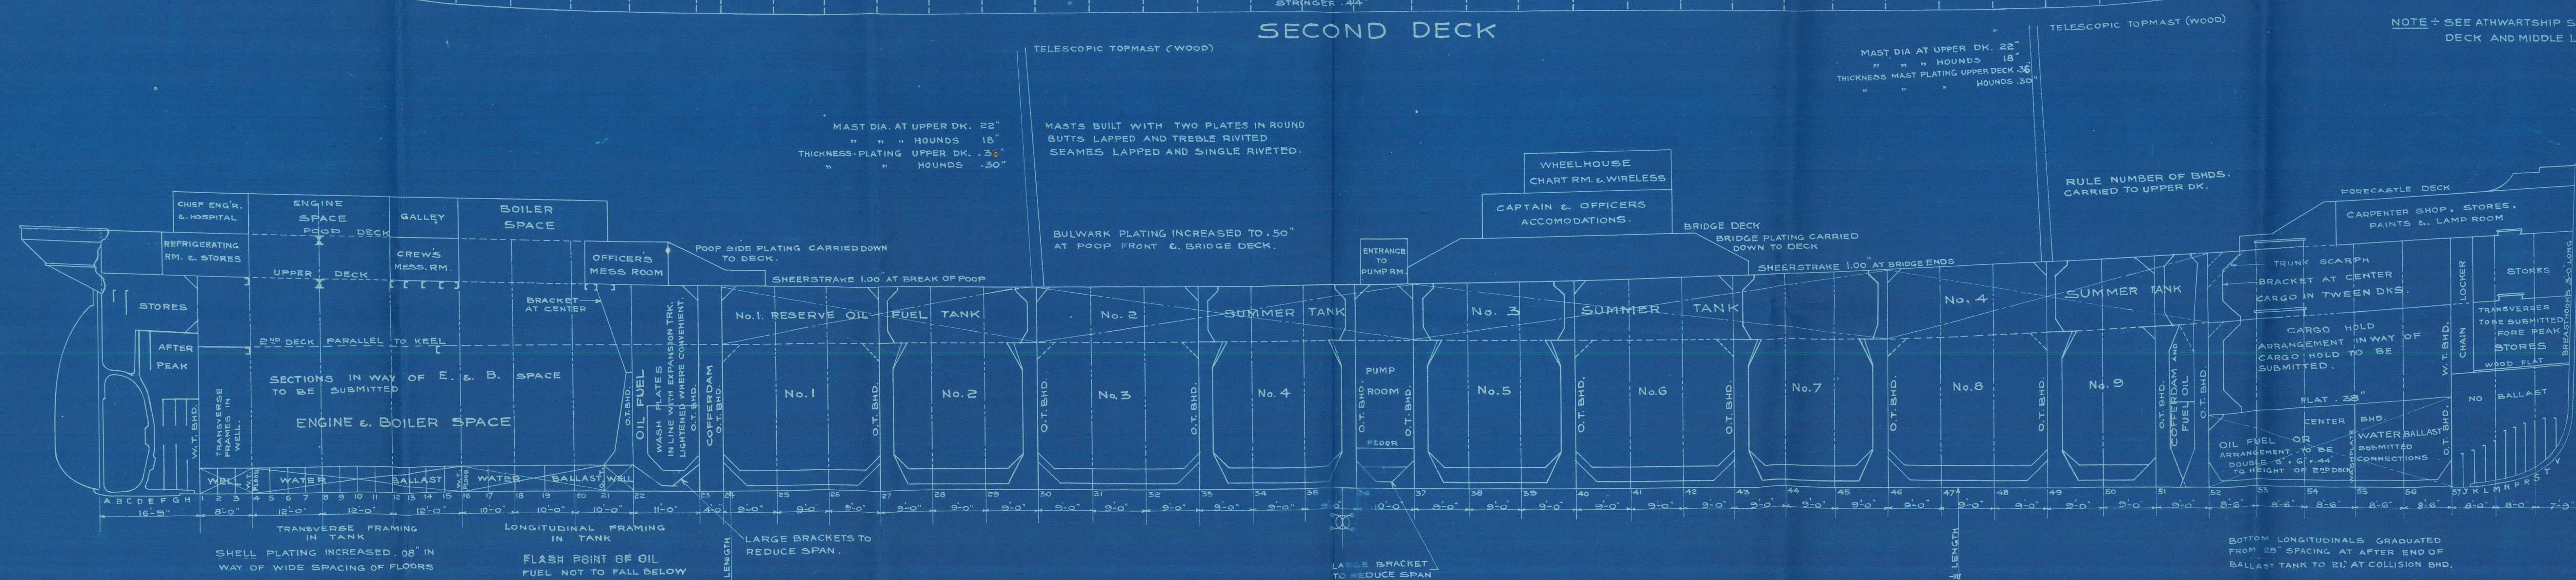

NOTE - THIS OIL TANKER TO BE BUILT UNDER THE "ISHERWOOD" PATENTS.

DIMENSIONS.
LENGTH 425' 57" BREADTH MLD. 33' DEPTH MLD.

SAN FRANCISCO
MOORE & SCOTT
IRON WORKS
HULL DEPARTMENT
LLOYDS PROFILE & DECK
PLANS - OIL TANKER No. III

DRAWN BY: W. J. W.
TRACED BY: W. J. W.
DATE: AUG. 1917.

DRAWING No. 5047

"S. S. FREDERIC R. KELLOGG"

Profile & Deck Plan
of vessel as built.

— N^o 111. —

Moore & Scott Iron Works
Oakland: Cal.



REMAIN