


LONGITUDINAL SECTION.

CLASS 100 A.I. LLOYDS.

SCALE 1/8"=1 FOOT.

RULE DIMENSIONS 370 88.50 FT. 27.25 BREADTH AT UPPER DECK 49.31.

UNDER DECK TONNAGE ABOUT 3955 TONS.

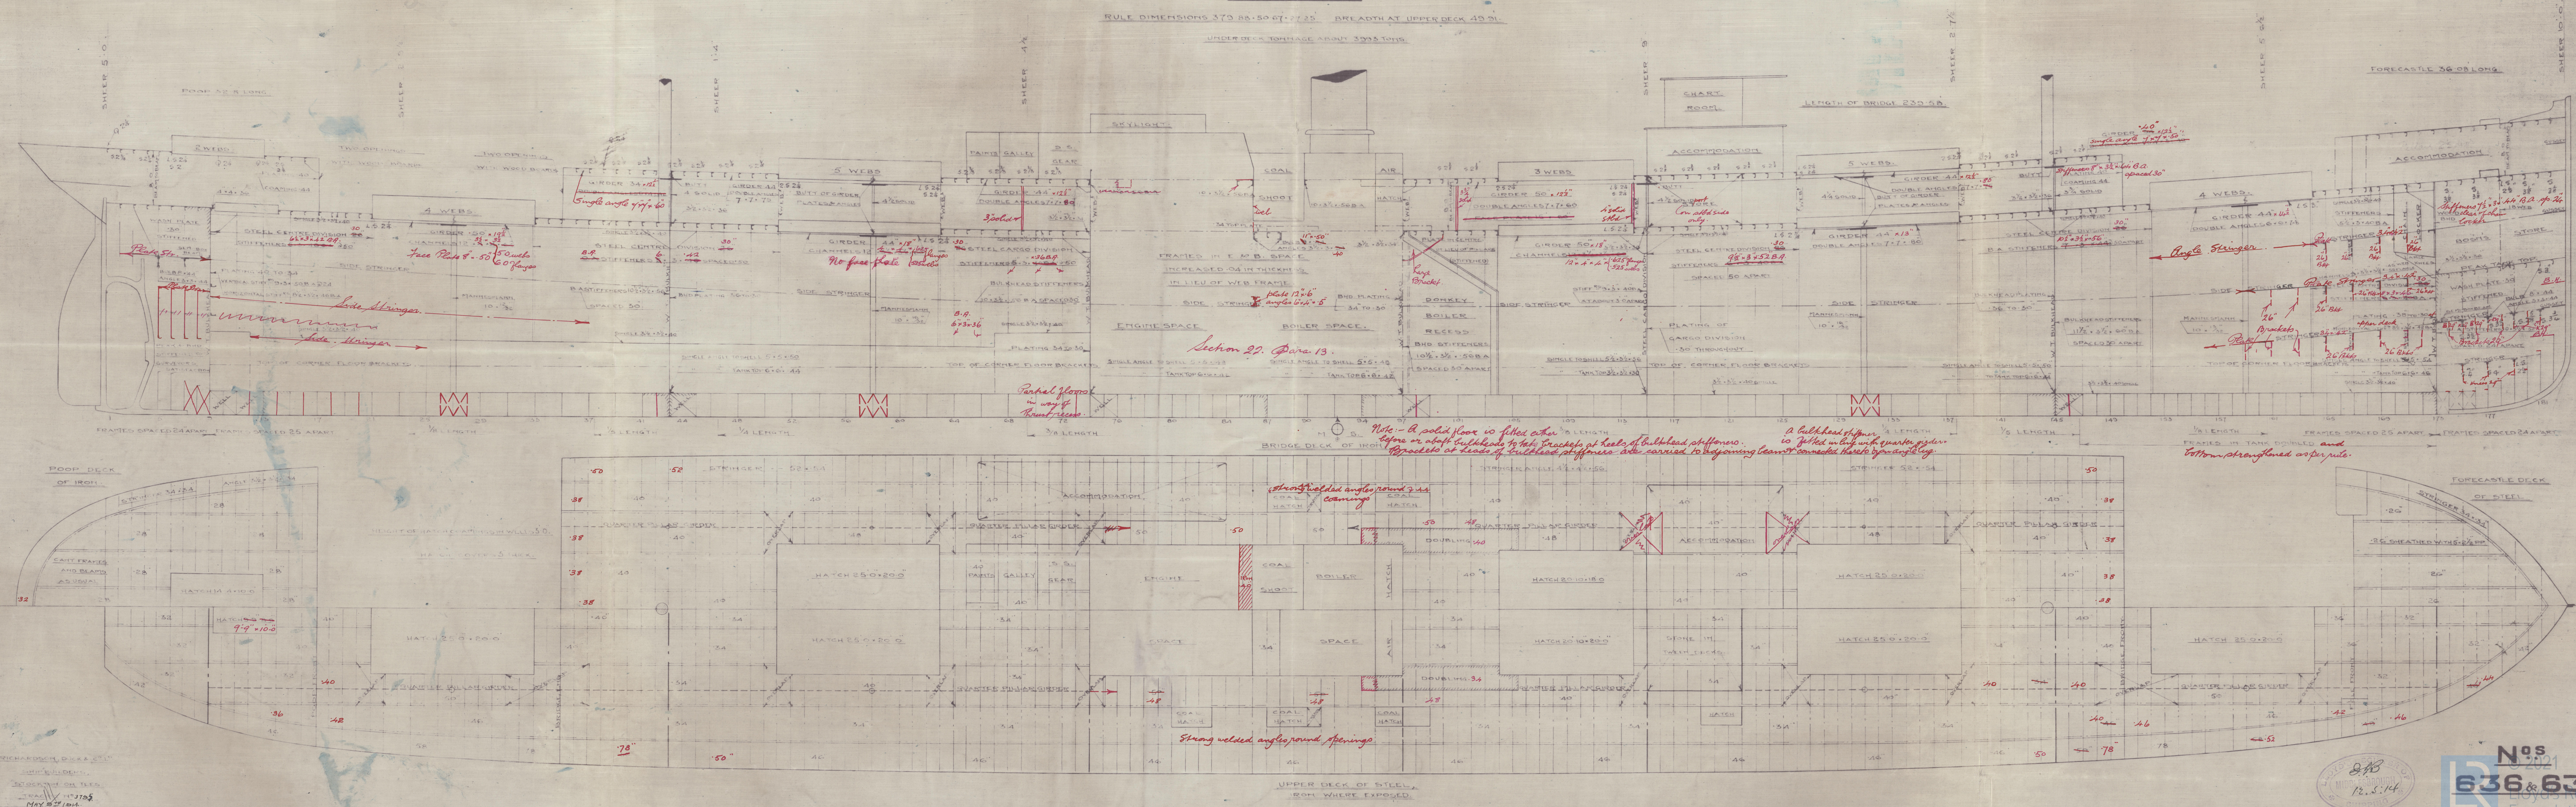

Section 22. Para 13.

Note: A solid floor is fitted either before or about bulkheads to take brackets at heads of bulkhead stiffeners. Brackets at heads of bulkhead stiffeners are carried to adjoining beam and connected hatch by angle leg.

Strong welded angle round openings

Bottom strengthened as per rule.

RICHARDSON, DECK, 211
SHIP BUILDING
SHEPPARD ST. E. 11705
MAY 22 1914

211
MAY 22 1914

Mus. Rⁿ Buck 1872 d


nr 638

Profile & Molds

as Built

S/S. Burnak

Indb. Rpt. No. 8420

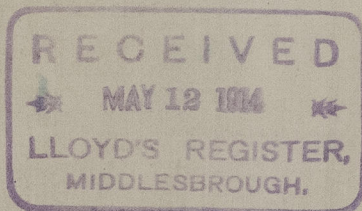

RETAIN

W1535-0098



© 2021

Lloyd's Register
Foundation