






24.8.05
2.9.05 (31172)
18.9.05
12.10.05
15.6.06

AFTER HOOKS OF SHELL
ON STEAMPOST TO BE TWO THICKNESSES
N.B. - PROPELLER BRACKETS NOT
CONNECTED TO STEAMPOST
LAST STEEL STEAMPOST 10x7
SPEED OF VESSEL ABOUT 11 KNOTS


Boat Deck plates in way of accommodation

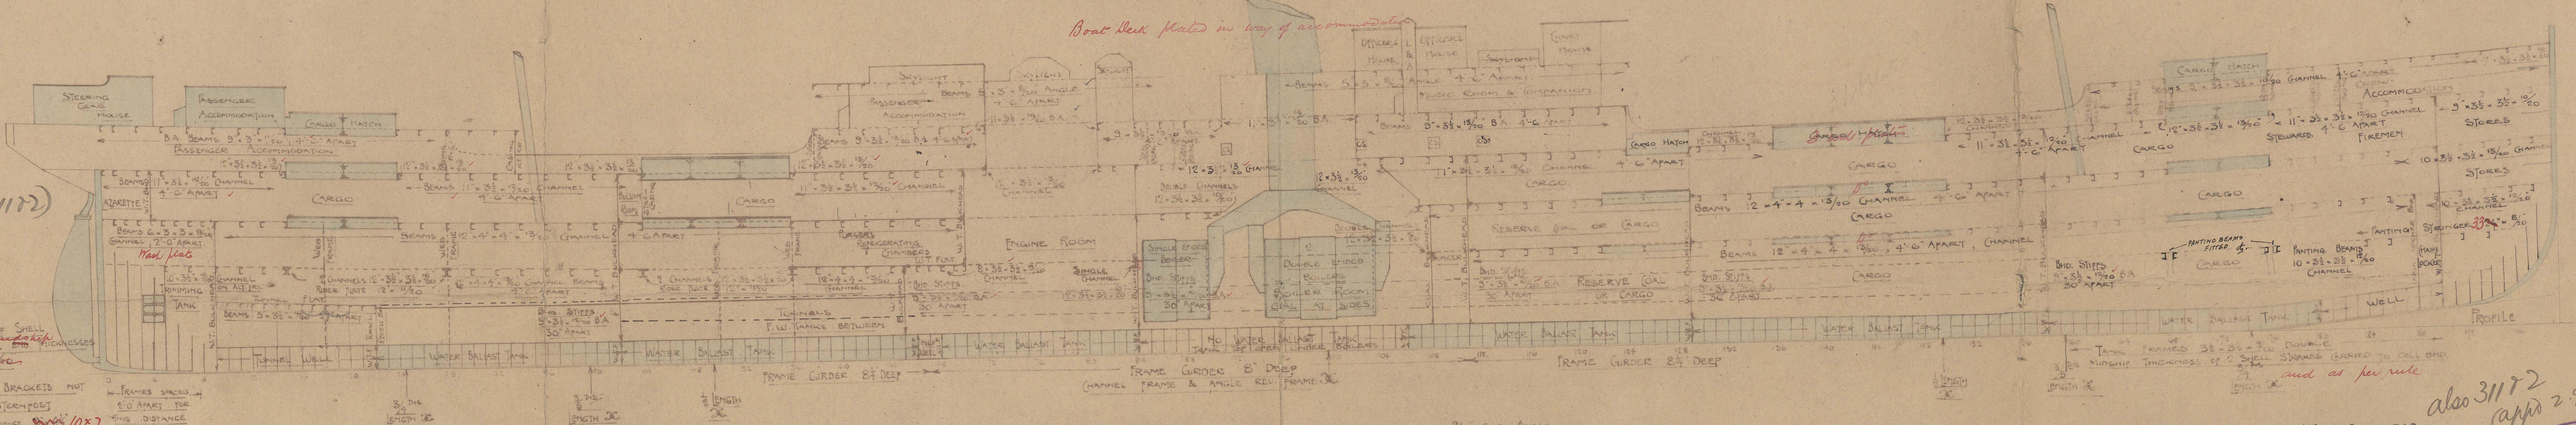

Nos 309 & 310
MLO. DIMS. 450' x 52' x 33'6" MLO.
PLAN OF DECKS & PROFILE
SCALE 1/4" = 1'-0"
SPEED OF VESSEL ABOUT 11 KNOTS

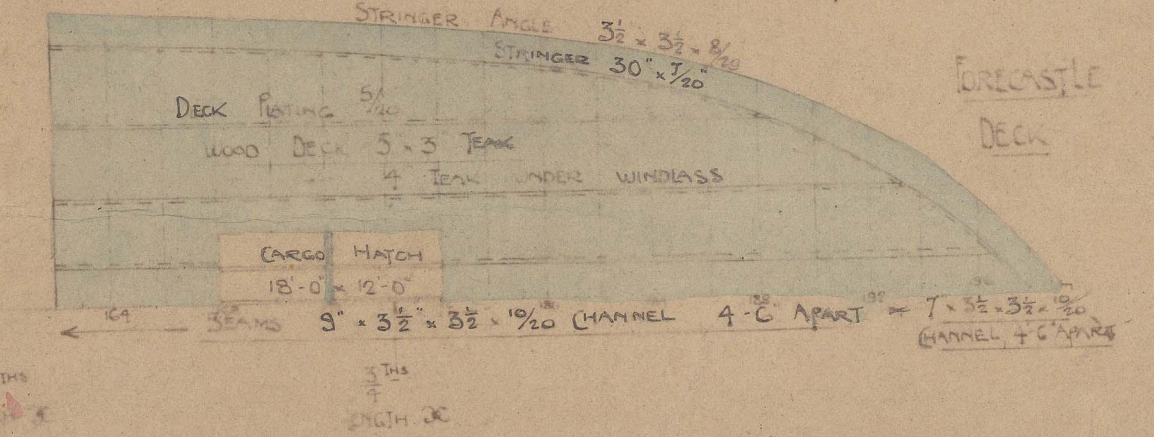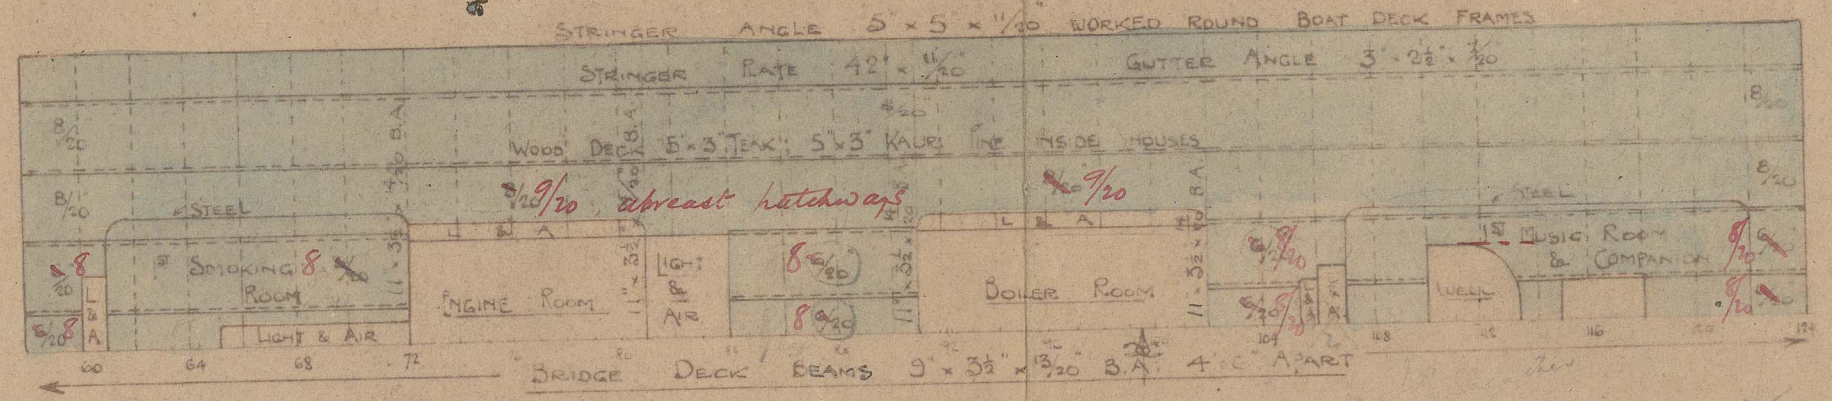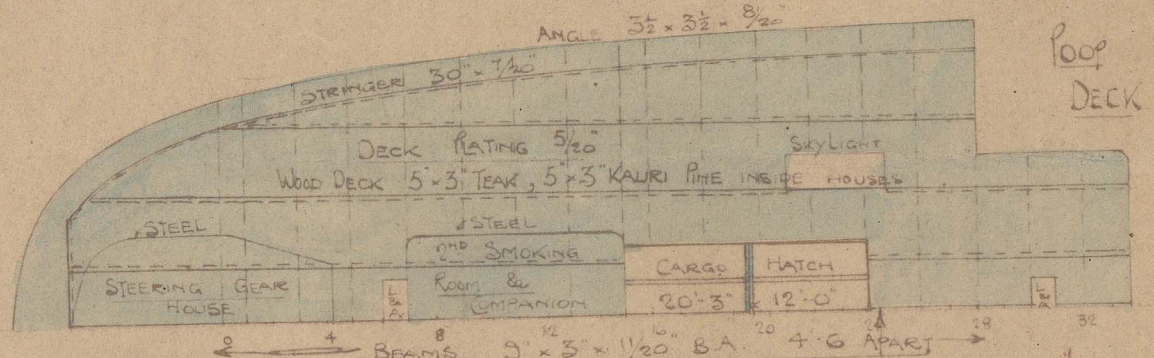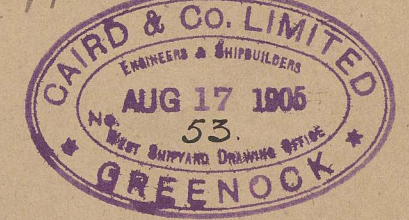

Hatchways & openings doubled
at corners as per rule

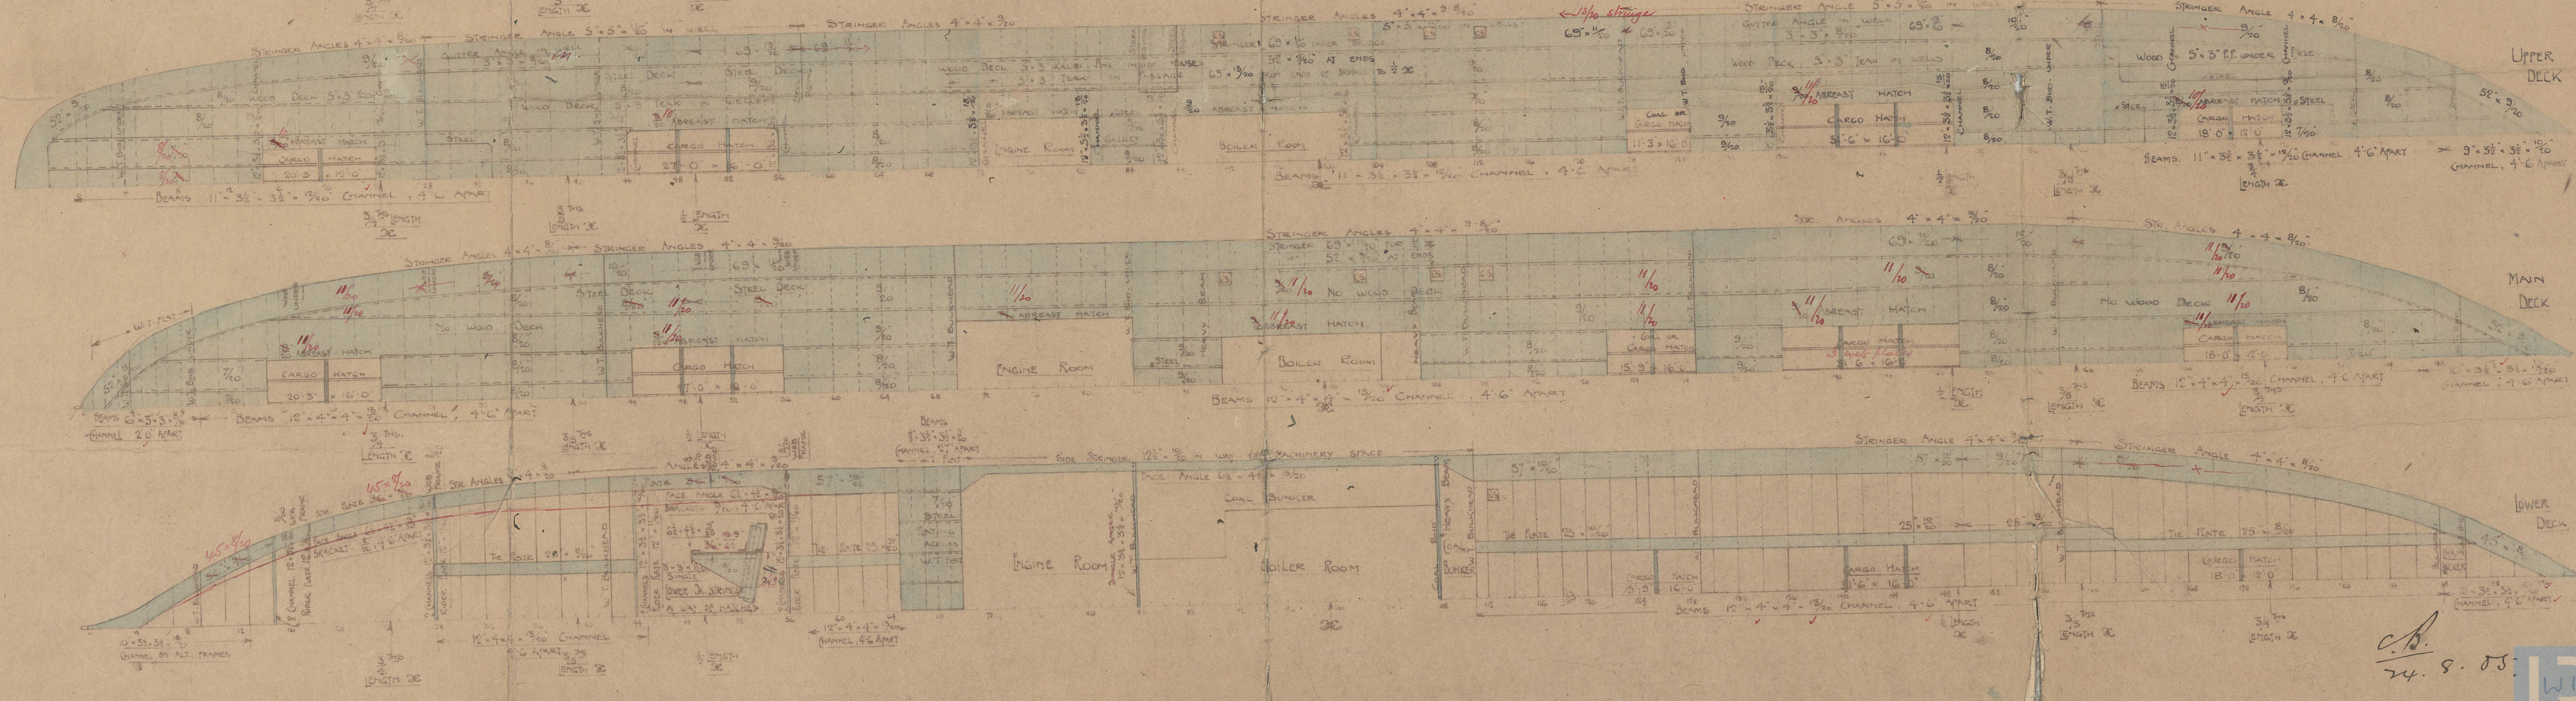


c.b.
24.8.05




70


71 72

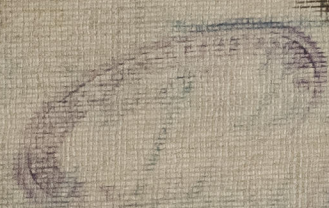


No 340 - ~~THE~~ NAME
Green ~~PT~~ No

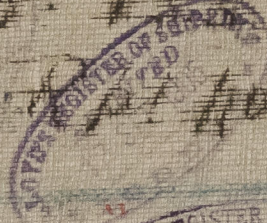

CNP 341
GIRK RPT AL 14007

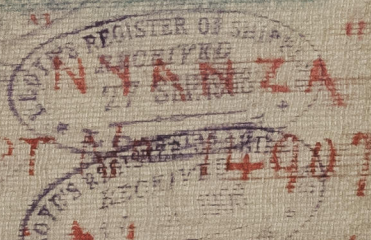

No 342
GIRK RPT AL 14953

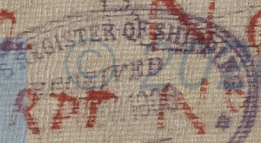

WITH CND



Hoyle's Register
Foundation