

SS. WAIR SUCCOUR

Now named "ASTER"

MIDSHIP SECTION.

411' 6" B.P. x 55' 5 1/2" MLD. x 38' 1 1/2" MLD. TO SHELTER DECK

TO CLASS 100 A.I. LLOYDS 'SHELTER DECK'
WITH SPECIAL NOTATION DESIGNATING TYPE OF BULGE.

B.S. * BRITISH CORPORATION.

SCALE 1/2" = 1 FOOT.

EQUIPMENT NUMBER.

HULL	= 35216.
TWEEN DECK 411' 5" x 8' 7 1/2" =	2276
CASING 65' 10 1/2" x 7 1/2" x 5" =	2276
HOUSE 32' 11" x 8' 0" x 5" =	128
FCL 4037' 7 1/2" x 7 1/2" =	2276
EQUIPMENT	40335
2 BOWER ANCHORS 68 CWTs STOCKLESS.	
1 " 58 1/2" STOCKLESS.	
1 STREAM 19' EX. STOCK.	
280 FATHOMS 2 5/8" STUD CHAIN CABLE.	
90 " 1 5/8" STREAM CHAIN OR 5" S.W. ROPE.	
120 " 1 5/8" HEMP OR 5 1/4" S.W. ROPE TOWLINE.	
2 OFF 90 " 8" HEMP HANGERS OR 2 5/4" S.W. ROPE.	
2 OFF 90 " 7" " 2 1/2" S.W. ROPE.	

LLOYD'S NUMBERS.


B	= 55' 5 1/2"
D	= 30' 1 1/2"
85' 7" = 85.583	= TRANS. N°
L = 411' 6" = 411.5	
35216	= LONG. N°

L	{ SHELTER DECK = 10' 7 1/8"
D	{ UPPER DECK = 14' 3"


38' 1 1/2" DEPTH MILD.
9' 4 3/4" TWEEN DECKS.
28' 8 3/4" " "
3' 7 3/4" TANK.
25' 1" " "
7 1/2" " " 1/2" DFT. OF RULE
24' 5 1/2" " " 3" APP. TANK BRACKET

SECTIONS USED.

0.4	B.A.
7' x 7"	10' x 3 1/2"
5' x 5"	9' x 3 1/2"
OR 4 1/2" x 4 1/2"	
9' x 4"	
4' x 4"	
6' x 3 1/2"	
3 1/2' x 3 1/2"	
3' x 3"	

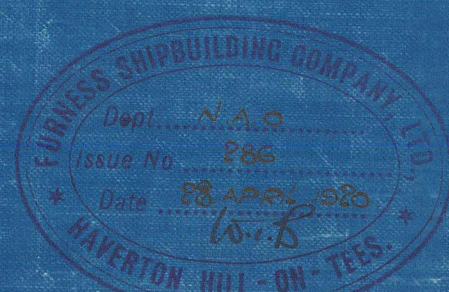

B OR UPPER DECK

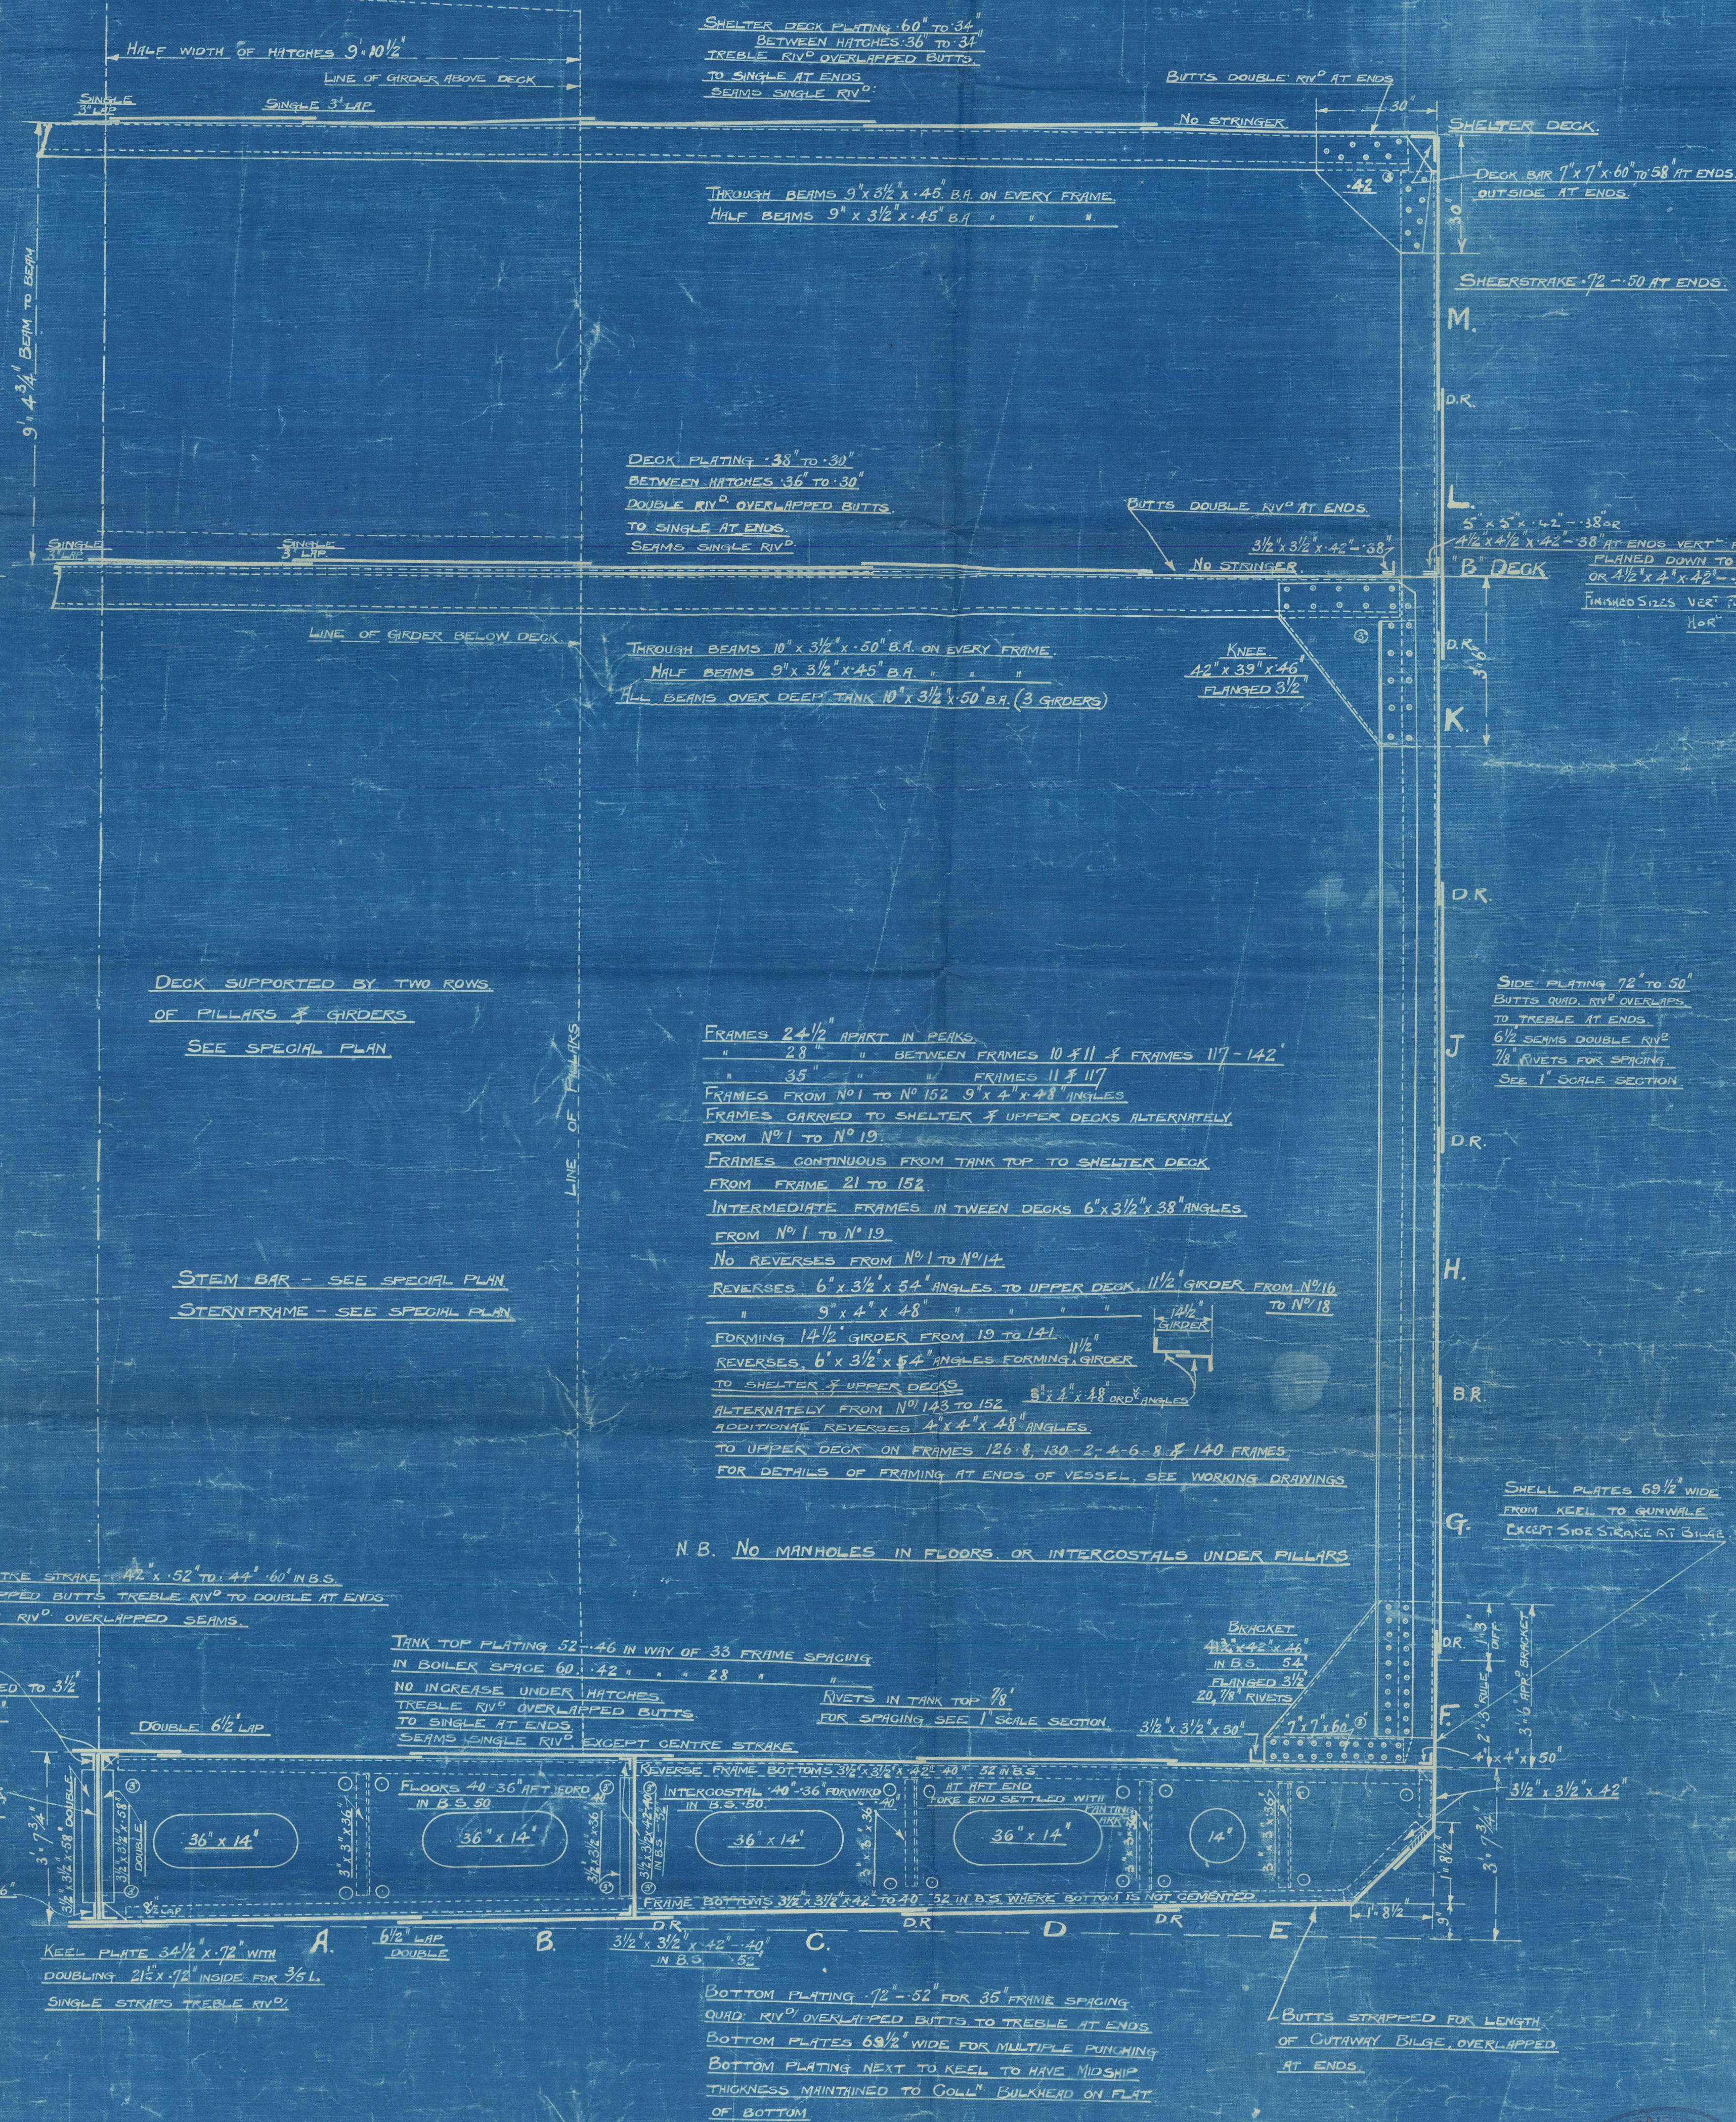

Thos^r. Furness. S. B. 6²

N^o 11

MIDSHIP SECTION
(AS BUILT)

"S. S. WAR SUCCOUR"

NOW NAMED "ASTER"

Mar. Rpt. No. 10666

RETAIN



© 2021

Lloyd's Register
Foundation

W1571-0182