

SS. CROMARTY FIRTH.

MIDSHIP SECTION.

DIMENS^S 135'-0" x 24'-0" x 10'-9" M^{LD}

SCALE 1/2" = 1 FOOT

TO CLASS 100 A1. AT LLOYDS

LLOYDS NUMERALS

| | |
|---|--|
| DEPTH "D" | 10.75 |
| 1 ST LONG TH NO L x D | 1451 |
| 2 ND " " L(B+D) | 4691 |
| PROPORTIONS $\frac{L}{D}$ | 12.55 |
| " " $\frac{L}{B}$ | 9.64 IN WAY OF Q ^R D ^S |
| DEPTH "D" | 10.75 |
| " " FOR FLOOR | 1.02 |
| " " FOR NO BRACKETS | 9.73 |
| FRAMING DEPTH "d" | 10.23 |

EQUIPMENT - LETTER 'C'

| | | |
|-----------------------------------|-----------------|---------------------|
| L(B+D) | = 135(24+10.75) | 4691.25 |
| Q ^R D ^S | 52.5 x 3.25 | 170.6 |
| F/C ^{BLE} D ^S | 3/4(23 x 7) | 120.75 |
| BRIDGE | 3/4(875 x 7) | 45.9 |
| HOUSES | 1/2(41 x 6.75) | 158.625 |
| | | 5187.125 LETTER 'C' |

2 BOWER ANCHORS 8 1/4 CMT³ STOCKLESS


1 STREAM " 2 3/4 " EX. STOCK

165 FATHOMS 1 5/16" STUD CHAIN CABLE


45 " 2 1/4" STEEL WIRE ROPE

15 " 2 1/2" " " "

90 " 1 3/4" " " " HAWSER

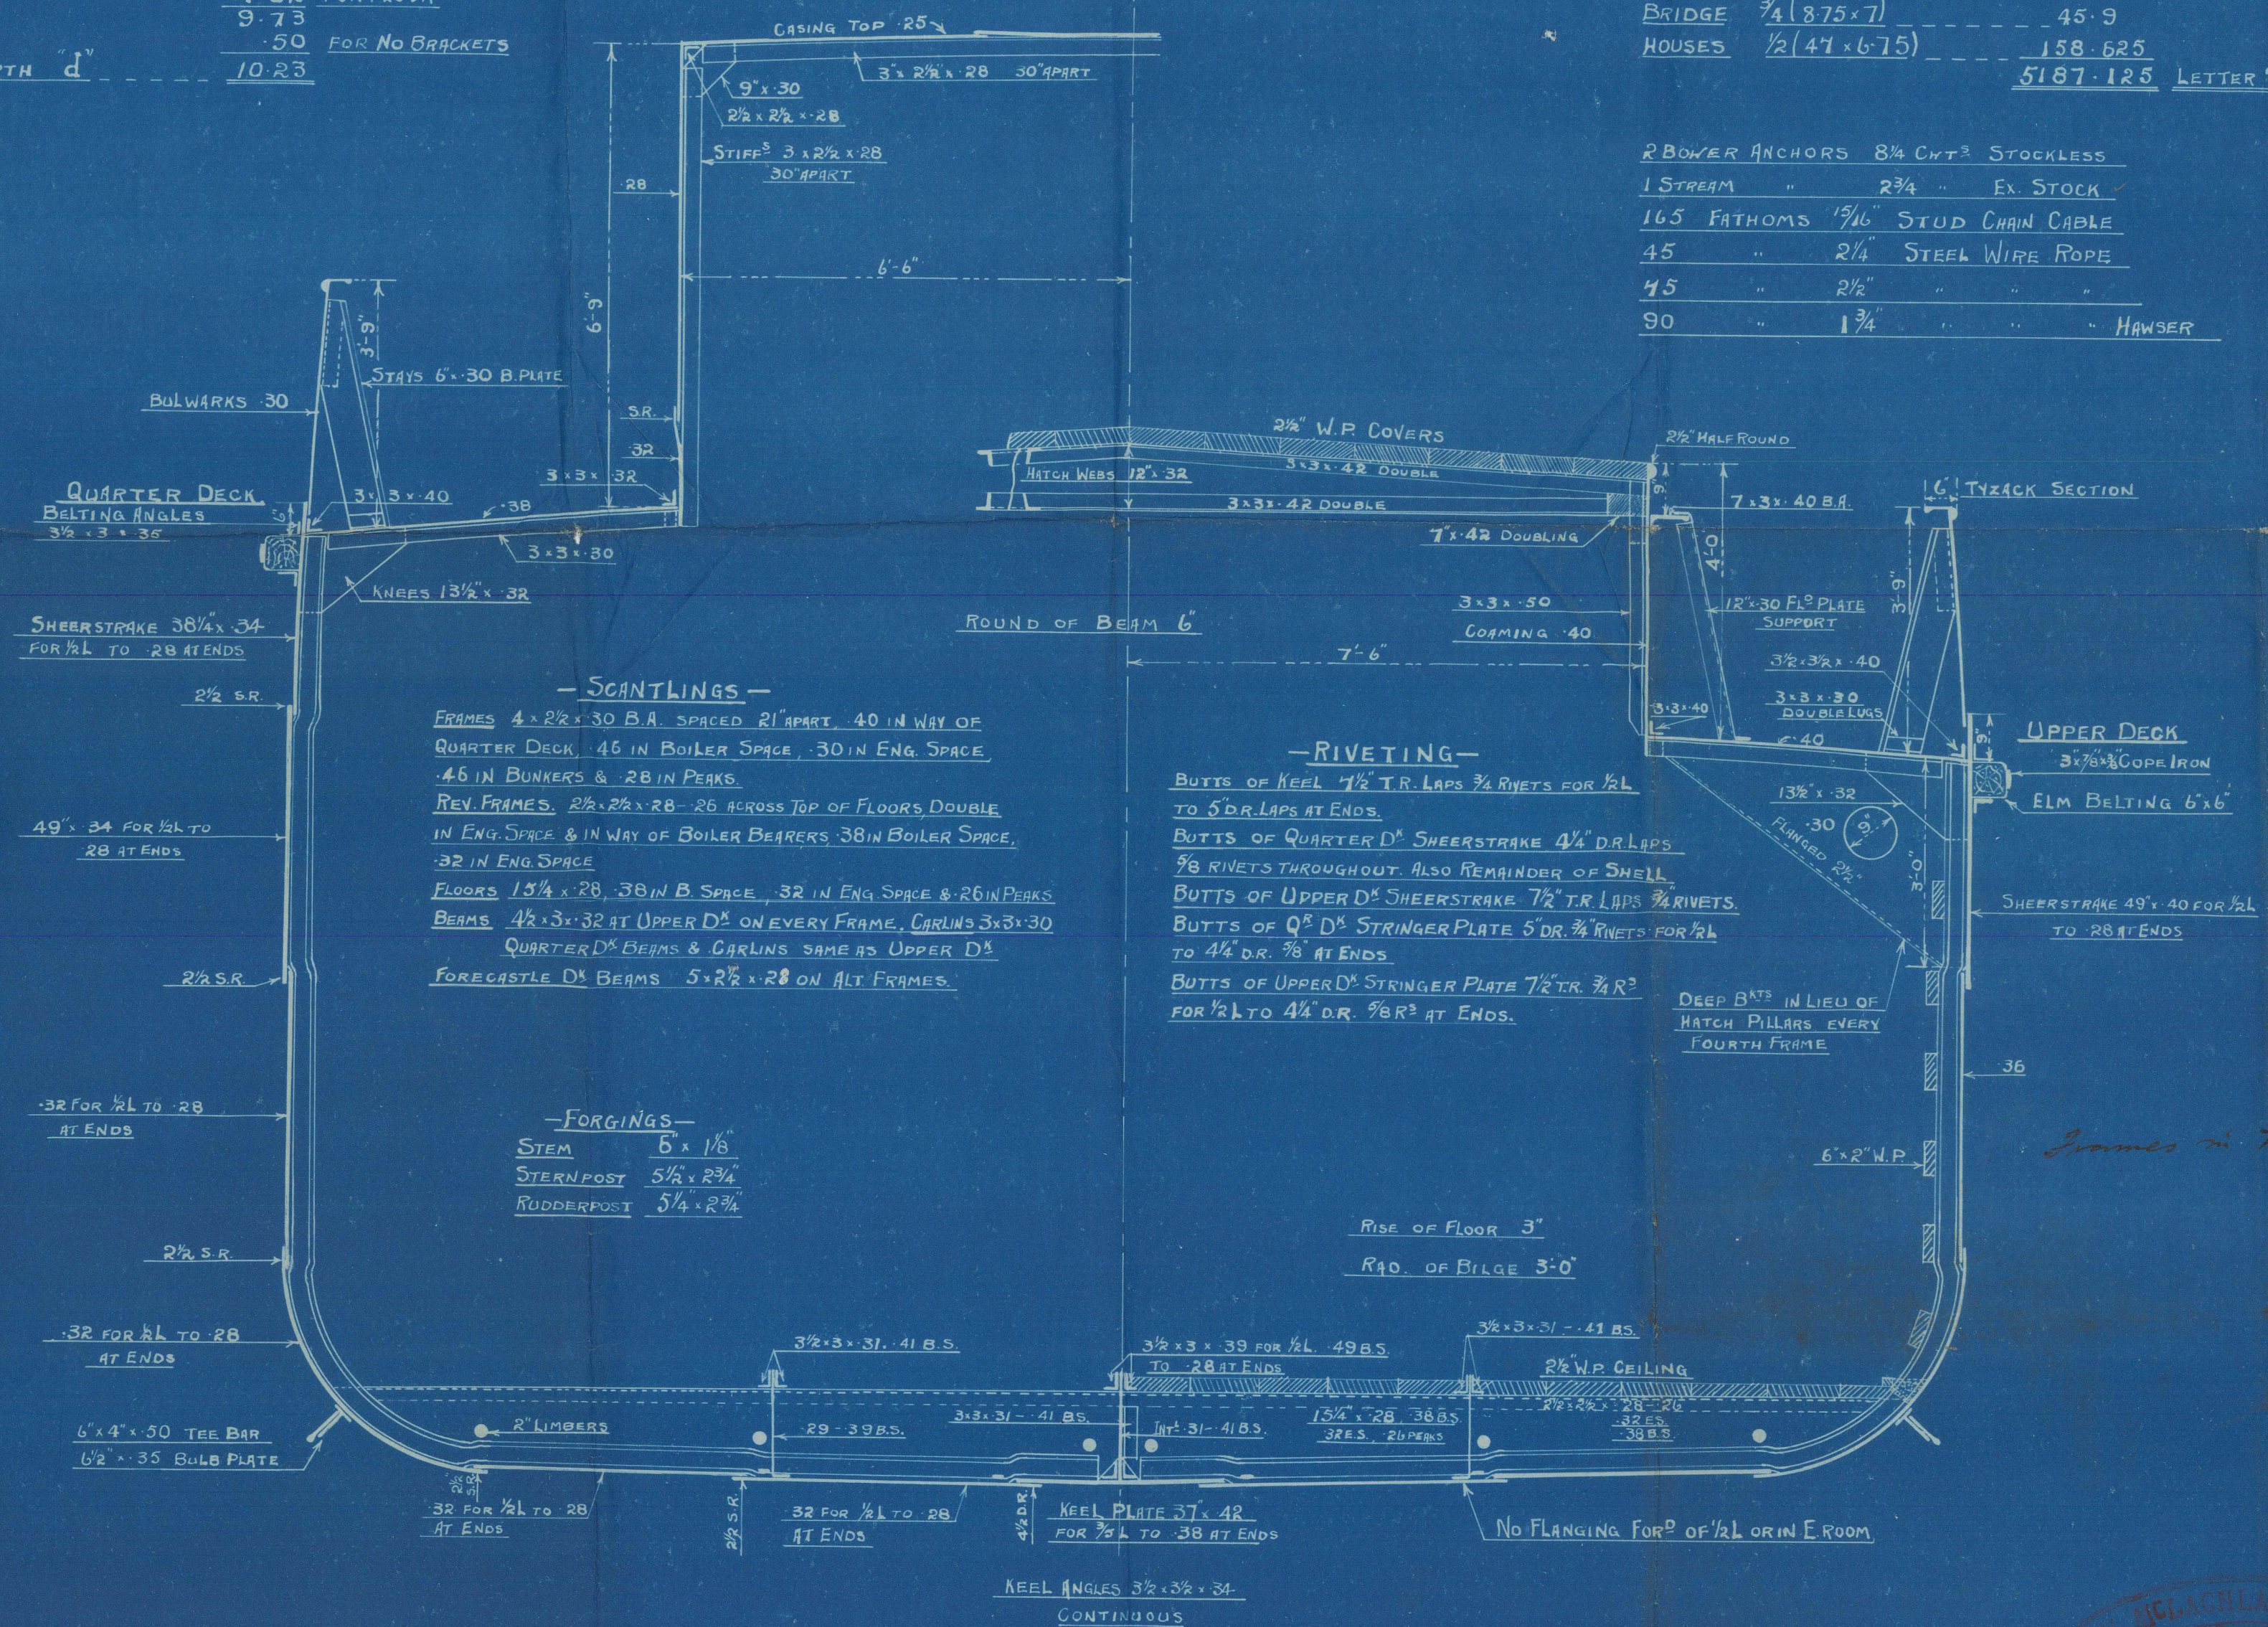

Frames in hull removed 7/1/12 - replaced 5 x 3 x 3/4 B.A.

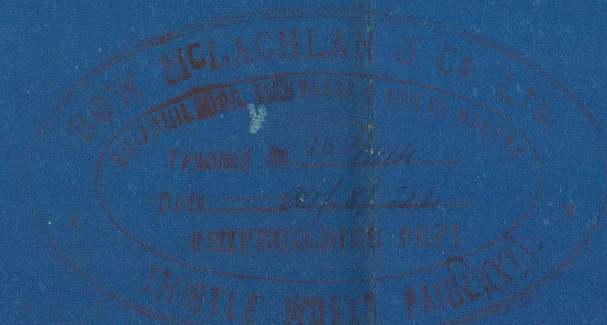

Bow, McLACHLAN & Co

MIDSHIP SECTION

No 414

"CROMARTY FIRTH."

7. 7.

Cragman.

as built

1600.

GLASGOW REPORT NO.

43999



Lloyd's Register
Foundation