

Alt No.	Alteration	Approved	By	Date
1	Nonstructural "T" on Upper Deck			
2	TURNED OUT BOARD			
3	Duplicate No 5304 ADDED AS NOTED			

Alt No.	Alteration	Approved	By	Date
1	Nonstructural "T" on Upper Deck			
2	TURNED OUT BOARD			
3	Duplicate No 5304 ADDED AS NOTED			

No 5304 "ALGONQUIN"

General Dimensions

Length B.P.	377-0
Beam mid.	56-0
Depth mid to upper deck	37-6

Lloyd's Numerals

B+D .89.9 Trans No. (3+0) .2	389.72
Decks to Lengths	12.98
Pop, Bridge & Forecastle	1267
E&B Casings & Midship House	476
Equip. N°	40675
Equip. Letter	B1

Stem, Sternpost, etc.

Stem	102 x 23
Propeller Post	103 x 31
Rudder Post	9 x 81
Frames in peak	7 1/2 x 40 Rev 7 1/2 x 40 24 apart
Depth of Framing	61

Anchor & Chains

1 Bower anchor stockless	2960
1 " "	3120
1 " "	4420
1 Stream	2400
1 Hedge	1600
240 Fathoms 2 1/2 Steel Line Chain Cable	
120 " 5 Steel Wire Stream Line	
170 " 3 " " " "	
Chains 2 lengths 8 Manila each end to bottom wraps 2	

5304 SS "Algonquin"

Duplicate for

H-5257-11-2 Union Plant

BETHLEHEM STEEL COMPANY
BETHLEHEM PA


MIDSHIP SECTION
10100 TON TANKER

SCALE 1/2" = 1'-0" DATE 5-13-40

DRAWN *W. H. H.* APPROVED *W. H. H.*

TRACED *W. H. H.* APPROVED *W. H. H.*

CHECKED *W. H. H.* APPROVED *W. H. H.*

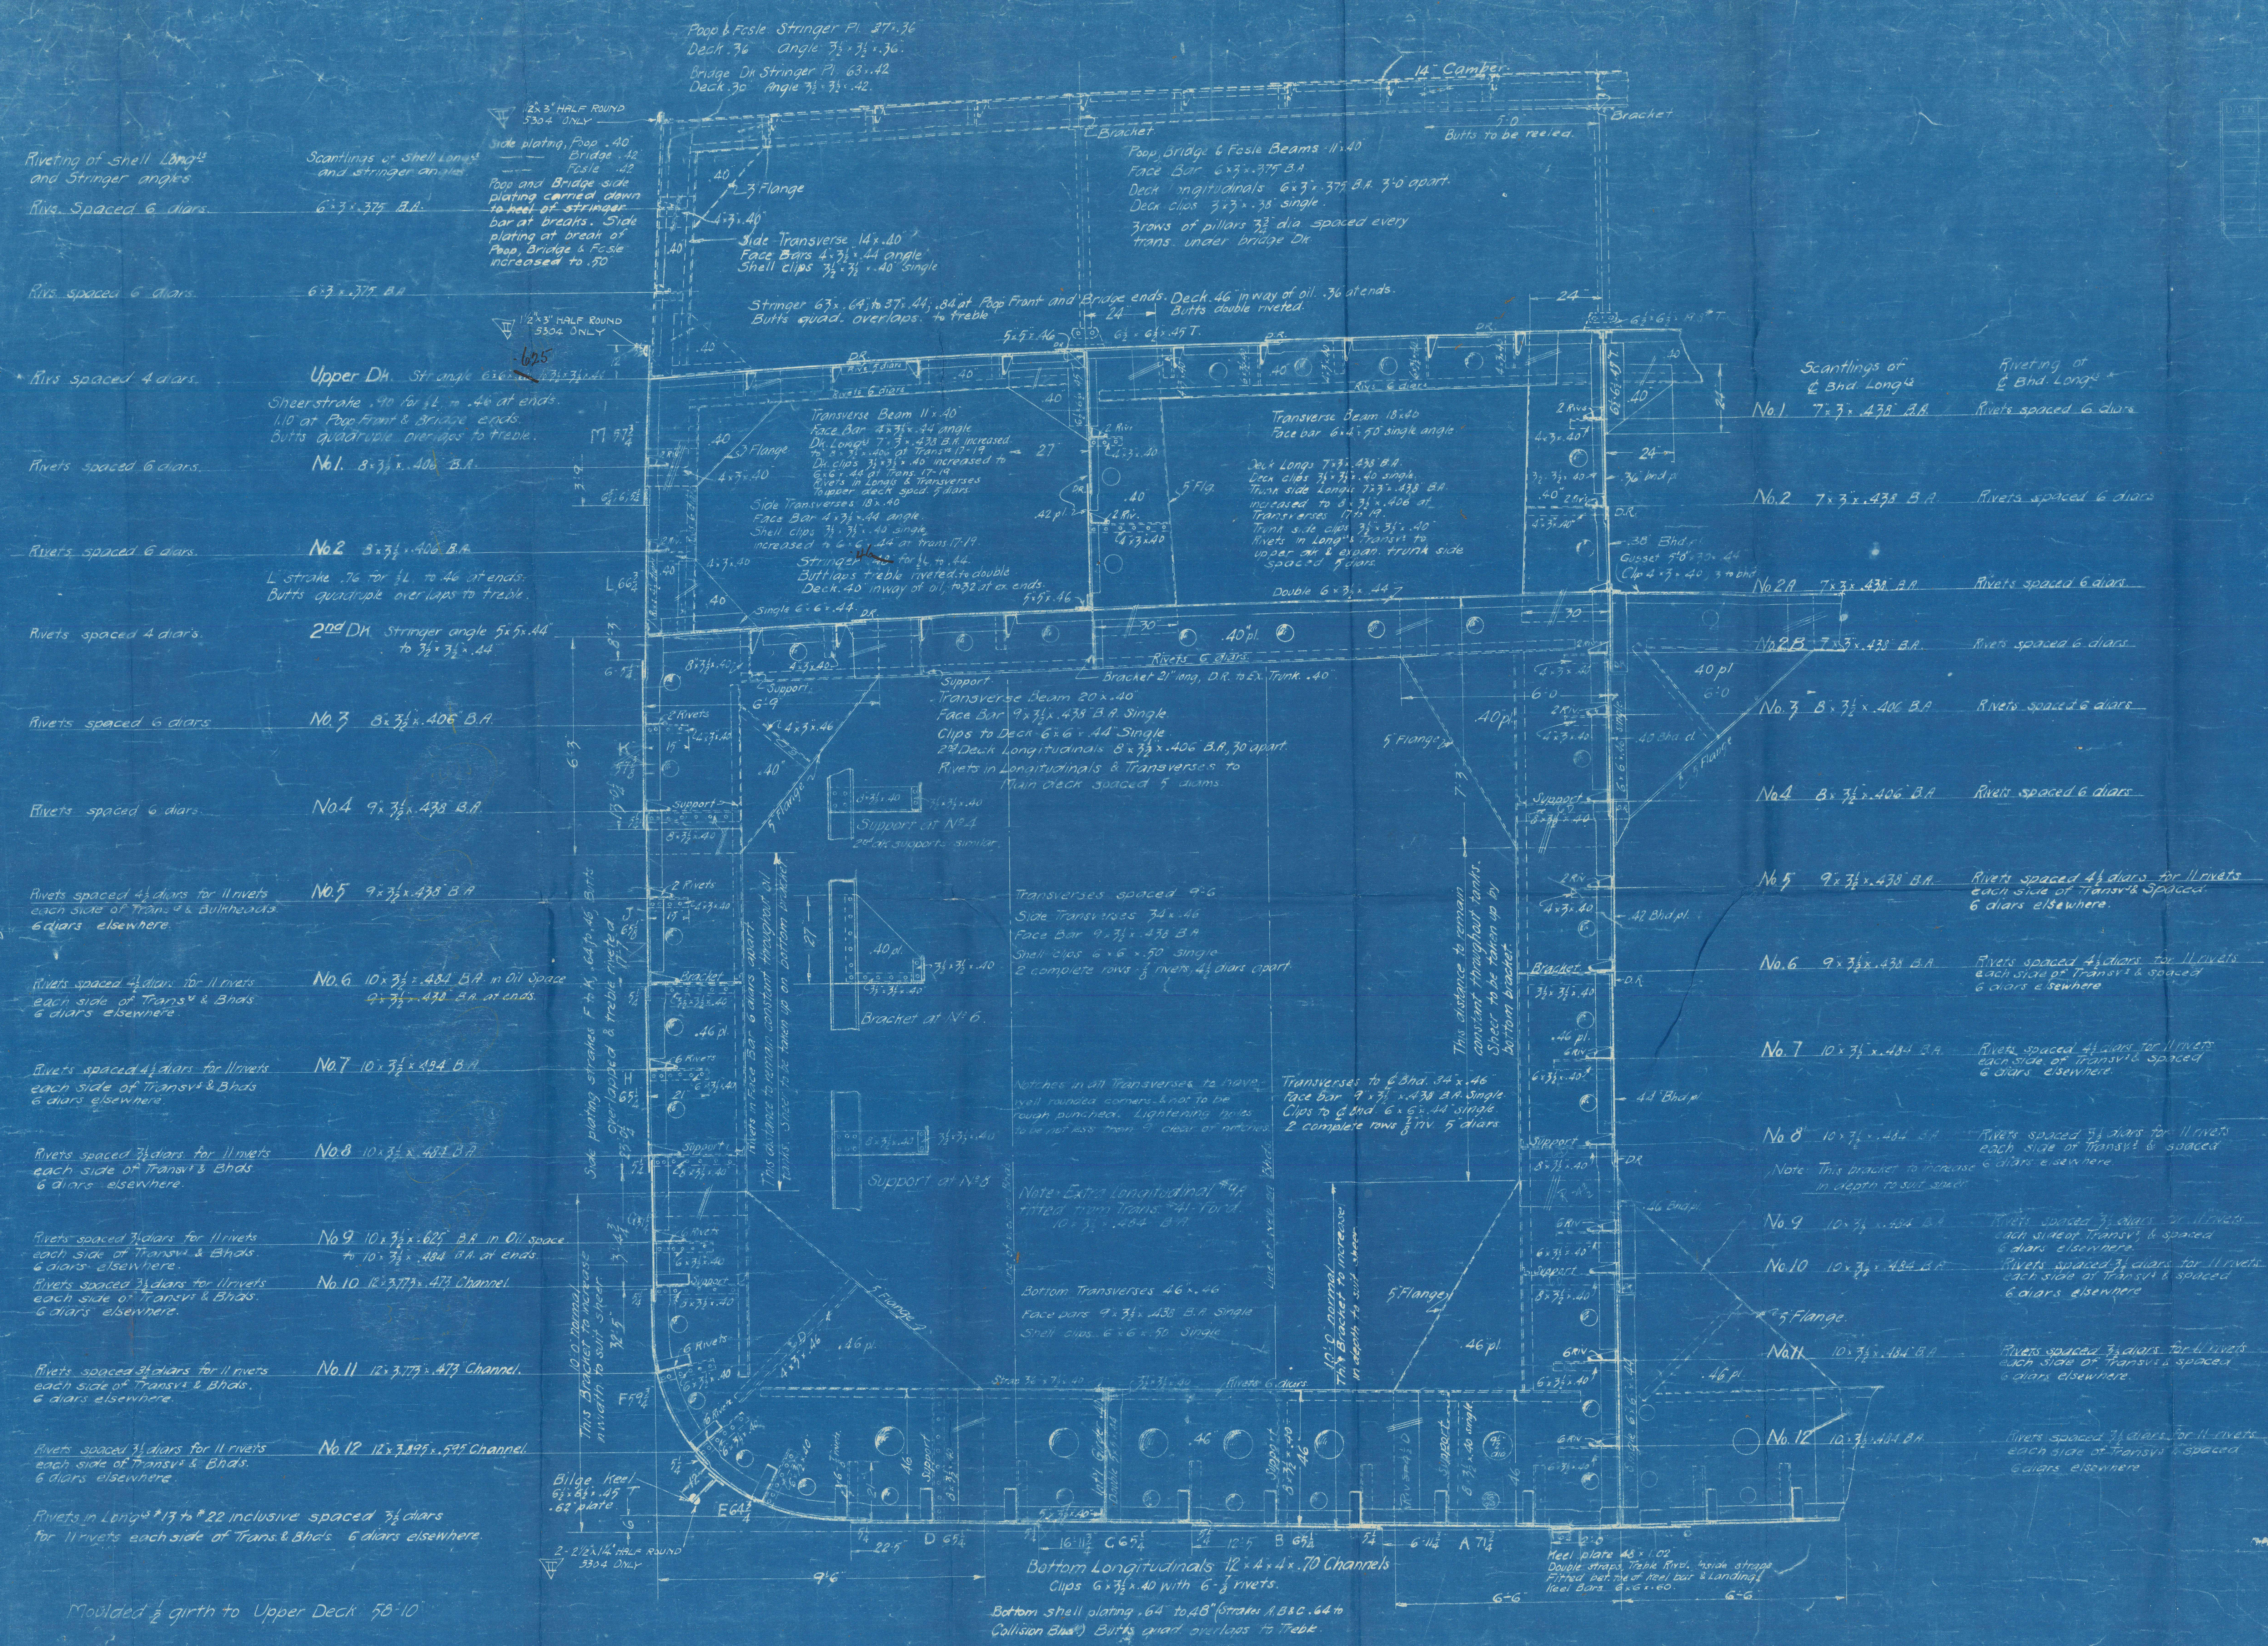

Midship Section of Ship
as built

Bethlehem S. B. Corpus.

No 3304. " Algonquin

S. G. rpt. No 3394.

2056 R.S.

692. Awh



4110

Midship Section of Ship
as built

Bethlehem S. B. Corp.

No 5304. "Algonquin"

S. To rpt. No 3394.

2056 R.S.

692 awl

RETAIN



© 2021

Lloyd's Register
Foundation

W1624-0186