

# $\frac{5}{8}$ DARTFORD.



## PROFILE & DECK PLANS.

LENGTH 365.0 BP — BREADTH 51.9 MLD — DEPTH 27.0 MLD.

TO CLASS 100A.1. AT LLOYDS.

SCALE  $\frac{1}{8}$  = 1 FOOT.

THE NEW BRITISH STANDARD SECTION BULB ANGLE IS ADOPTED.

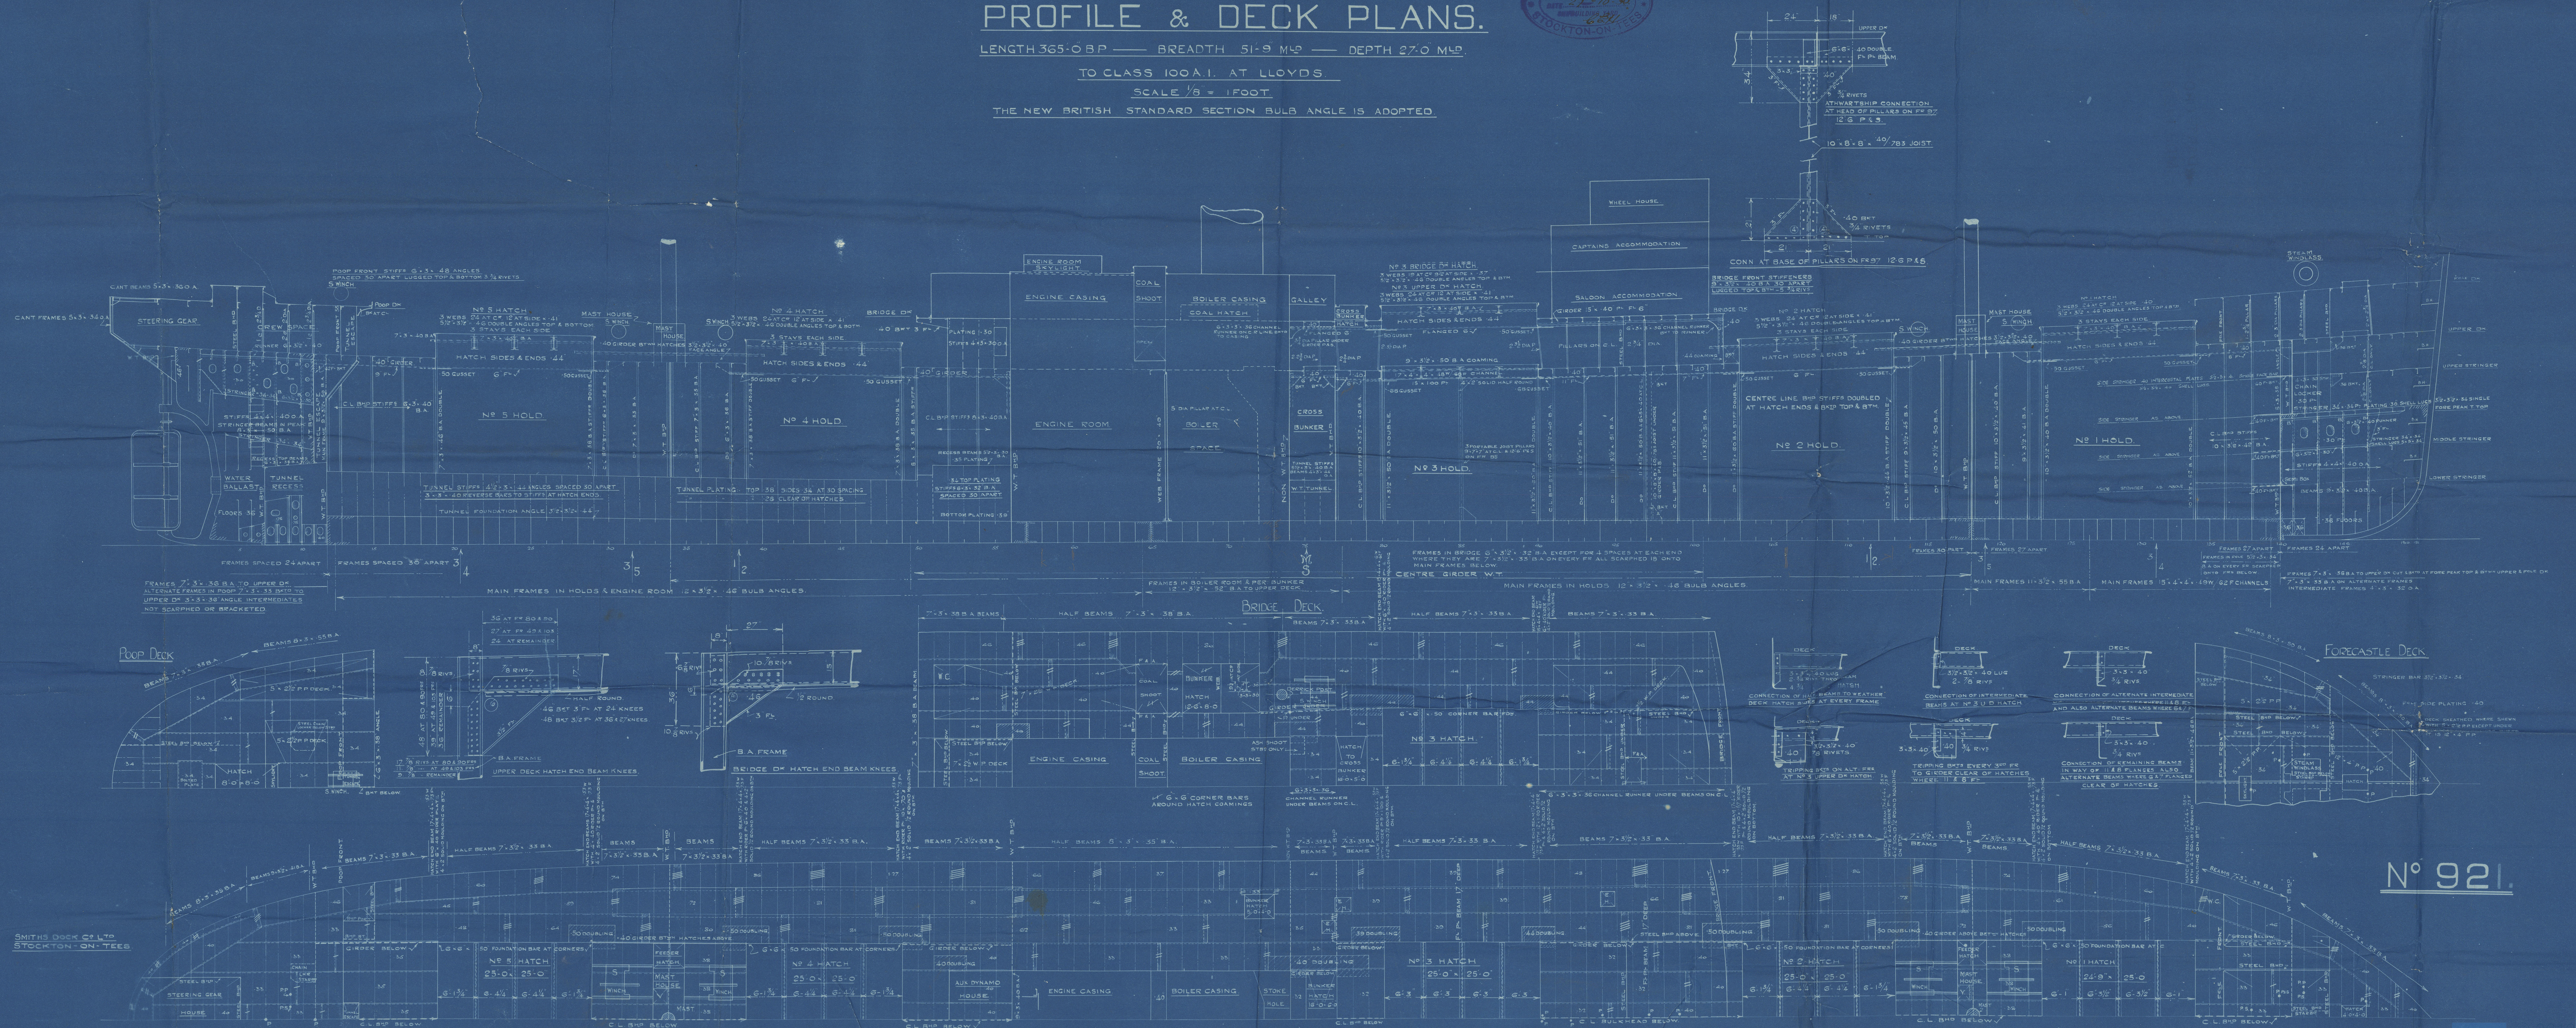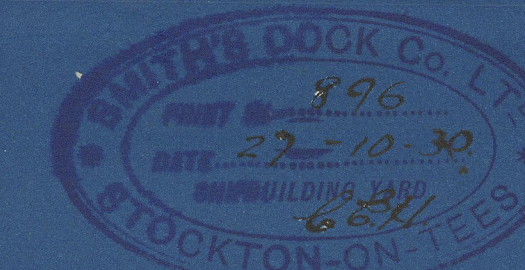

N° 921.



PROFILE & DECK PLANS  
(AS BUILT)

S.S. Dartford  
MDB. RPT. No. 14258

—  
—  
—  
DARTFORD  
MDB. 14263



© 2019

Lloyd's Register  
W163-0027  
Foundation