

13.12.35

MIDSHIP SECTION.


STEEL SCREW TRAWLER

DIMENSIONS :- 161'-9" B.P. x 27'-0" MLD x 15'-3" DEPTH MLD.


LONGITUDINAL NUMBER $L \times D = 2466$

$D = 15.25$

EQUIPMENT NUMBER $L \times (B+D) = 6833$

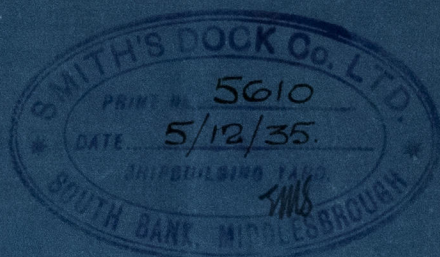

EQUIPMENT. AS APPROVED
FOR N° 9843-4

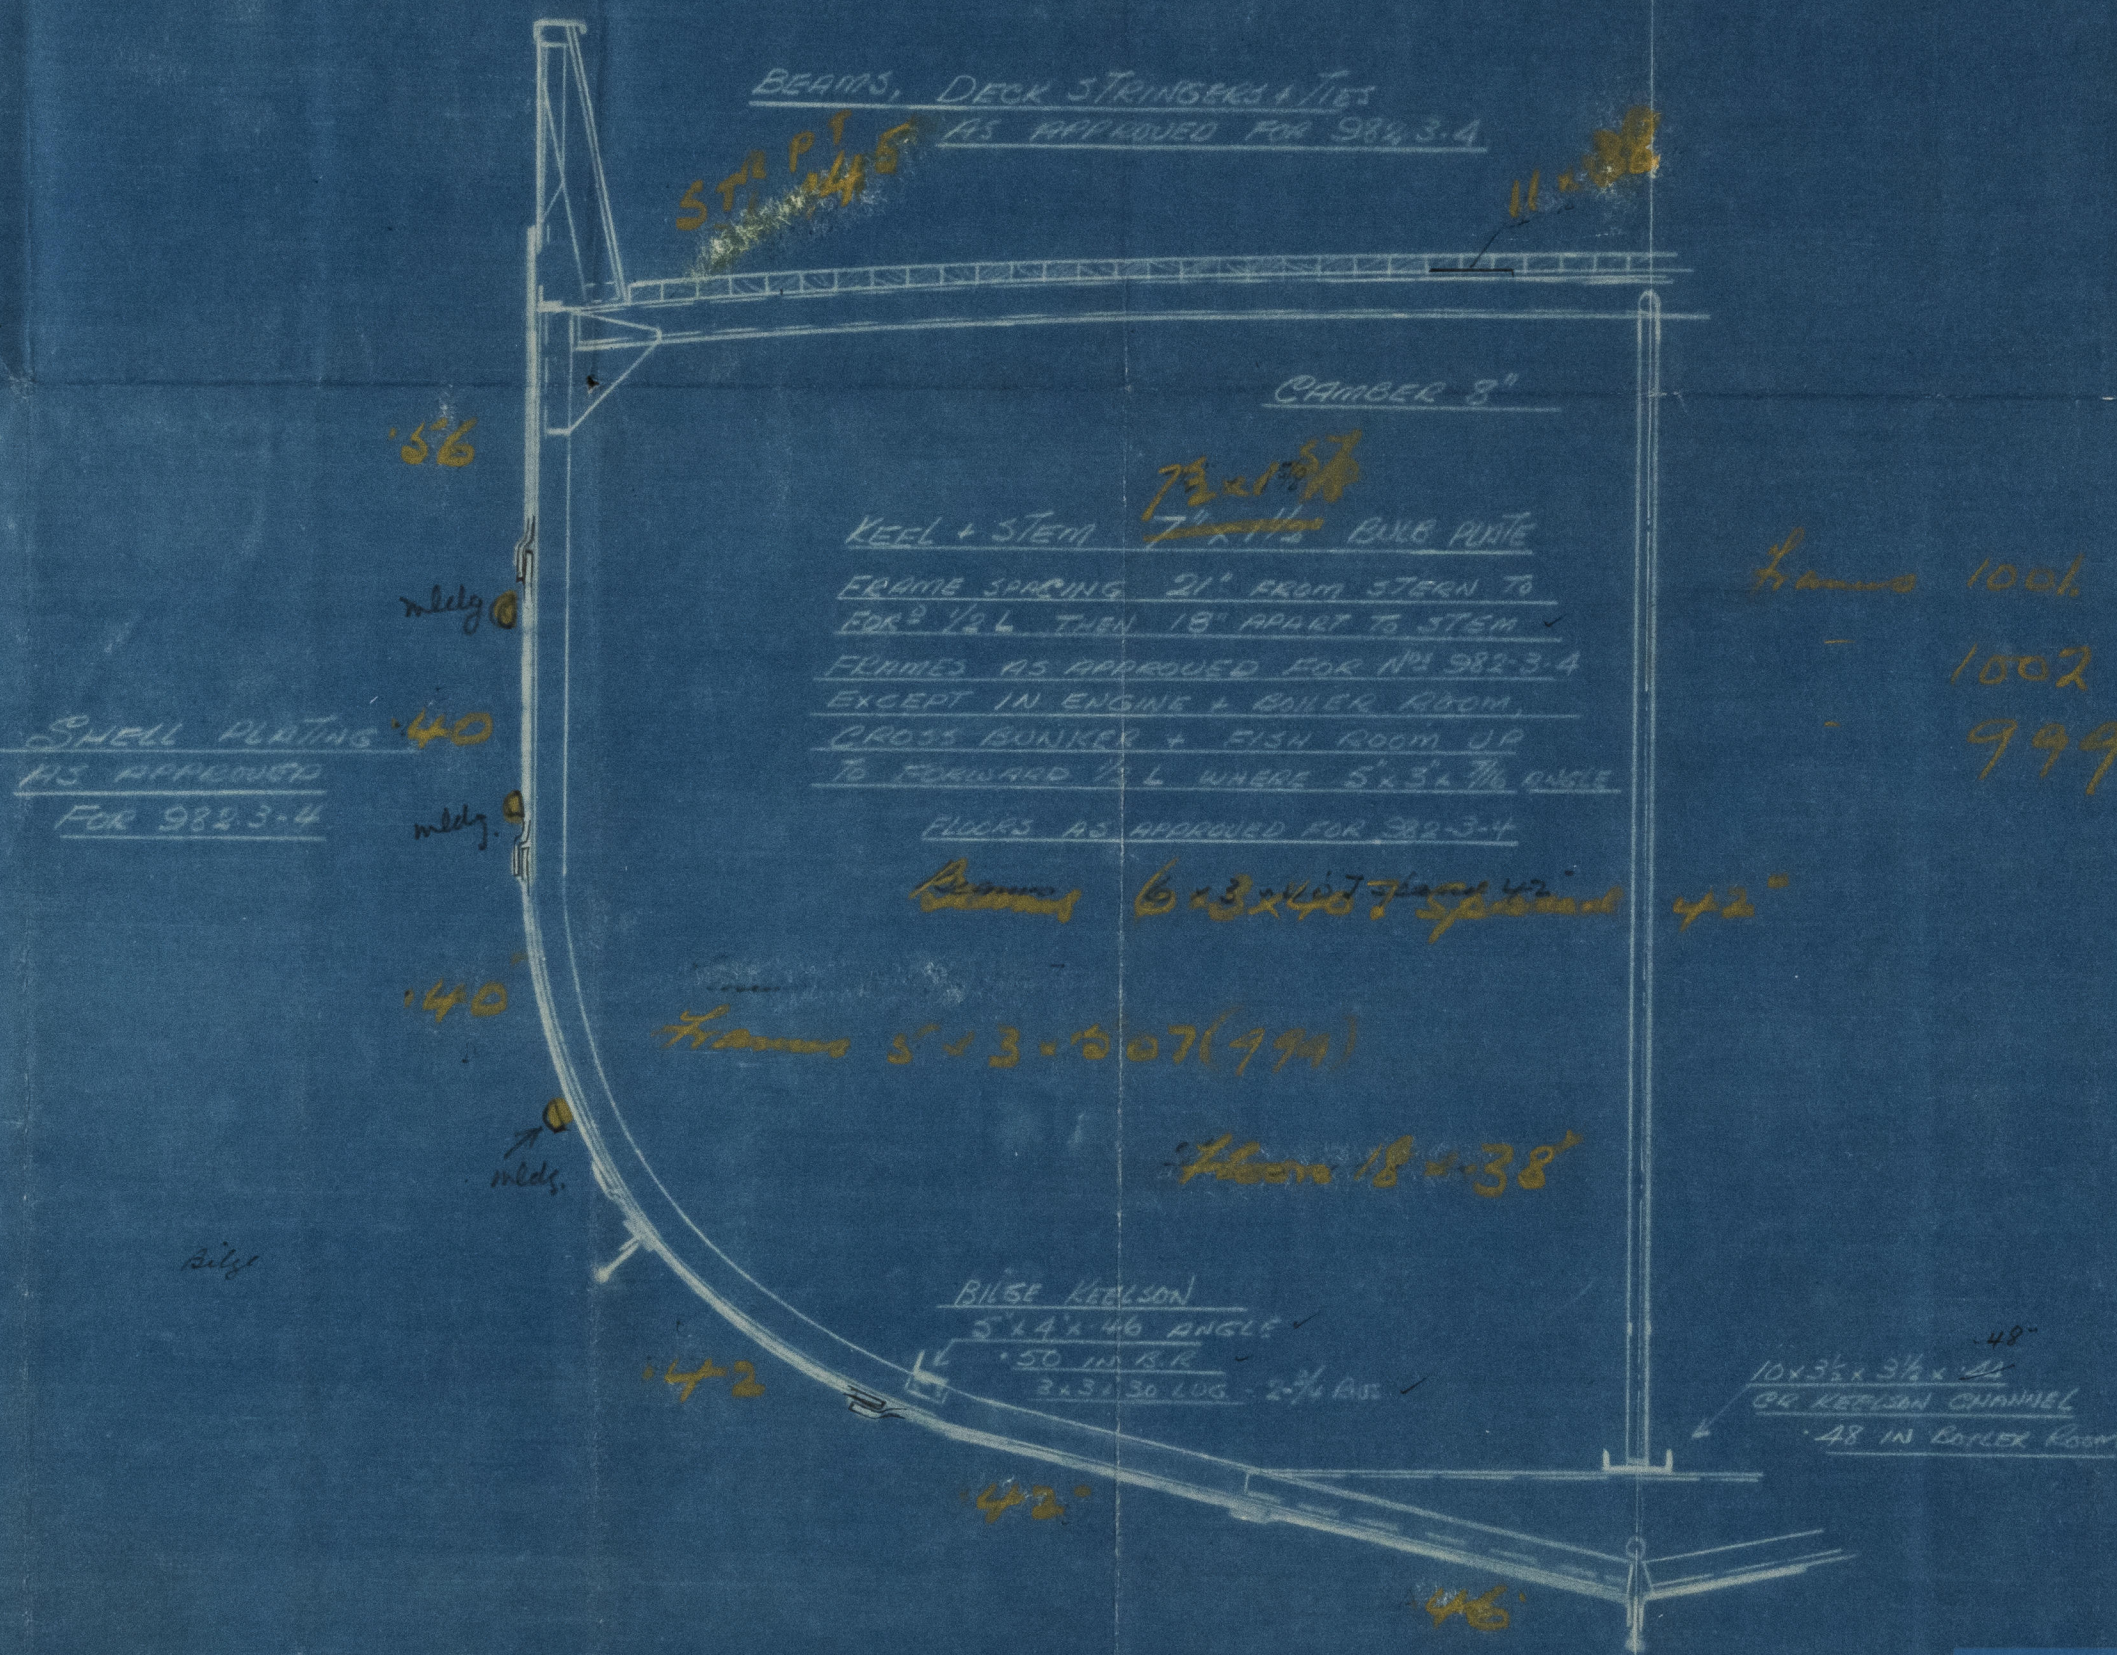

Frames 1001 6 x 3 x 7 1/6,
1002 6 x 3 x 7 1/6
999 5 x 3 x 5 0

SMITH'S DOCK CO LTD
SHIPBUILDERS & ENGINEERS
SOUTH BANK ON TEES
ENGLAND

As built in yellow




Royal Institution of Naval Architects
FOUNDED 1816

SMITH'S DOCK CO.

MIDSHIP SECTION

Nº 1001-2

Nº 999
999

999  S.S. "Indian Star."
MDB. RPT. No. 15773

1001 - Melbourne

1002 - Hildenhall

© 2021

Lloyd's Register
Foundation

W1634-0198