

SHIP N^o 330.

MIDSHIP SECTION

DIMENSIONS: 460'-0" B.P. x 61'-0" MLD. x 33'-3" MLD TO UPPER D^k.

SCALE: 1/2" = 1 Foot

LLOYD'S NUMERALS


1st Longitudinal N^o L x D 460'-0" x 33'-25" = 15295.00
 2nd " " L x (B+D) 460'-0" x (61'-0" + 33'-25") = 43355.00
 1/2 to Upper Deck = 460'-0" x 33'-25" = 13.83
 D = 33'-25"

To Class 100A.1 at Lloyds carrying Petroleum in Bulk.
 "Longitudinal Framing at Bottom and at Deck."

2nd Longⁿ N^o L x (B+D) = 43355.00
 Poop 105'33" x 7'5" x 7'4" = 592.50
 Bridge 43'16" x 7'5" x 7'4" = 248.70
 Forecastle 58'5" x 7'5" x 7'4" = 216.57
 House on Poop Deck 88'5" x 7'5" x 7'4" = 309
 House " Bridge " 120' x 7'5" x 7'4" = 450
 Equipment N^o 43165.77

2 Bower Anchors 73 1/2 Cwts Each Stockless.
 1 Stream " 22 " Ex Stock
 240 Fathoms 2 1/2 Stud Chain Cable (Tayco)
 120 " 5 Flexible Steel Wire 6x12
 130 " 5 1/2 Special Flexible Steel Wire 6x24
 2 Hawsers 100 Fathoms 2 1/2 Steel Wire 6x12
 2 Warps 100 " 2 1/2 " " 6x12

Long ⁿ Bld N ^o After Tank	Shear at Cr. of Tank	Plating	Stiffers
N ^o 2 to 6	as on Plan	+ .01"	—
" 7	1'-2 1/8"	+ .01"	—
" 8	2'-9"	+ .01"	—
" 9	4'-2"	+ .02"	—

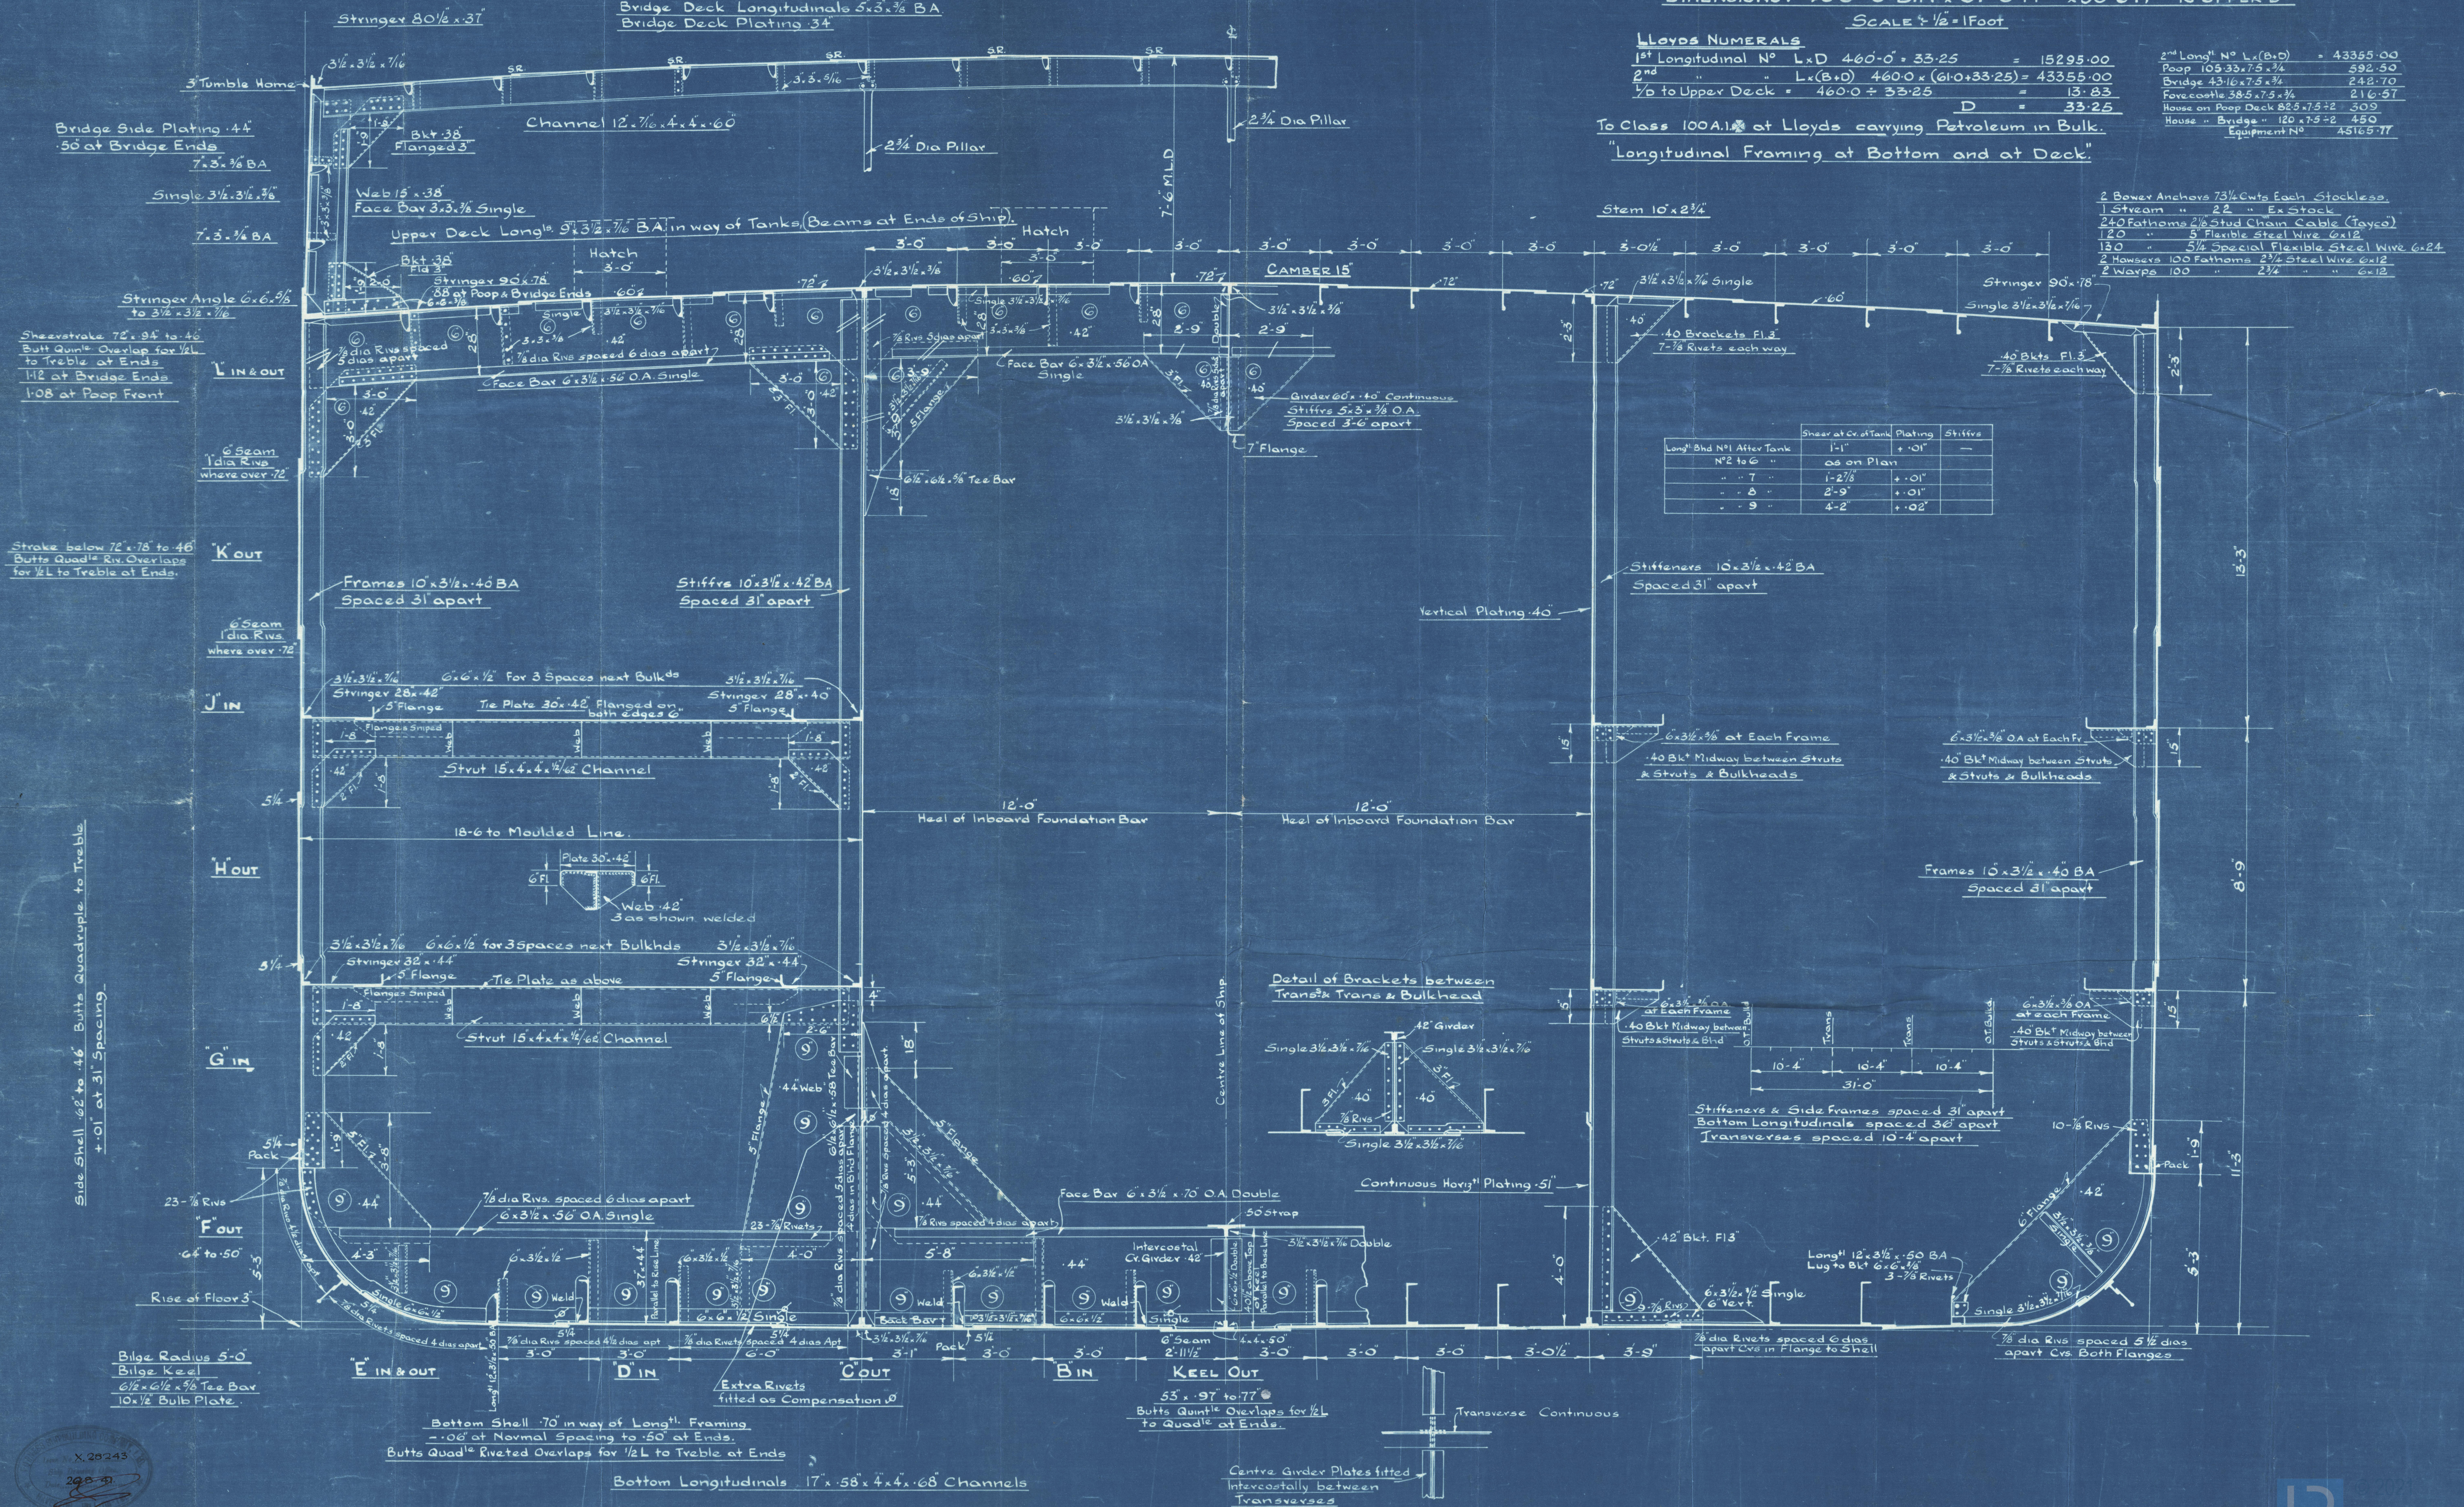

1.08 at Poop

Stroke below
Butts Quadle R
for 1/2 L to Treble

ts Quadruple to Treble

FURNESS, S. B. CO LTD

Nº 330

EMPIRE AMETHYST

MIDSHIP SECTION

AS BUILT.

Modb. 17097.

W165-0174



© 2021

Lloyd's Register
Foundation