
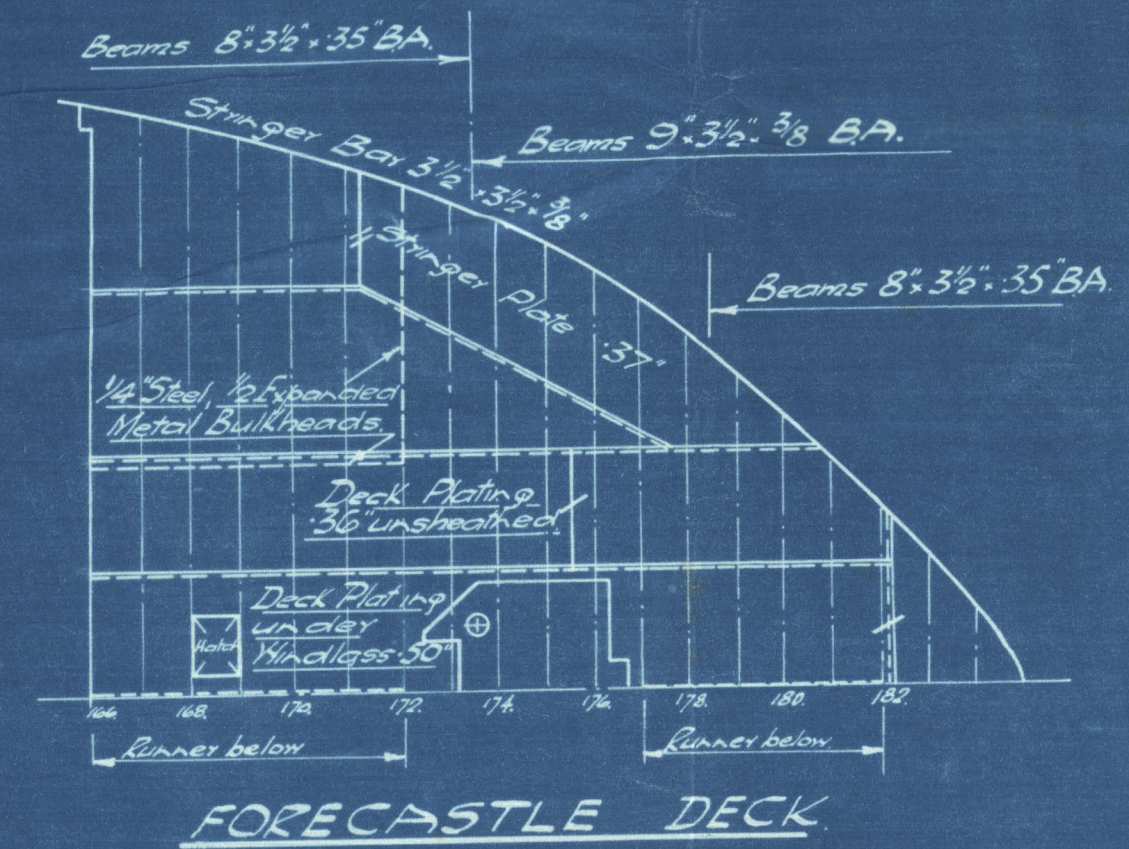


SCALE $\frac{1}{8}'' = 1 \text{ FOOT}$

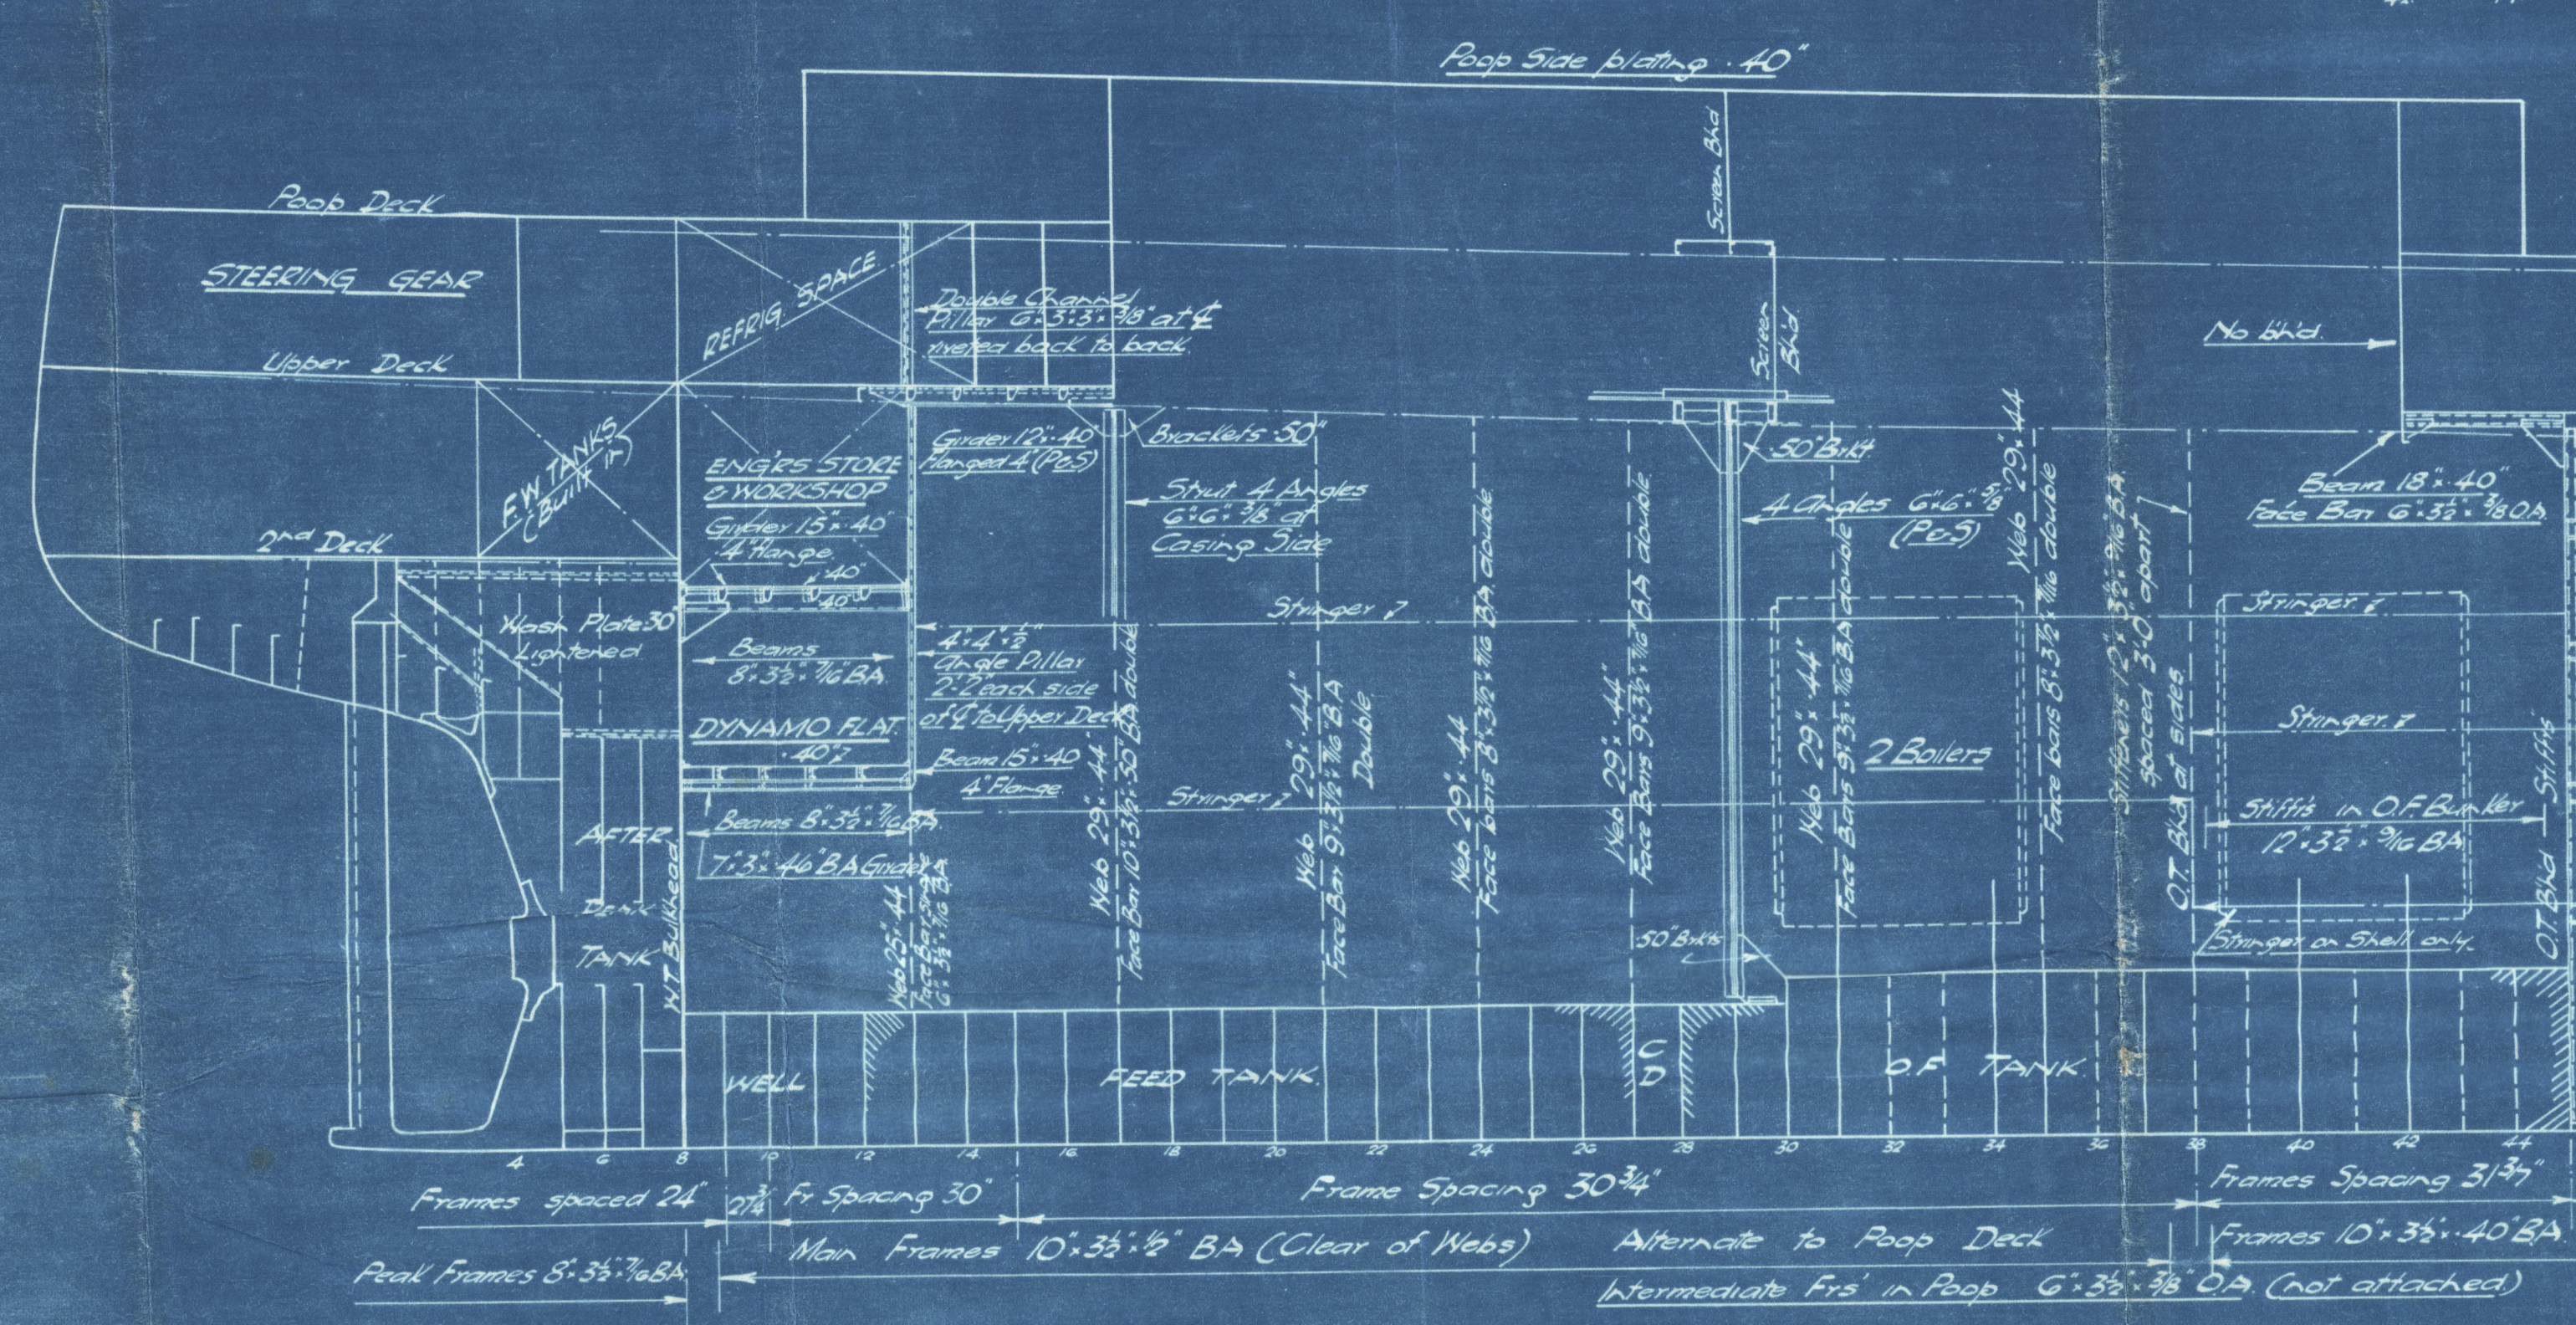

IN WAY OF OIL

RIVETING 1 Dia Rivets in Butts of Stringer Plating spaced 4 dia apart (Thickness .74 & above)
7/8" All Seams & Butts of Deck plating spaced 4 dia apart (Thickness .72 & under)

FURNESS, S. B. & CO^{TD}

N^o 330.

EMPIRE ANIETH-ST.

PROFILE & DECK PLAN

AS BUILT

Mod. 17097.

W165-0175



© 2021

Lloyd's Register
Foundation