


NOTE

THE STRENGTHENING & DETAILING OF CONSTRUCTION NOTED HEREON ARE SUBMITTED ON THE UNDERSTANDING THAT THEY ARE THE DESIGNER WHICH WILL BE ACCEPTED FOR CLASS, & IF NOT THEY MAY BE AMENDED, DELETED & OMISSIONS EXCEPTED

PLAN OF HATCHES, BULKHEADS, TUNNEL,
DECK GRIDDING & BOTTOM STRENGTHENING FOR #
WILL BE SUBMITTED LATER.

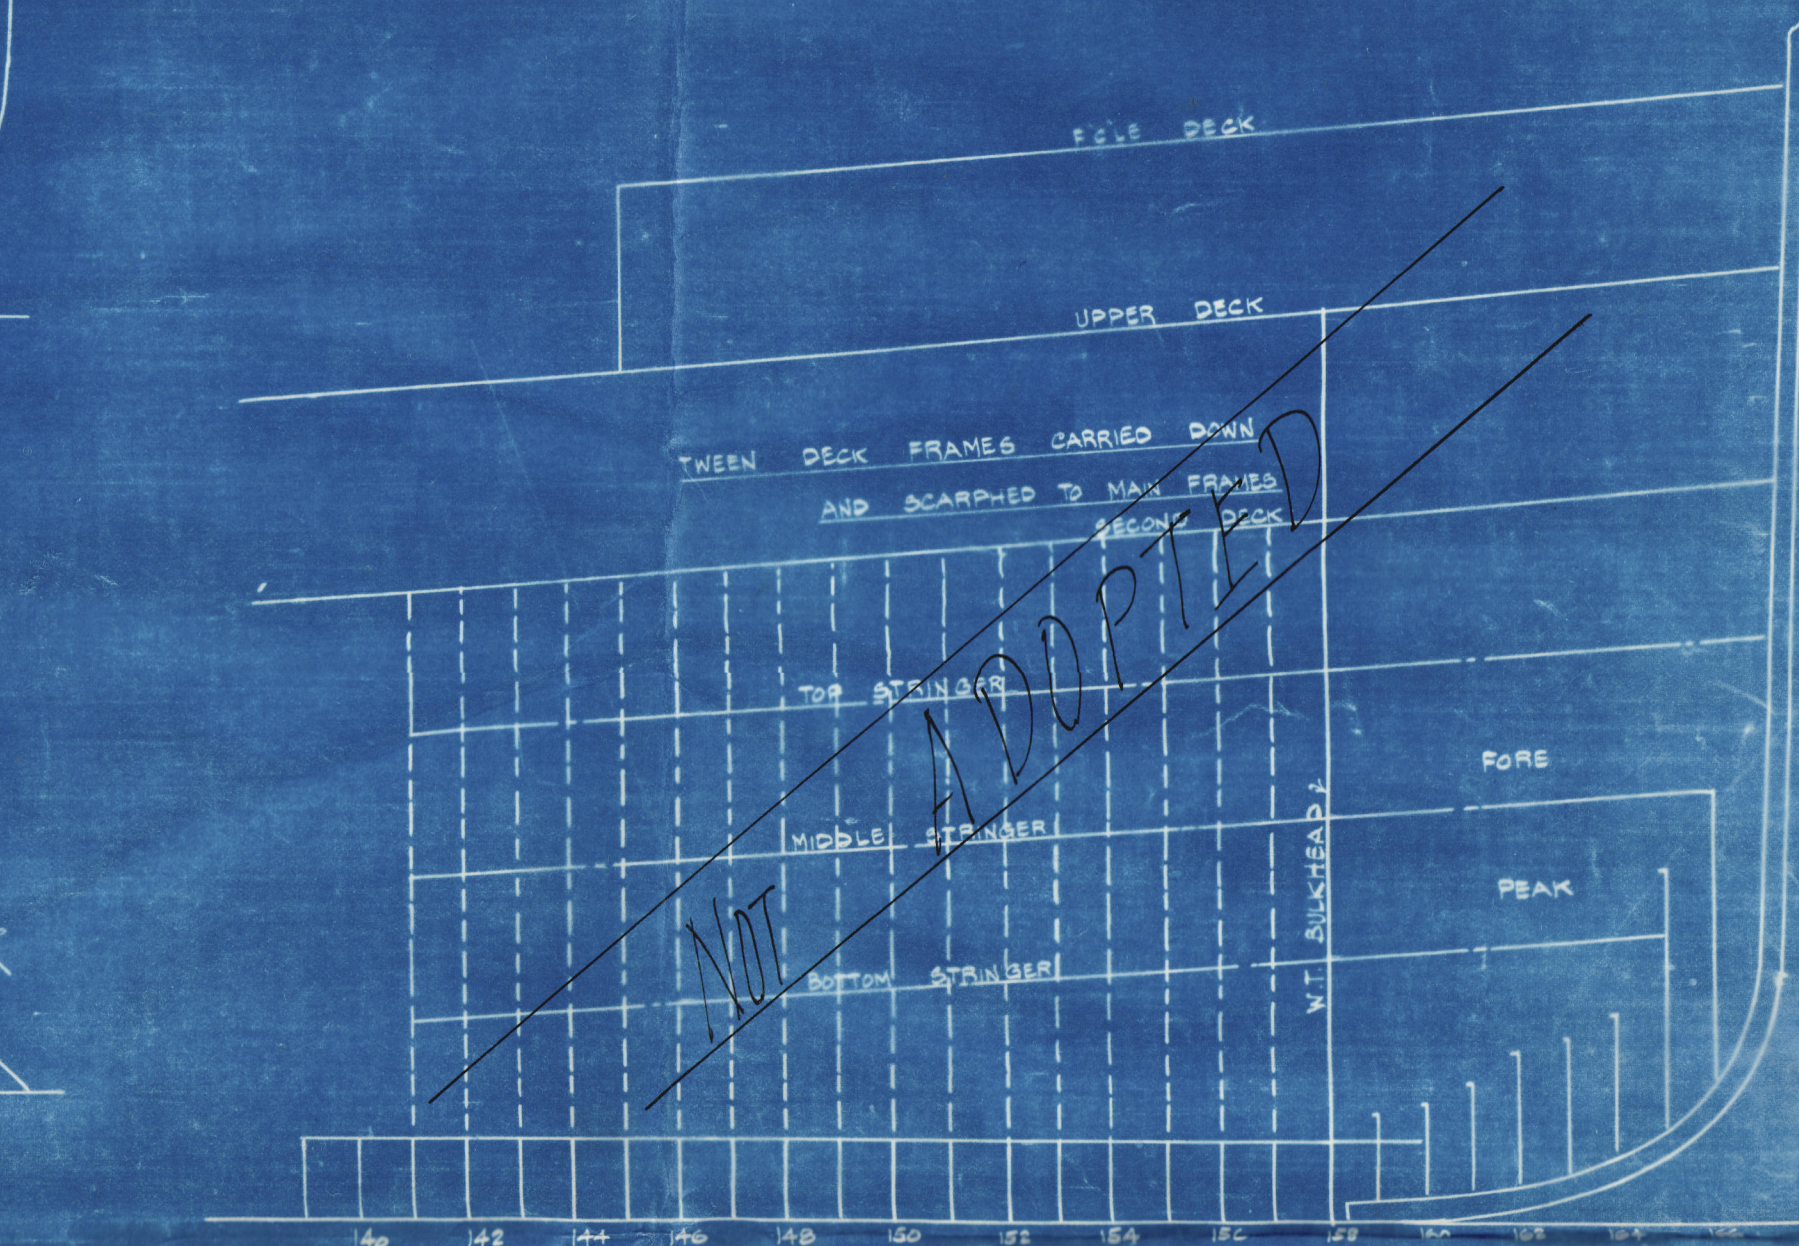

LITHGOWS LTD

No 784.

S.S. "MARGOT"

PROFILE & PECKS.

(AS BUILT).

GREENOCK REPORT No. 18626.



© 2019

Lloyd's Register
Foundation

W194-0168