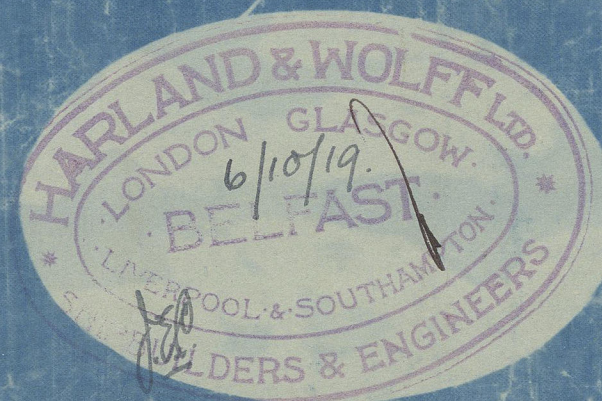


ELEVATION.

N TYPE

$$B + D = 55.46 + 30.04 = 85.50$$


Harland & Wolff Ltd.

Midship Section

as built.

Nº 558 New Toronto

Nº 559 New Texas

W.S. 246

Bel. 8224.

W1199-0115



© 2021

Lloyd's Register
Foundation