

No 46 MIDSHIP SECTION

DIMENSIONS: 405' B.P. x 53'9" M.L.D. 34'-0" TO SHELTER DECK
SCALE 1/2" = 1' FOOT



SHEER FOR FREEBOARD

STEM	115"
1/8 TH FROM STEM	62 1/4"
MIDSHIP	0"
1/8 TH FROM POST	27"
POST	49"

TRANSVERSE NUMBER $53.75 + 26 = 79.75$
 LONGITUDINAL " $79.75 \times 405 = 32298.75$
 PROPORTIONS $405/34 = 11.91$ TO SH.D.
 " $405/26 = 15.57$ " U.P.D.
 $d = 22' + 4'$


EQUIPMENT NUMBER:
 $(53.75 + 26) \times 405 = 32298.75$
 SHELTER-DECK $(405 \times 8) \div 3/4 = 2430.00$
 BRIDGE-DECK $150 \times 8 \div 3/4 = 900.00$
 POOP-HOUSE $56 \times 7.5 \div 1/2 = 210.00$
 BRIDGE-HOUSE $32 \times 7.75 \div 1/2 = 125.00$
 ENGINE ROOM ON BRIDGE $60 \times 7.5 \div 1/2 = 225.00$
36188.75

EQUIPMENT:
 2 BOWER ANCHORS 63 3/4 CWTs. STOCKLESS.
 1 " " 54 1/2 " "
 1 STREAM " 17 1/2 " EX. STOOK.
 1 KEDGE " 7 1/2 " "
 270 FATH. 2 1/4" STOD CHAIN CABLE 682-1-11 CW
 90 " 4 3/4" STEEL WIRE
 120 " 5 " "
 2 HAWSERS OF 8 ; 90 FATHOMS
 2 " 7 ; 90 "

BRIDGE-DECK

SHELTER-DECK

UPPER-DECK

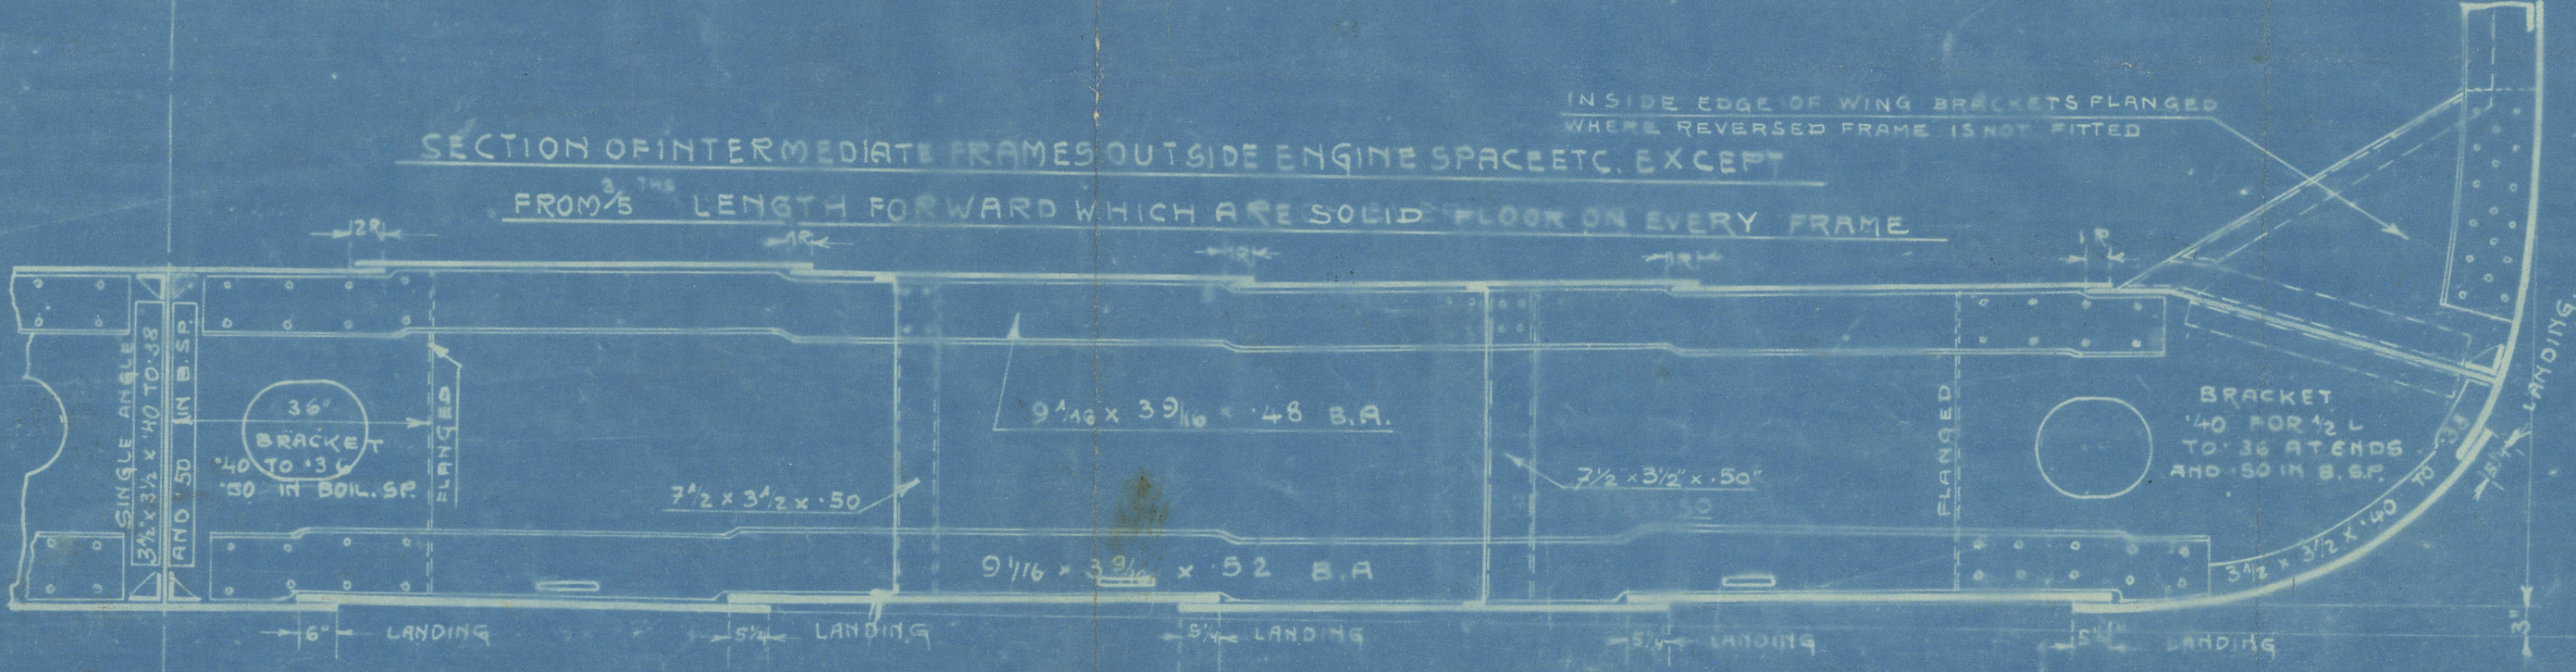


LENGTH OF OVERLAP SHELL BUTTS TO BE AS REQUIRED FOR 1 RIVETS

Midship Section (as built)

S.S. "Erny" "Dec 1895."

N.N. "Susana"

W220-0046

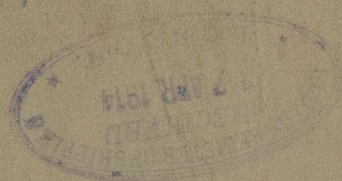

© 2019

Lloyd's Register
Foundation