


# S. S. No 471.



4699  
 471  
 18.3.10

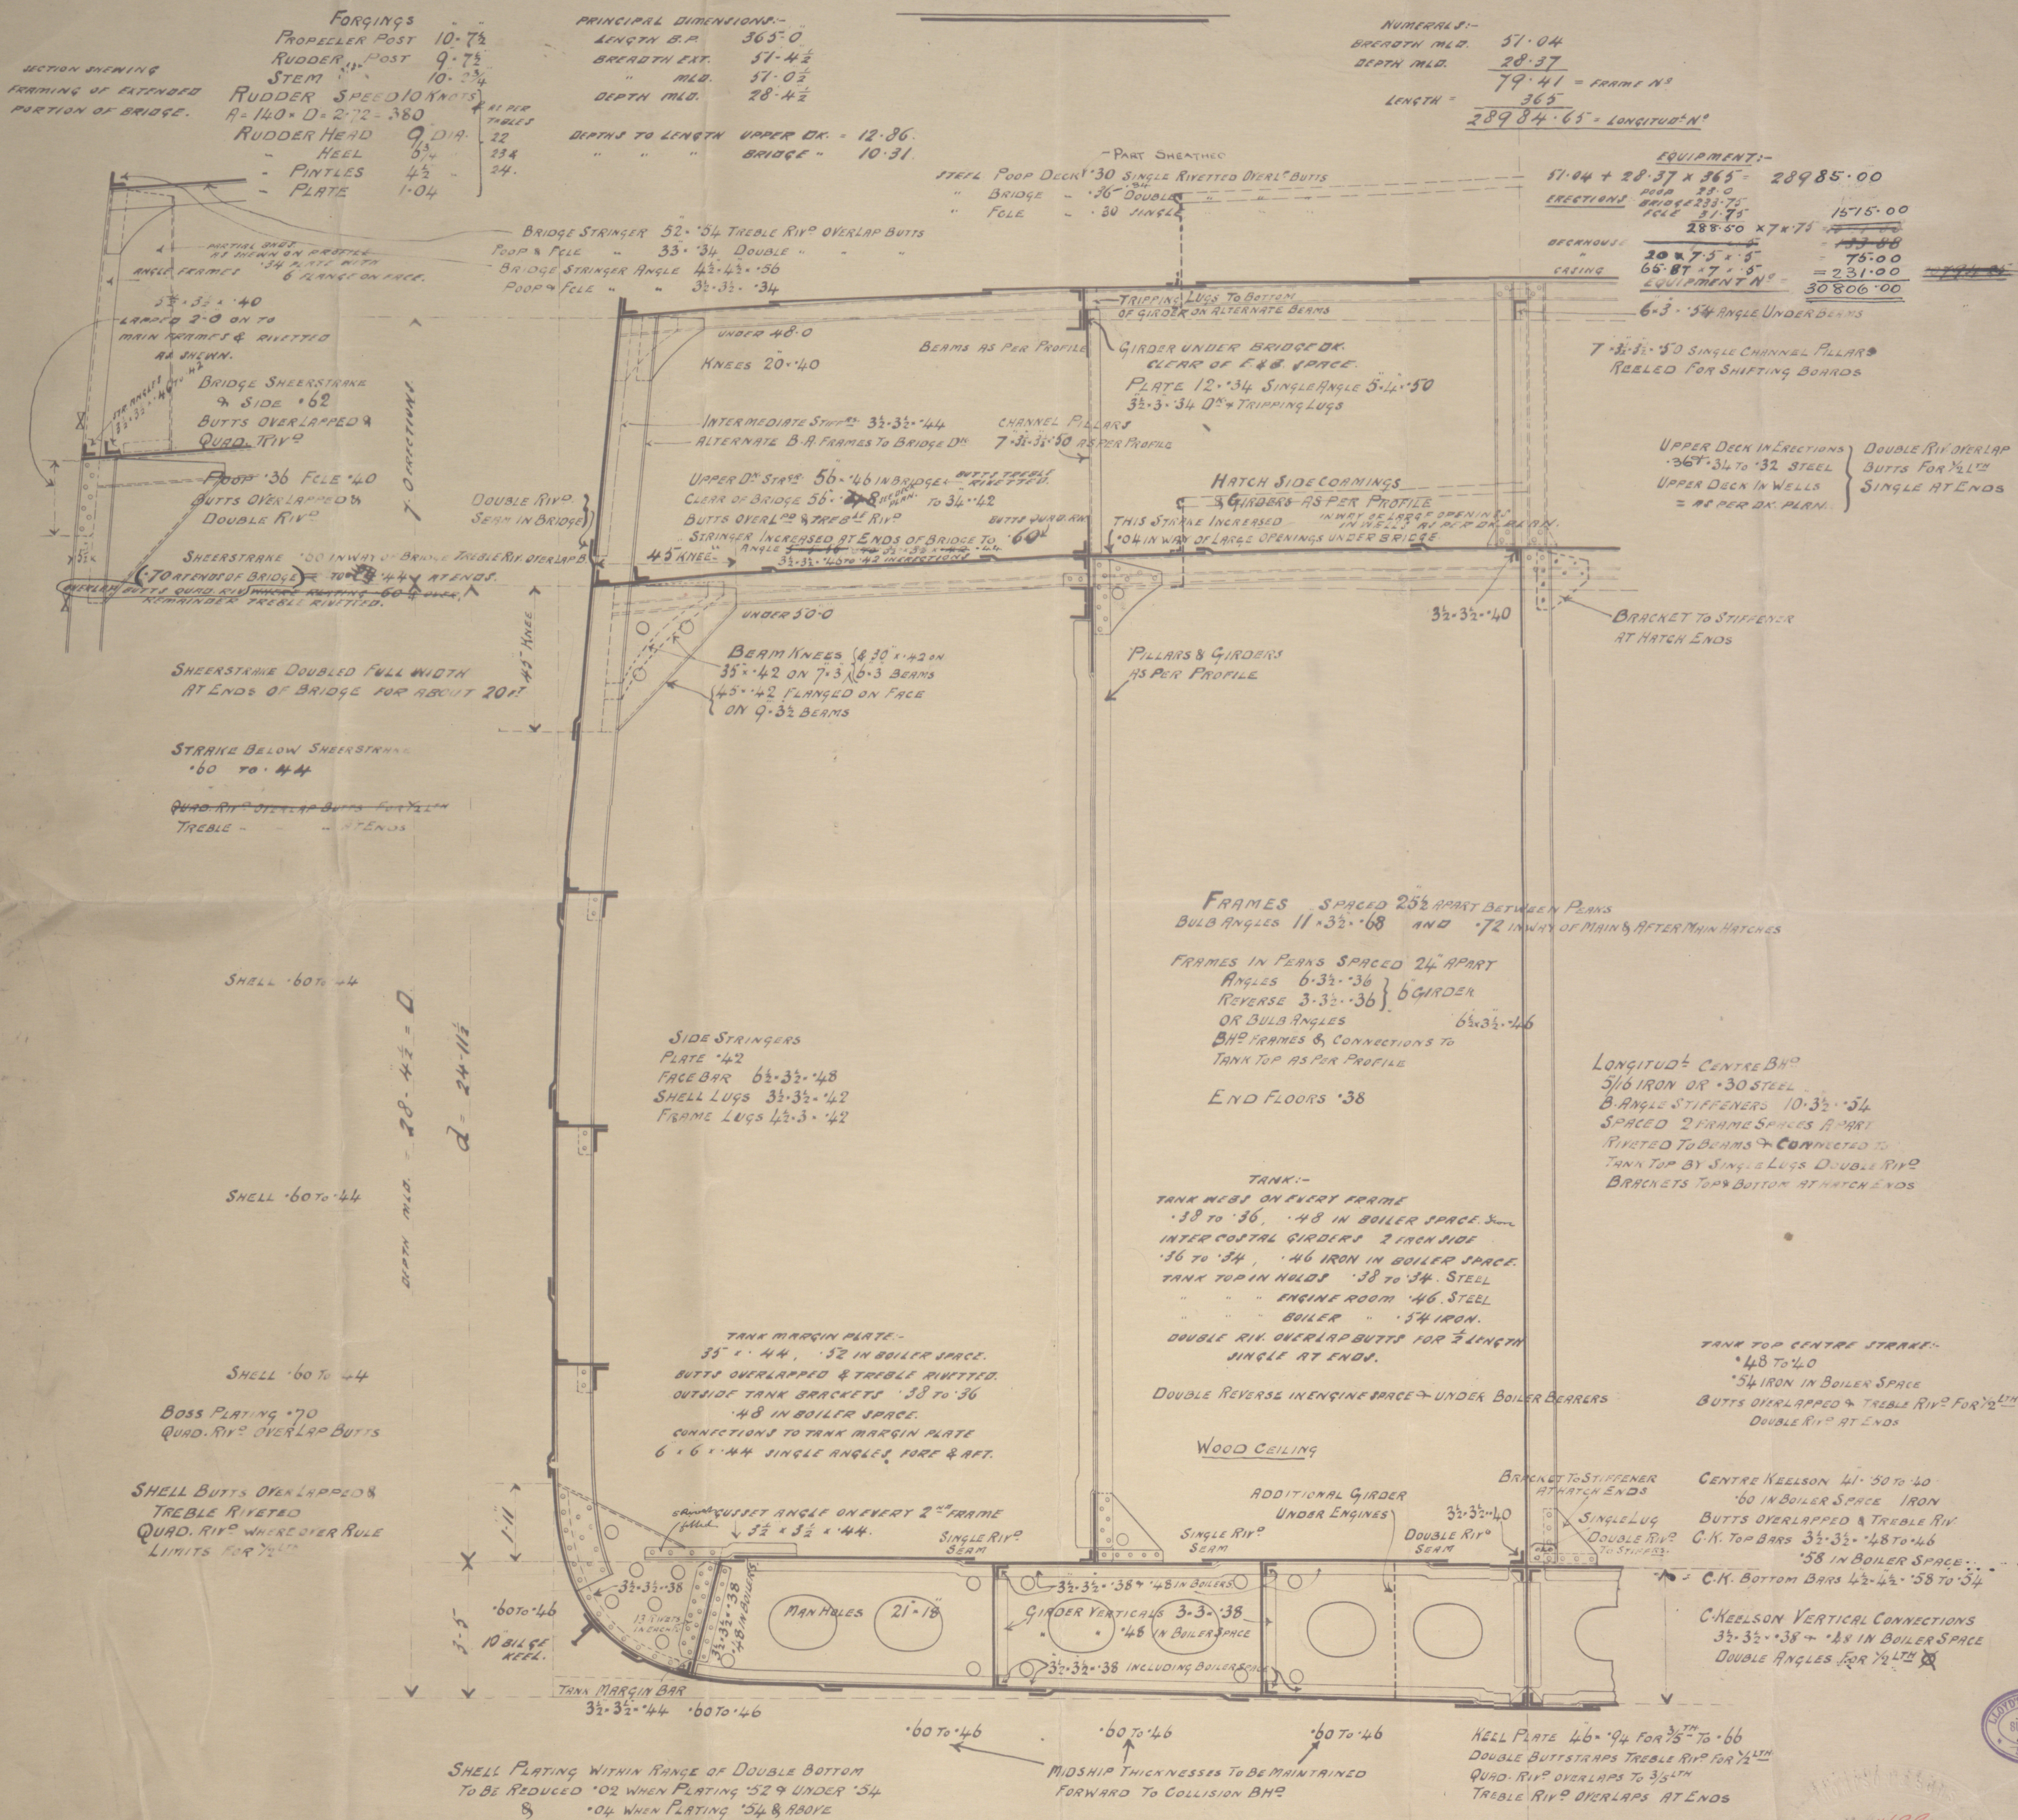

SECTION.  
*as built*

S.S. 471.

SS "Maresfield"

J L Thompson & Sons  
J " " Jd

Std Rpt 24383

Now named  
"Elisabeth Dal"

W241-0207



© 2019

Lloyd's Register  
Foundation