

EQUIPMENT.

2 BOWER ANCHORS 10 1/2 CWT. EA. STOCKLESS.
1 BOWER ANCHOR 8 3/4 CWT. STOCKLESS.
1 STERN ANCHOR 3 1/2 CWT. EX. STOCK.
165 FMS. 1 1/8" STEEL LINK CABLE.
60 FMS. 2 1/2" STEEL WIRE ROPE.
75 FMS. 2 1/2" STEEL WIRE ROPE.
90 FMS. 2" FLEX STEEL WIRE ROPE.

L x (B+D) ----- 5880
DE. DK. 93 x 375 ----- 348.75
FL. LE. DK. 19 x 7 x 75 ----- 99.75
BR. DK. 9 x 25 x 8 x 75 ----- 54.8
AFT HOUSE 26 x 7 x 5 ----- 91
6474.3

Nos. 187 & 188.

MIDSHIP SECTION.

DIMNS: 160'-0" x 25'-6" x 10'-3" MLD.



SCALE: 1/2" = 1 FT.

TO CLASS 100 A.I. AT LLOYDS.

L x D ----- 1640.
L x (B+D) ----- 5880.
L/D ----- 15.6.
L/D AT DE. DK. ----- 11.4.

RIVETTING.

SHELL BUTTS & SEAMS D.R. THROUGHOUT.
STRINGER BUTTS D.R. UPPER DK 3 R. INSIDE 1/2 L.
CR. GIRDER BUTTS D.R.
KEEL BUTTS T.R. TO D.R. AT ENDS.
SHEERSTRAKE AT RAISED QUARTER & UPPER DKS. T.R. FOR 1/2 L. TO D.R.
STRAKE BELOW SHEERSTRAKE AT UPPER DK T.R. FOR 1/2 L. TO D.R.
3/4" DIA RIVETS.

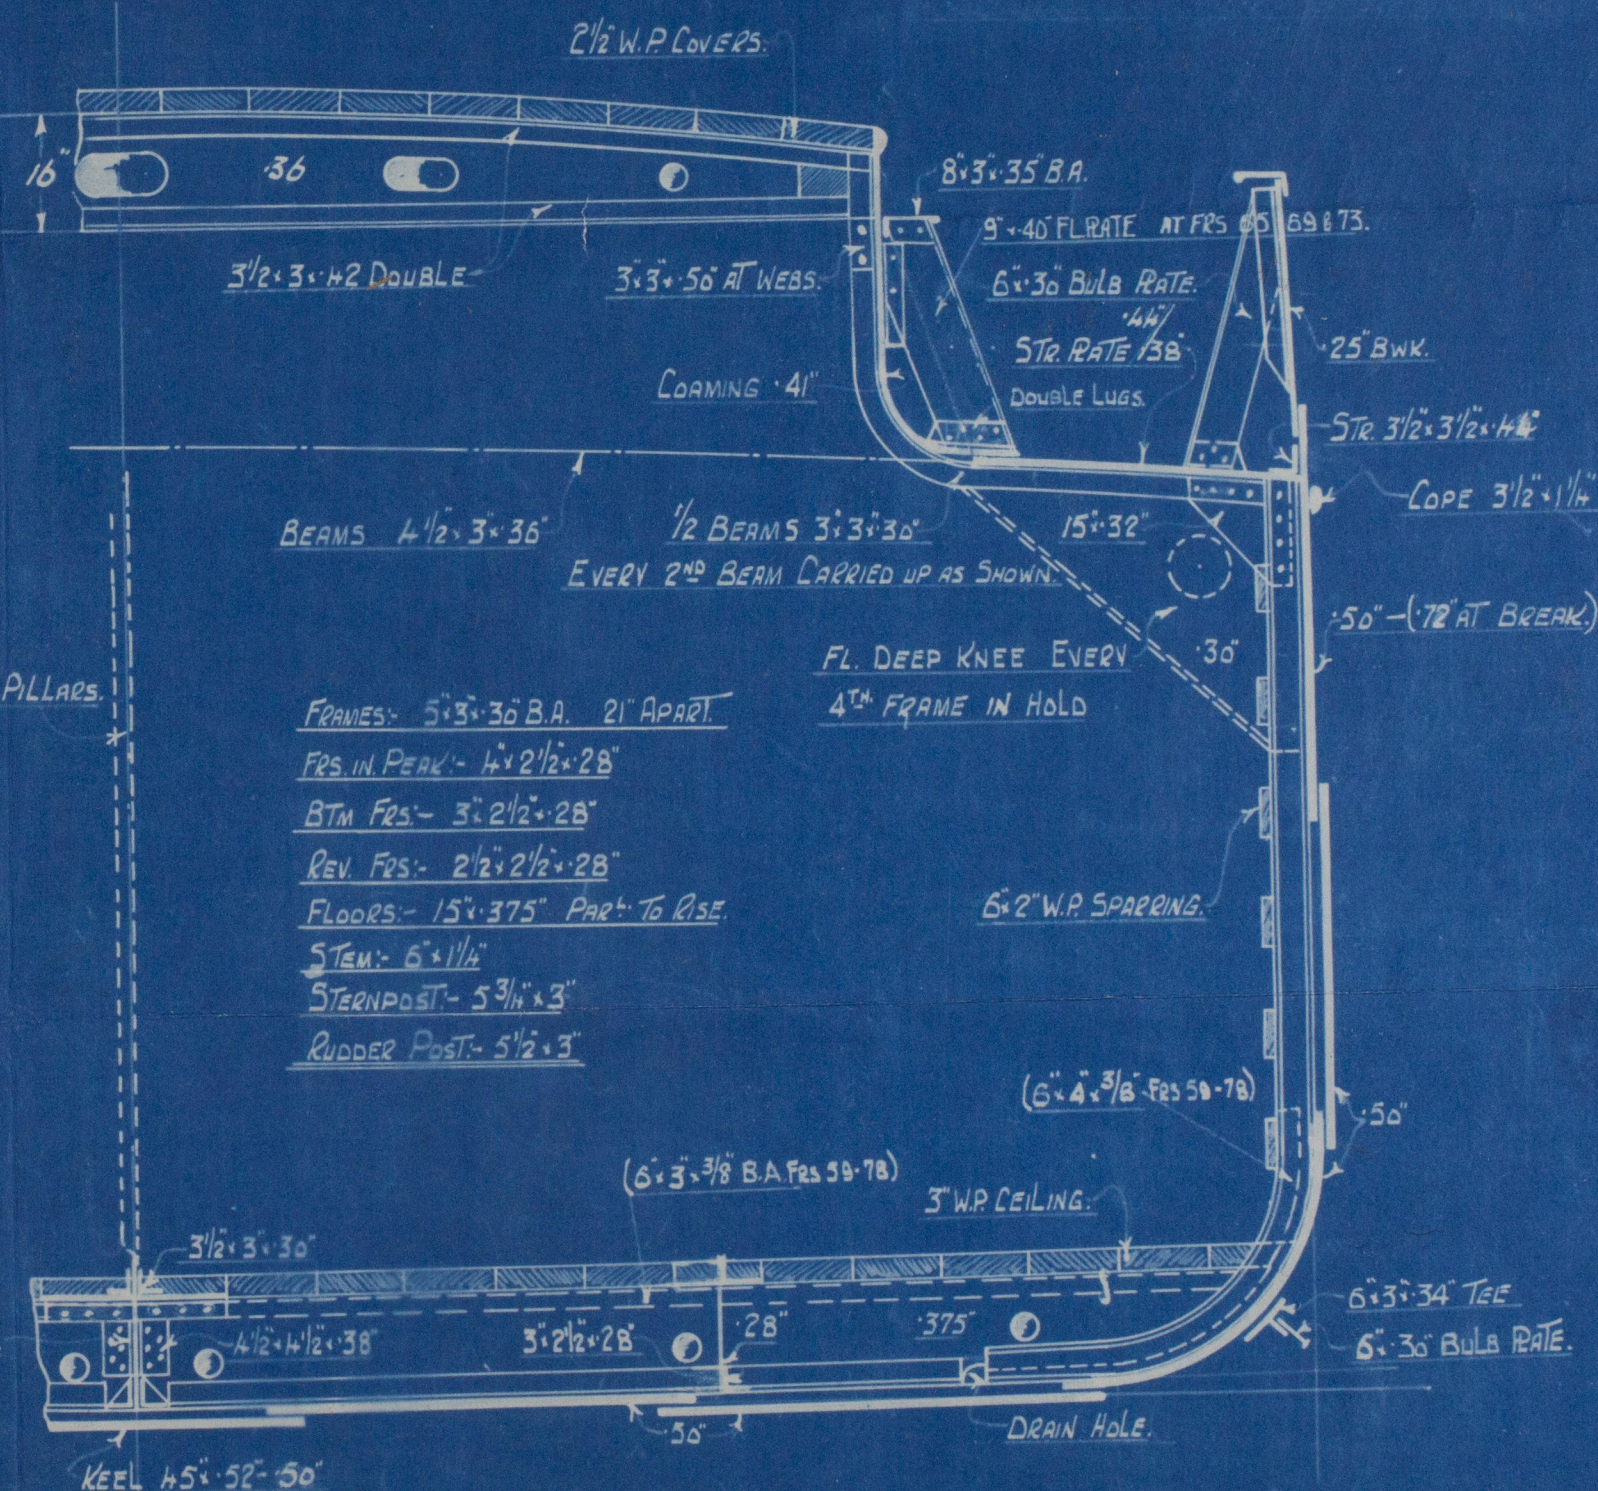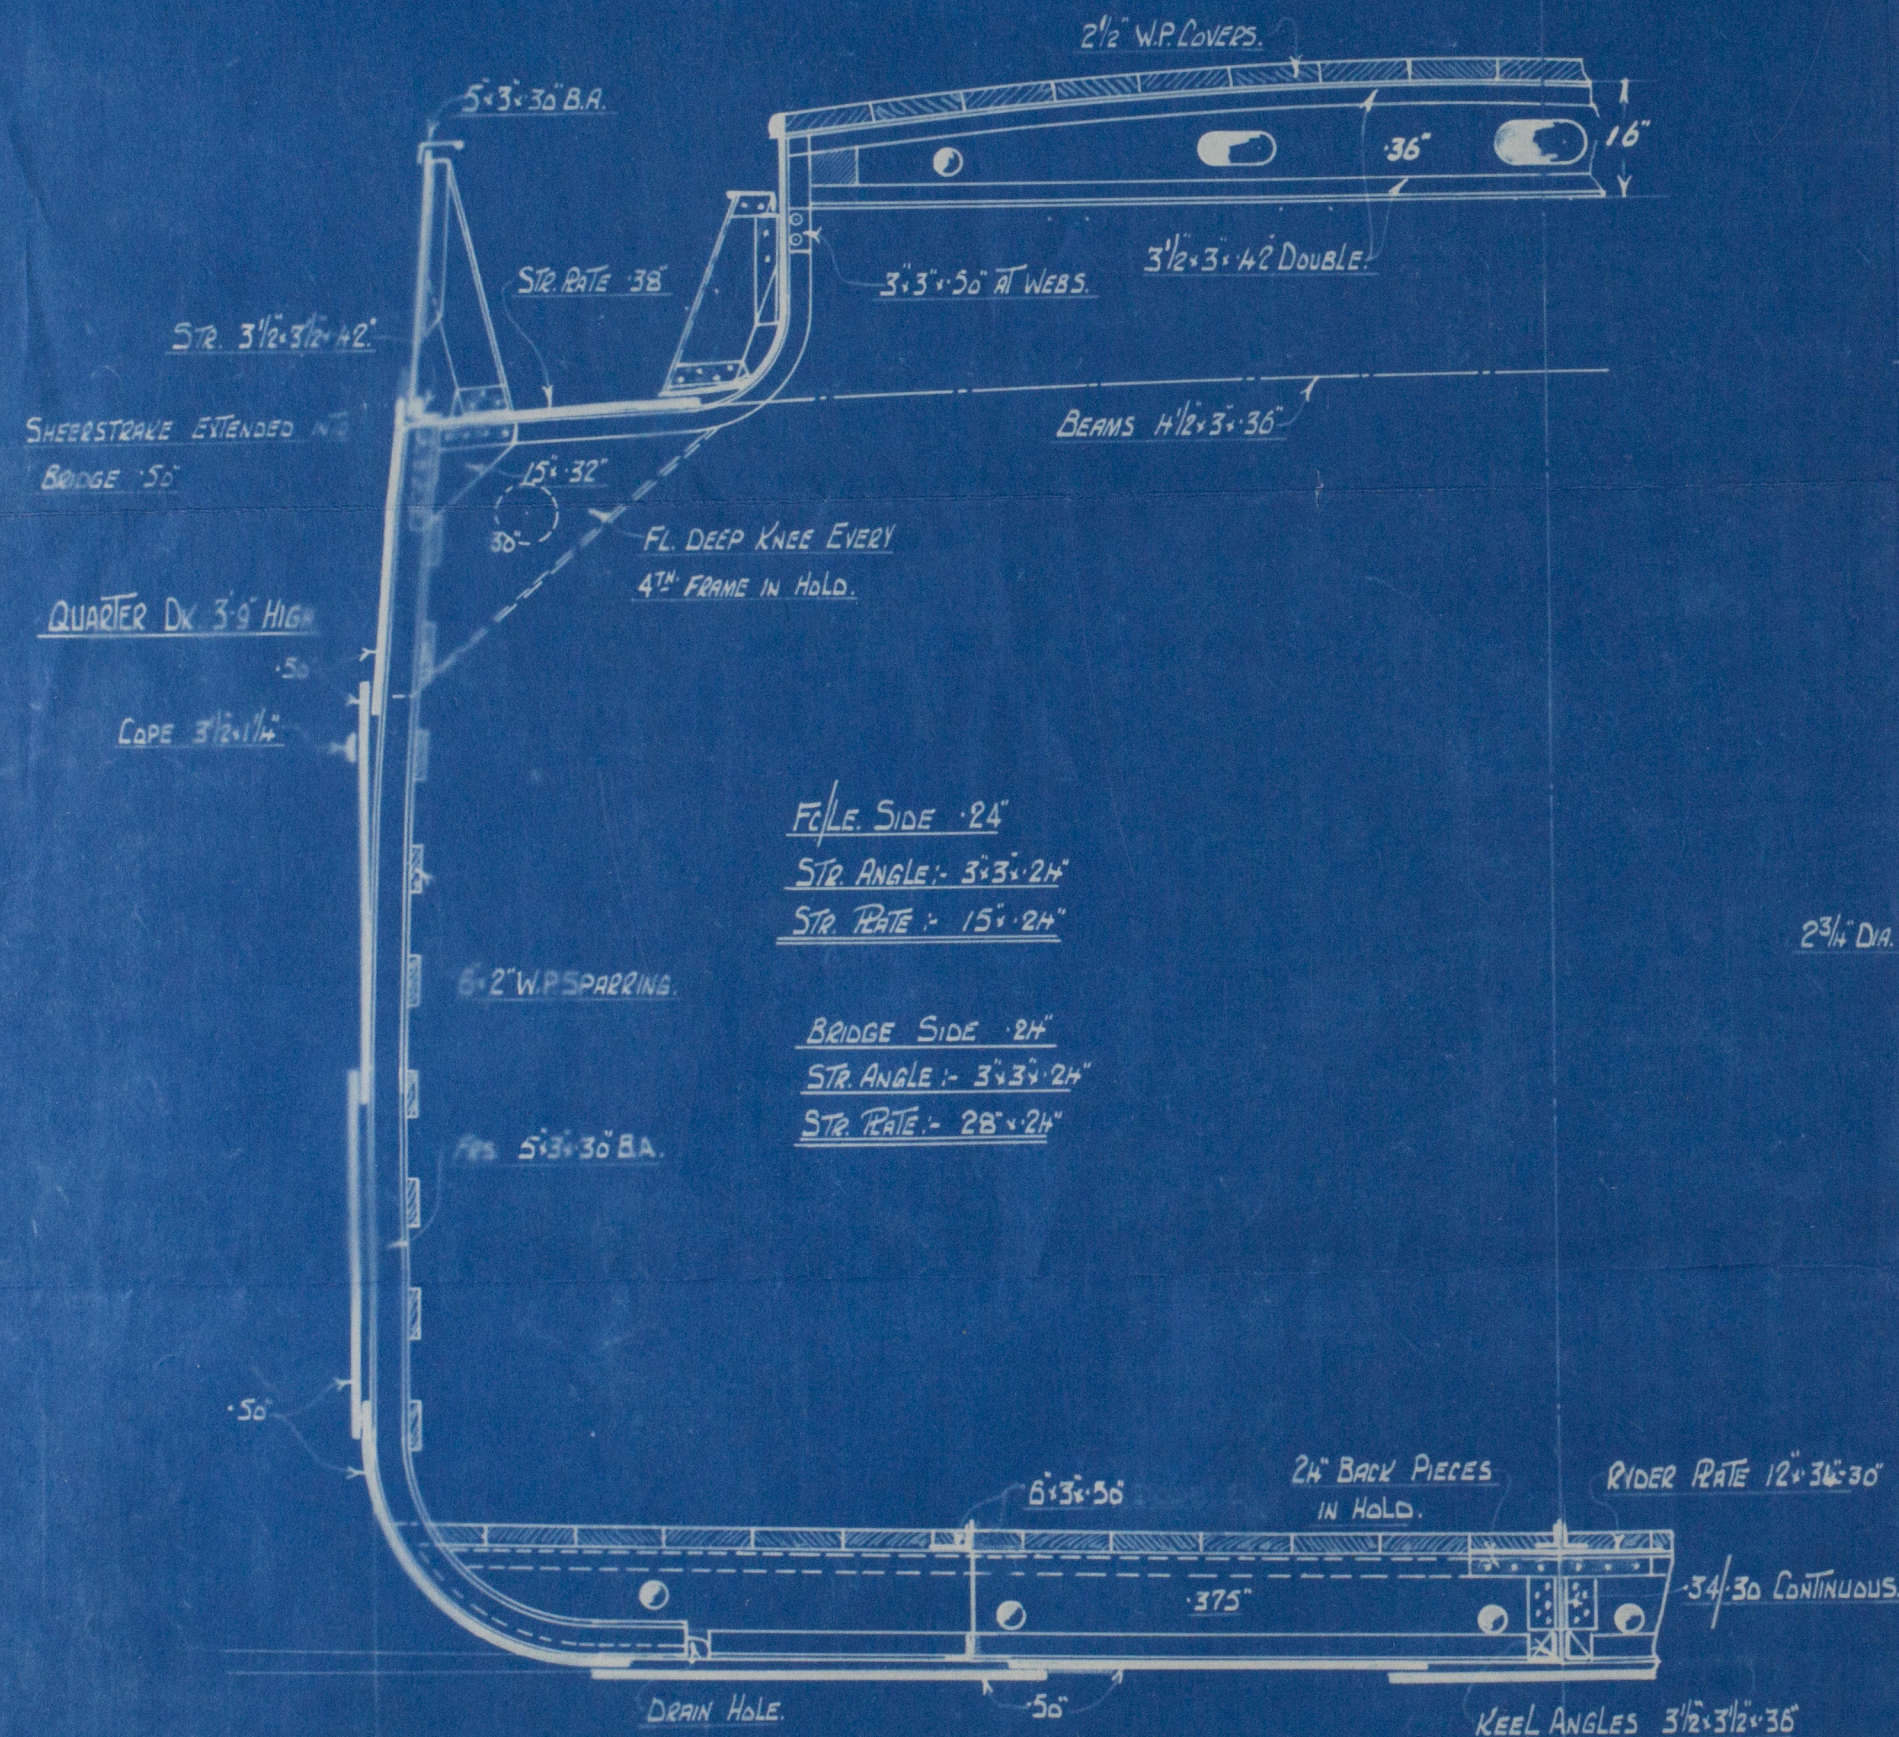

5208
18.9.34

M. V. GRIT

GEO BROWN & Co's

Nº188

MIDSHIP SECTION

As BUILT

GREENOCK FIRST ENTRY.

REPORT Nº19817



© 2019

Lloyd's Register
Foundation

W246-0140