

S. S. N° 384



PROFILE & DECK PLANS.

Scale 1/8" = 1 Foot.

DIMENSIONS- LENGTH B.P. 380'-0". BREADTH MLD 51'-8". DEPTH MLD 34'-0".

NOTE- GRAIN SHIFTING BOARDS FITTED IN HOLDS IN WAY OF HATCHES ONLY.

ALSO THROUGHOUT TWEEN DECKS.

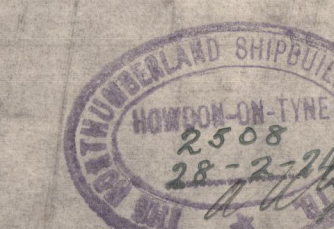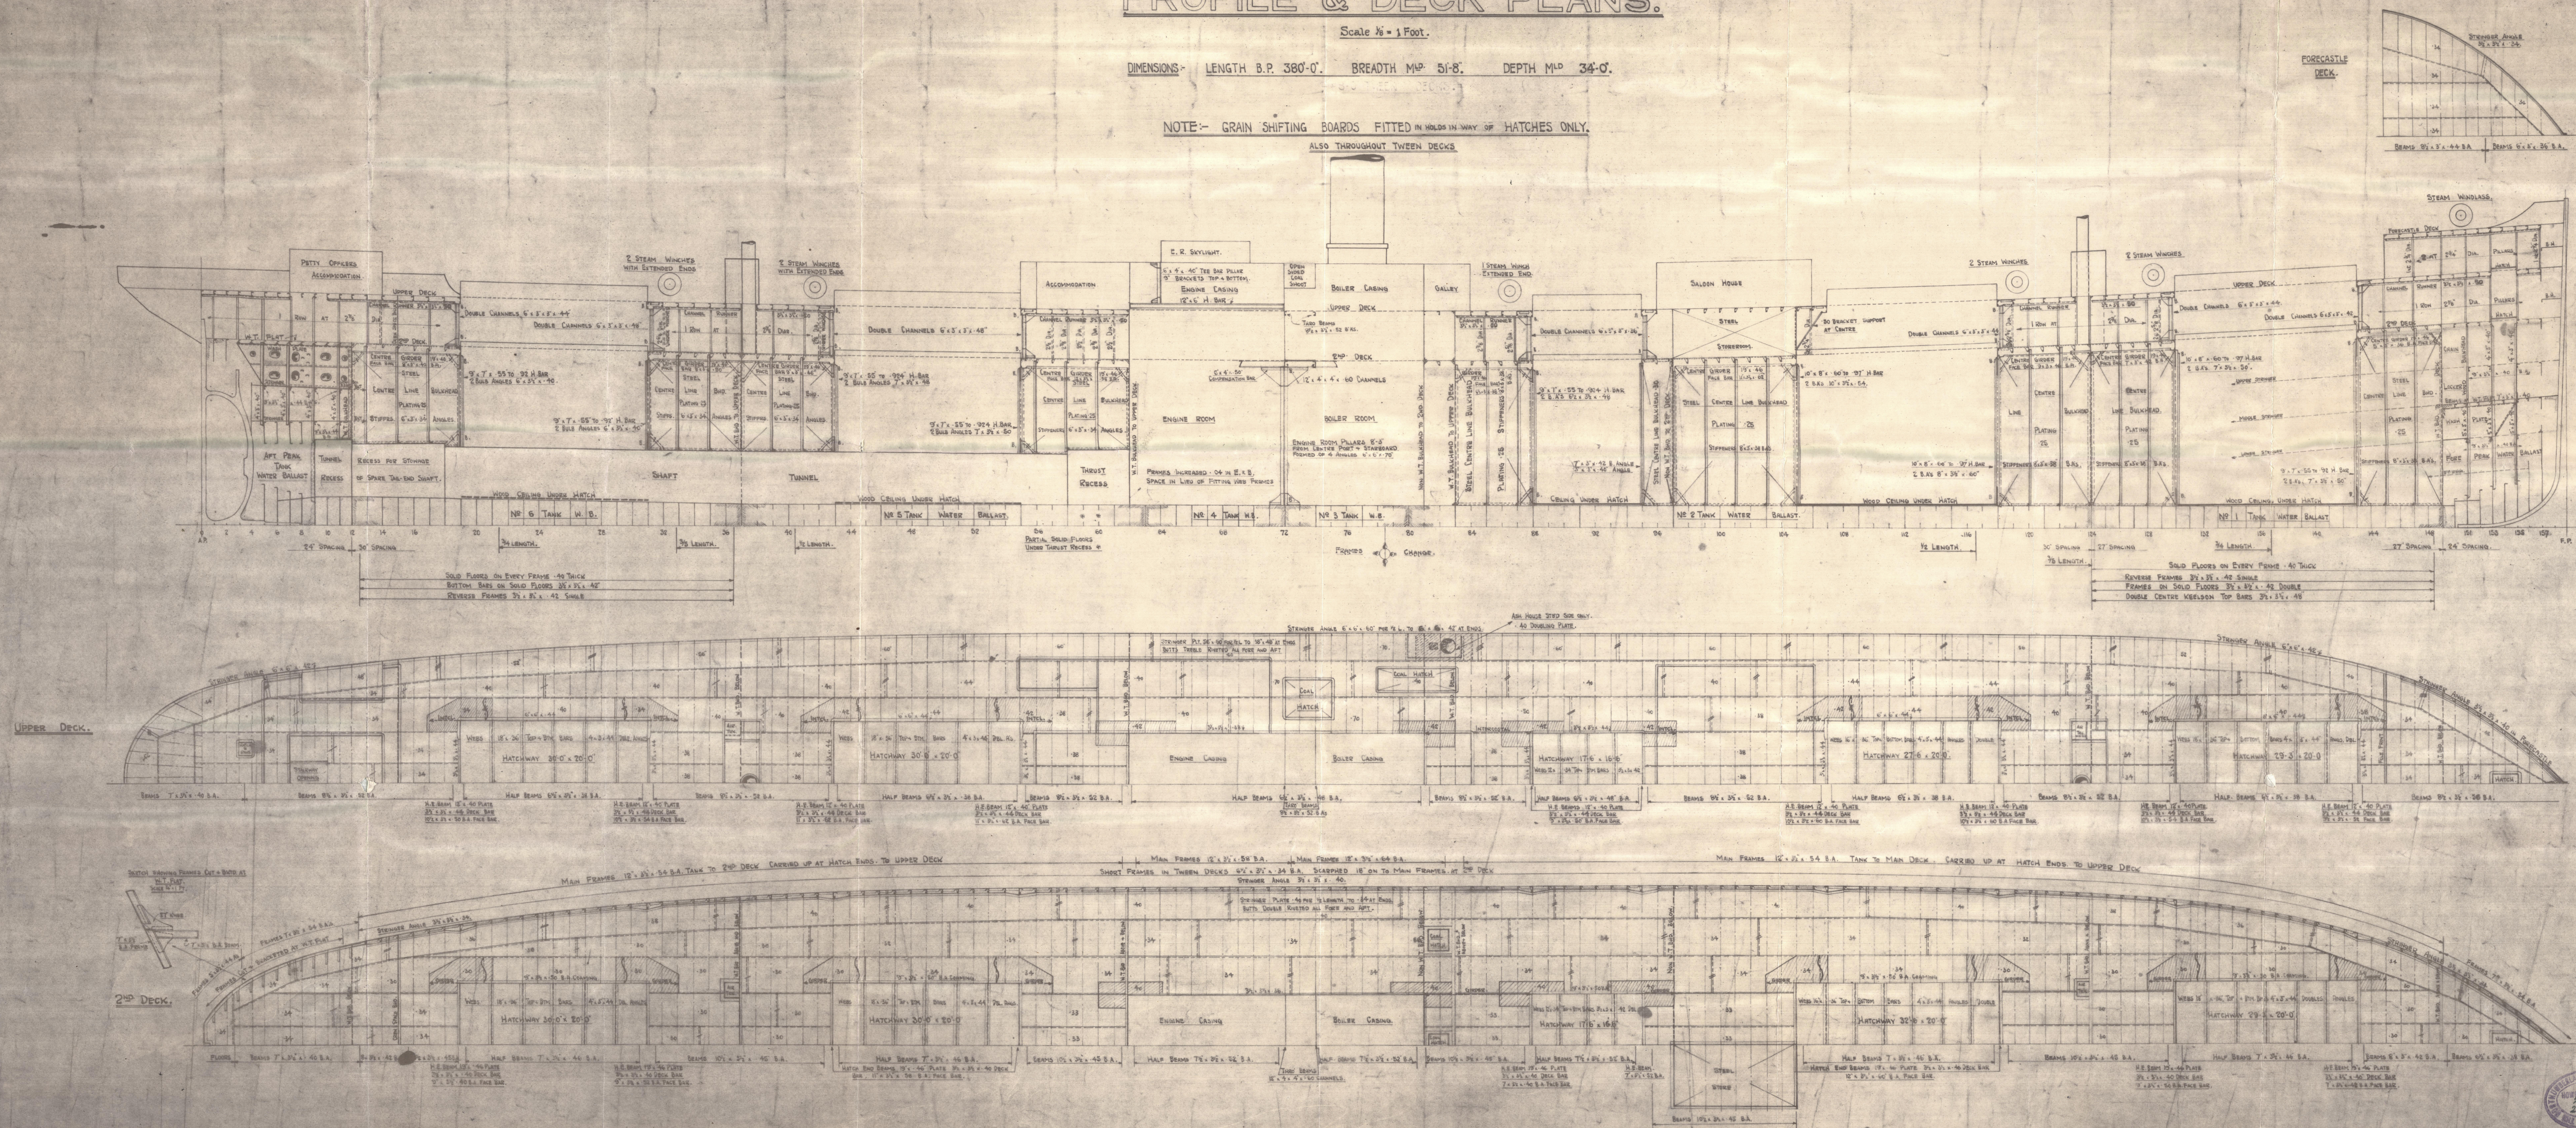

Messrs Northumberland S. B. Co Ltd

No 384


"Saltersgate"

S. S. "Overstone"

(As built.)

NEWCASTLE ON TYNE.

Report No. 47617.

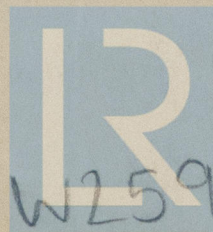

© 2020

Lloyd's Register
Foundation