

Lloyds NUMERALS for SCANTLING  
 $D = 44.08$   
 $L \times D = 535.0 \times 44.08 = 23582$   
 $L \times (B + D) = 535.0 \times (74.0 + 44.08) = 63172$



# Nos 189-190 MIDSHIP SECTION

DIMENSIONS: 535'-0" B.P. x 74'-0" MLD x 48'-9" MLD. UPPER DECK

SCALE 1/2" = 1'00"

NOTE: ALL BULB ANGLES ARE NEW BRITISH STANDARD SECTIONS.

LOAD DRAFT OF 33'-2" TO BOTTOM OF KEEL

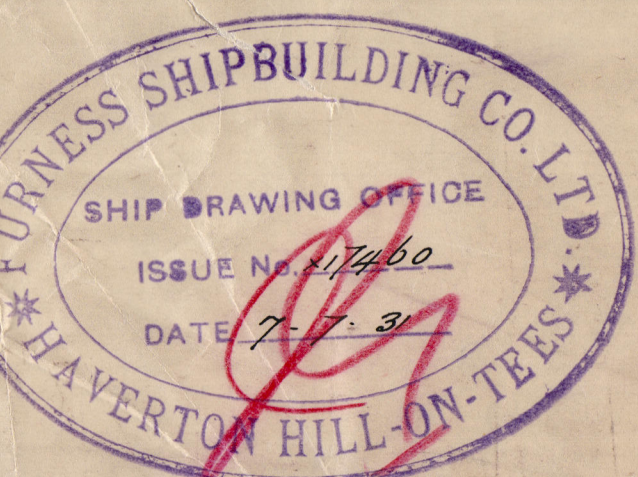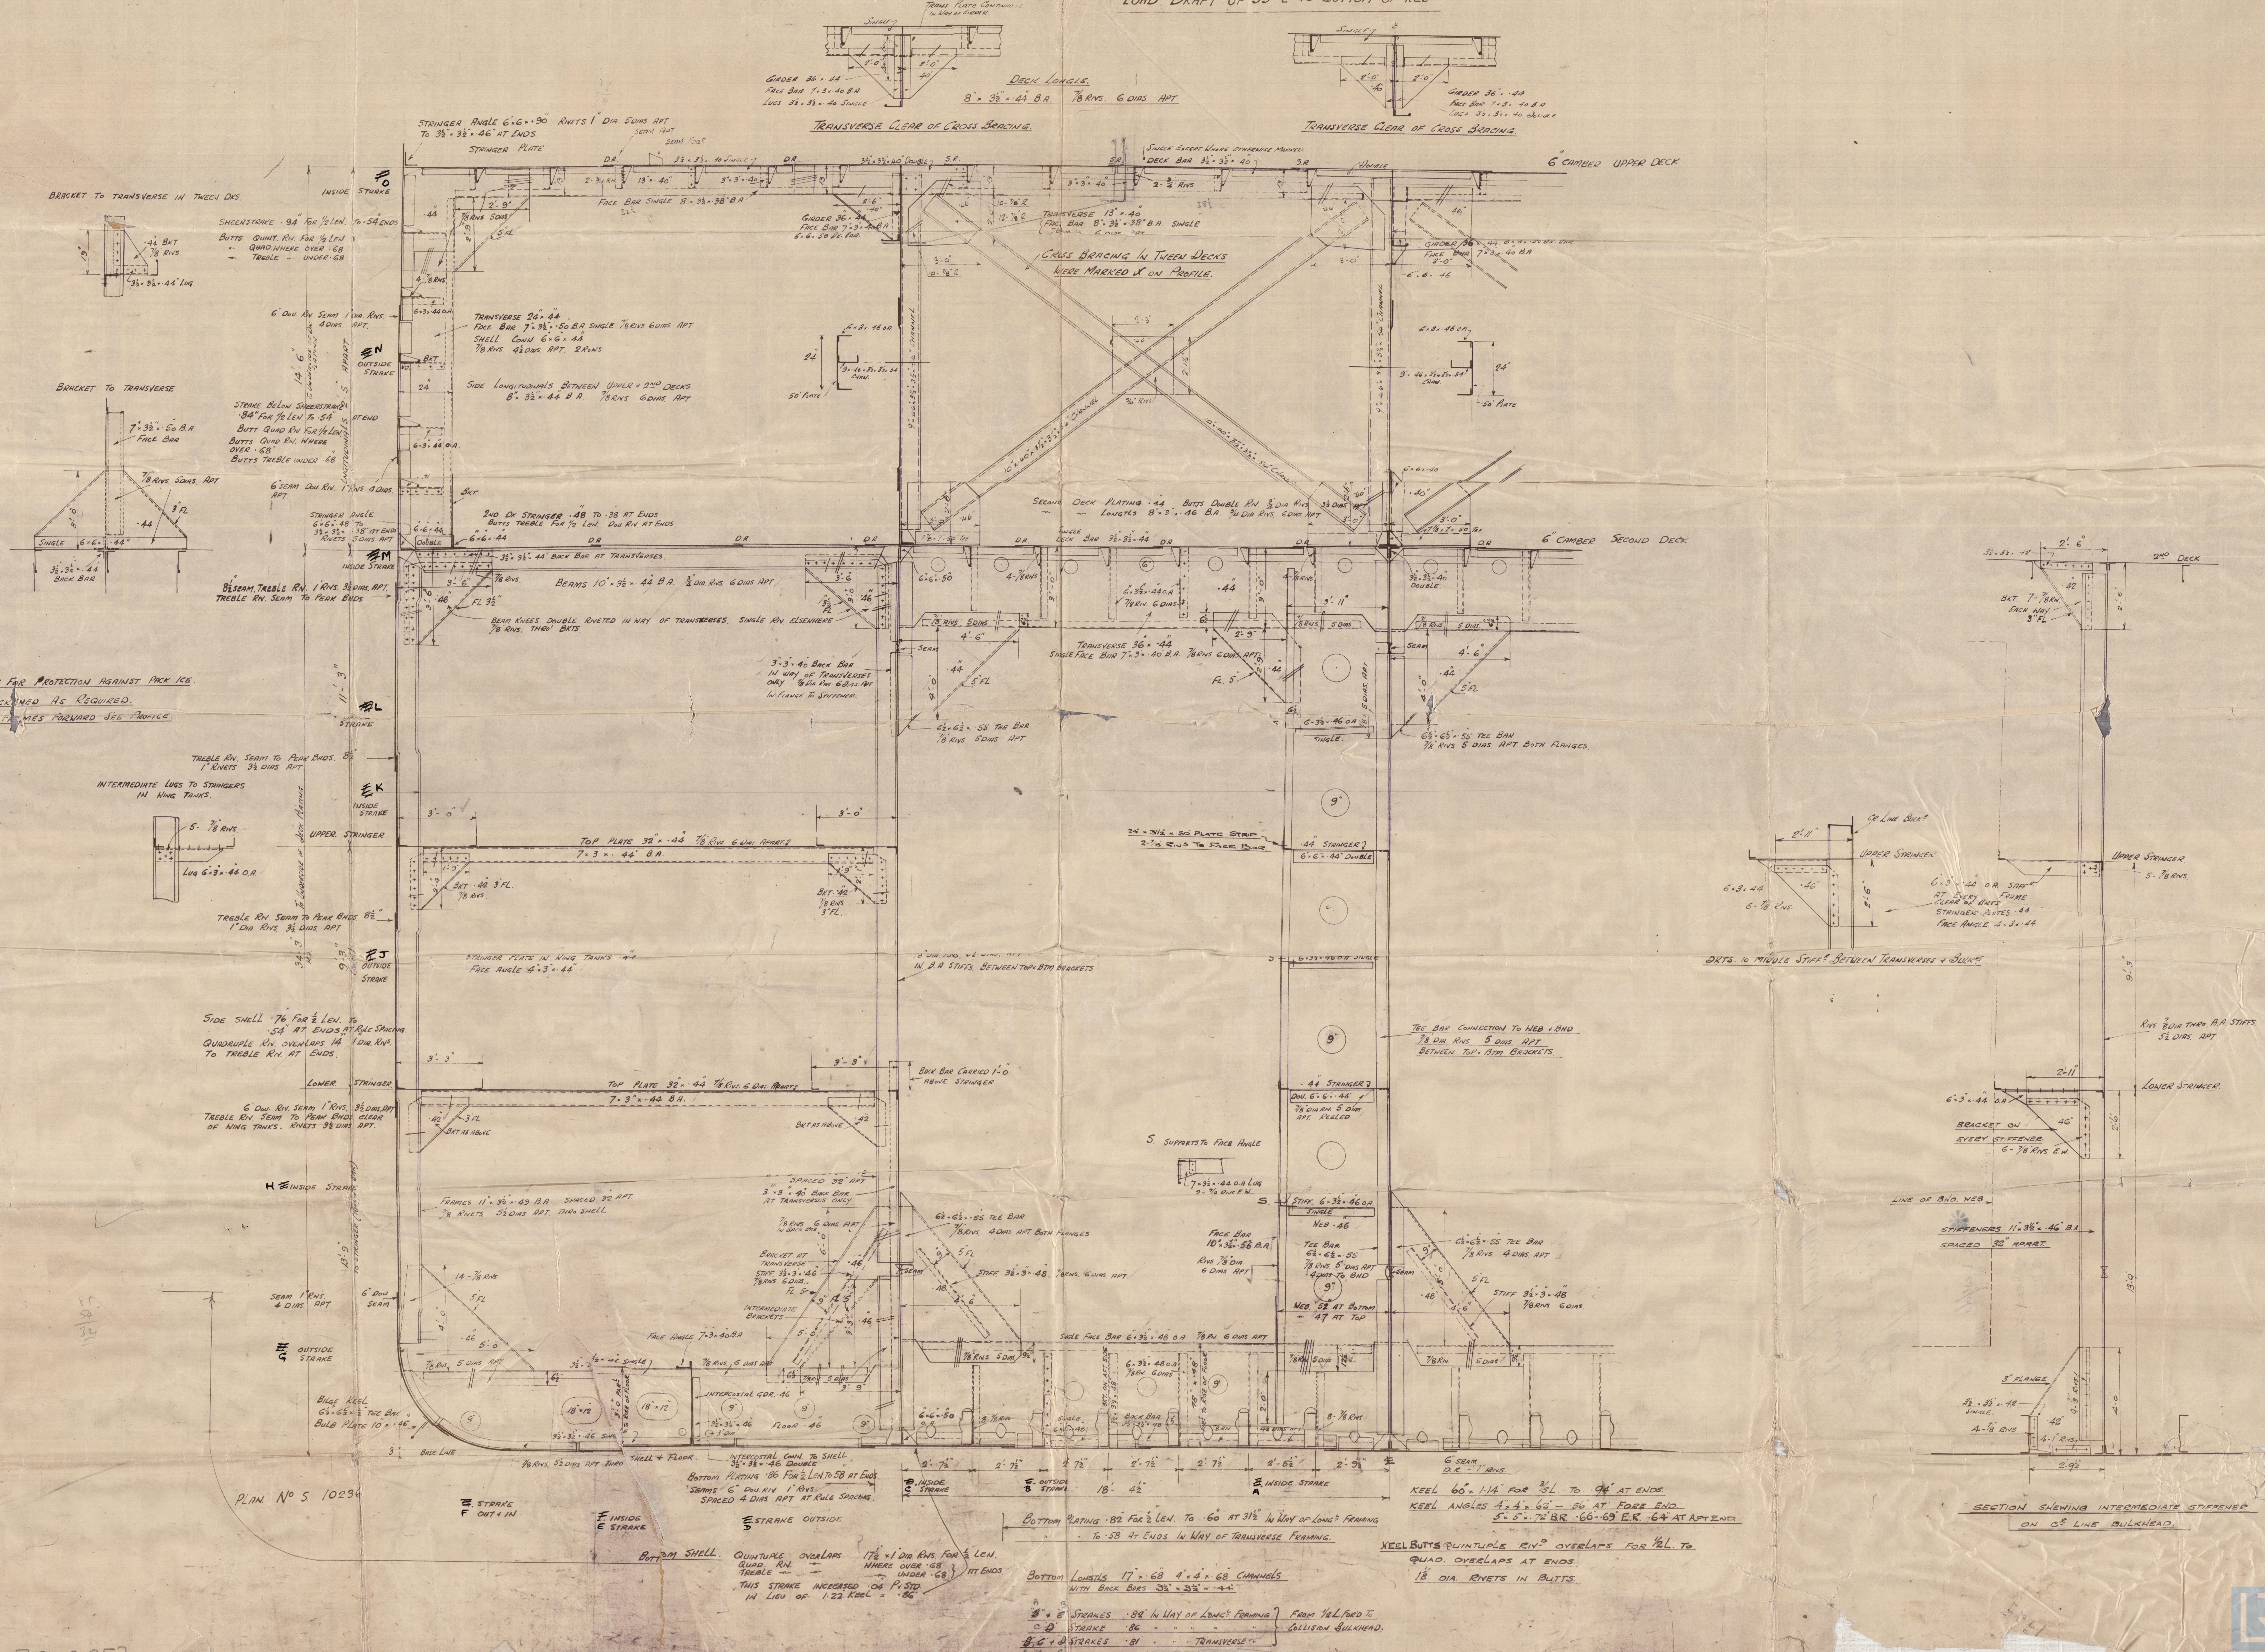

W270-0052



Midship Section  
as built  
Furness & B Co  
189/190



S.S. Vestfold  
MDB. RPT. No. 14446

S.S. Svend Foyn  
MDB. RPT. No. 14466

W270-0057



© 2019

Lloyd's Register  
Foundation