

MIDSHIP SECTION  
S.S. N° 354

LENGTH B.P. 384'0" 383'6" on L.W.L.  
BREADTH M/P 52'9"  
DEPTH M/P 27'6"


SCALE 1/2" = 1 FOOT  
TO CLASS + 100 ALLOYDS

NUMERALS	
L.D. = (384 x 275)	= 10560 10560
L x (B + D) = 384 x (52.75 + 27.5)	= 30816 30775
POOP 38.5 x 8 x 75	= 231
BRIDGE 234 x 8 x 75	= 1404
FORECASTLE 32.75 x 8 x 75	= 202.5
HOUSES 72.5 x 8 x 5	= 290
EQUIPMENT NUMBER	= 32,943.5 32902

EQUIPMENT	
2 BOWER ANCHORS	60 CWTs STOCKLESS
1 STREAM	50% 16" EX STOCK
210 FATHOMS	2 3/4" STUD CHAIN CABLE
90 "	4 3/4" STEEL WIRE (STREAM)
120 "	4 3/4" (TOWLINE)
2 90 "	2 3/4" (HAWSER)
2 90 "	2 1/2" (WARP)

1/2 TO UPPER DECK = 13.91; 1/2 TO BRIDGE DECK = 10.87  
"d" = 24.125

ERECTOR'S 79.82%

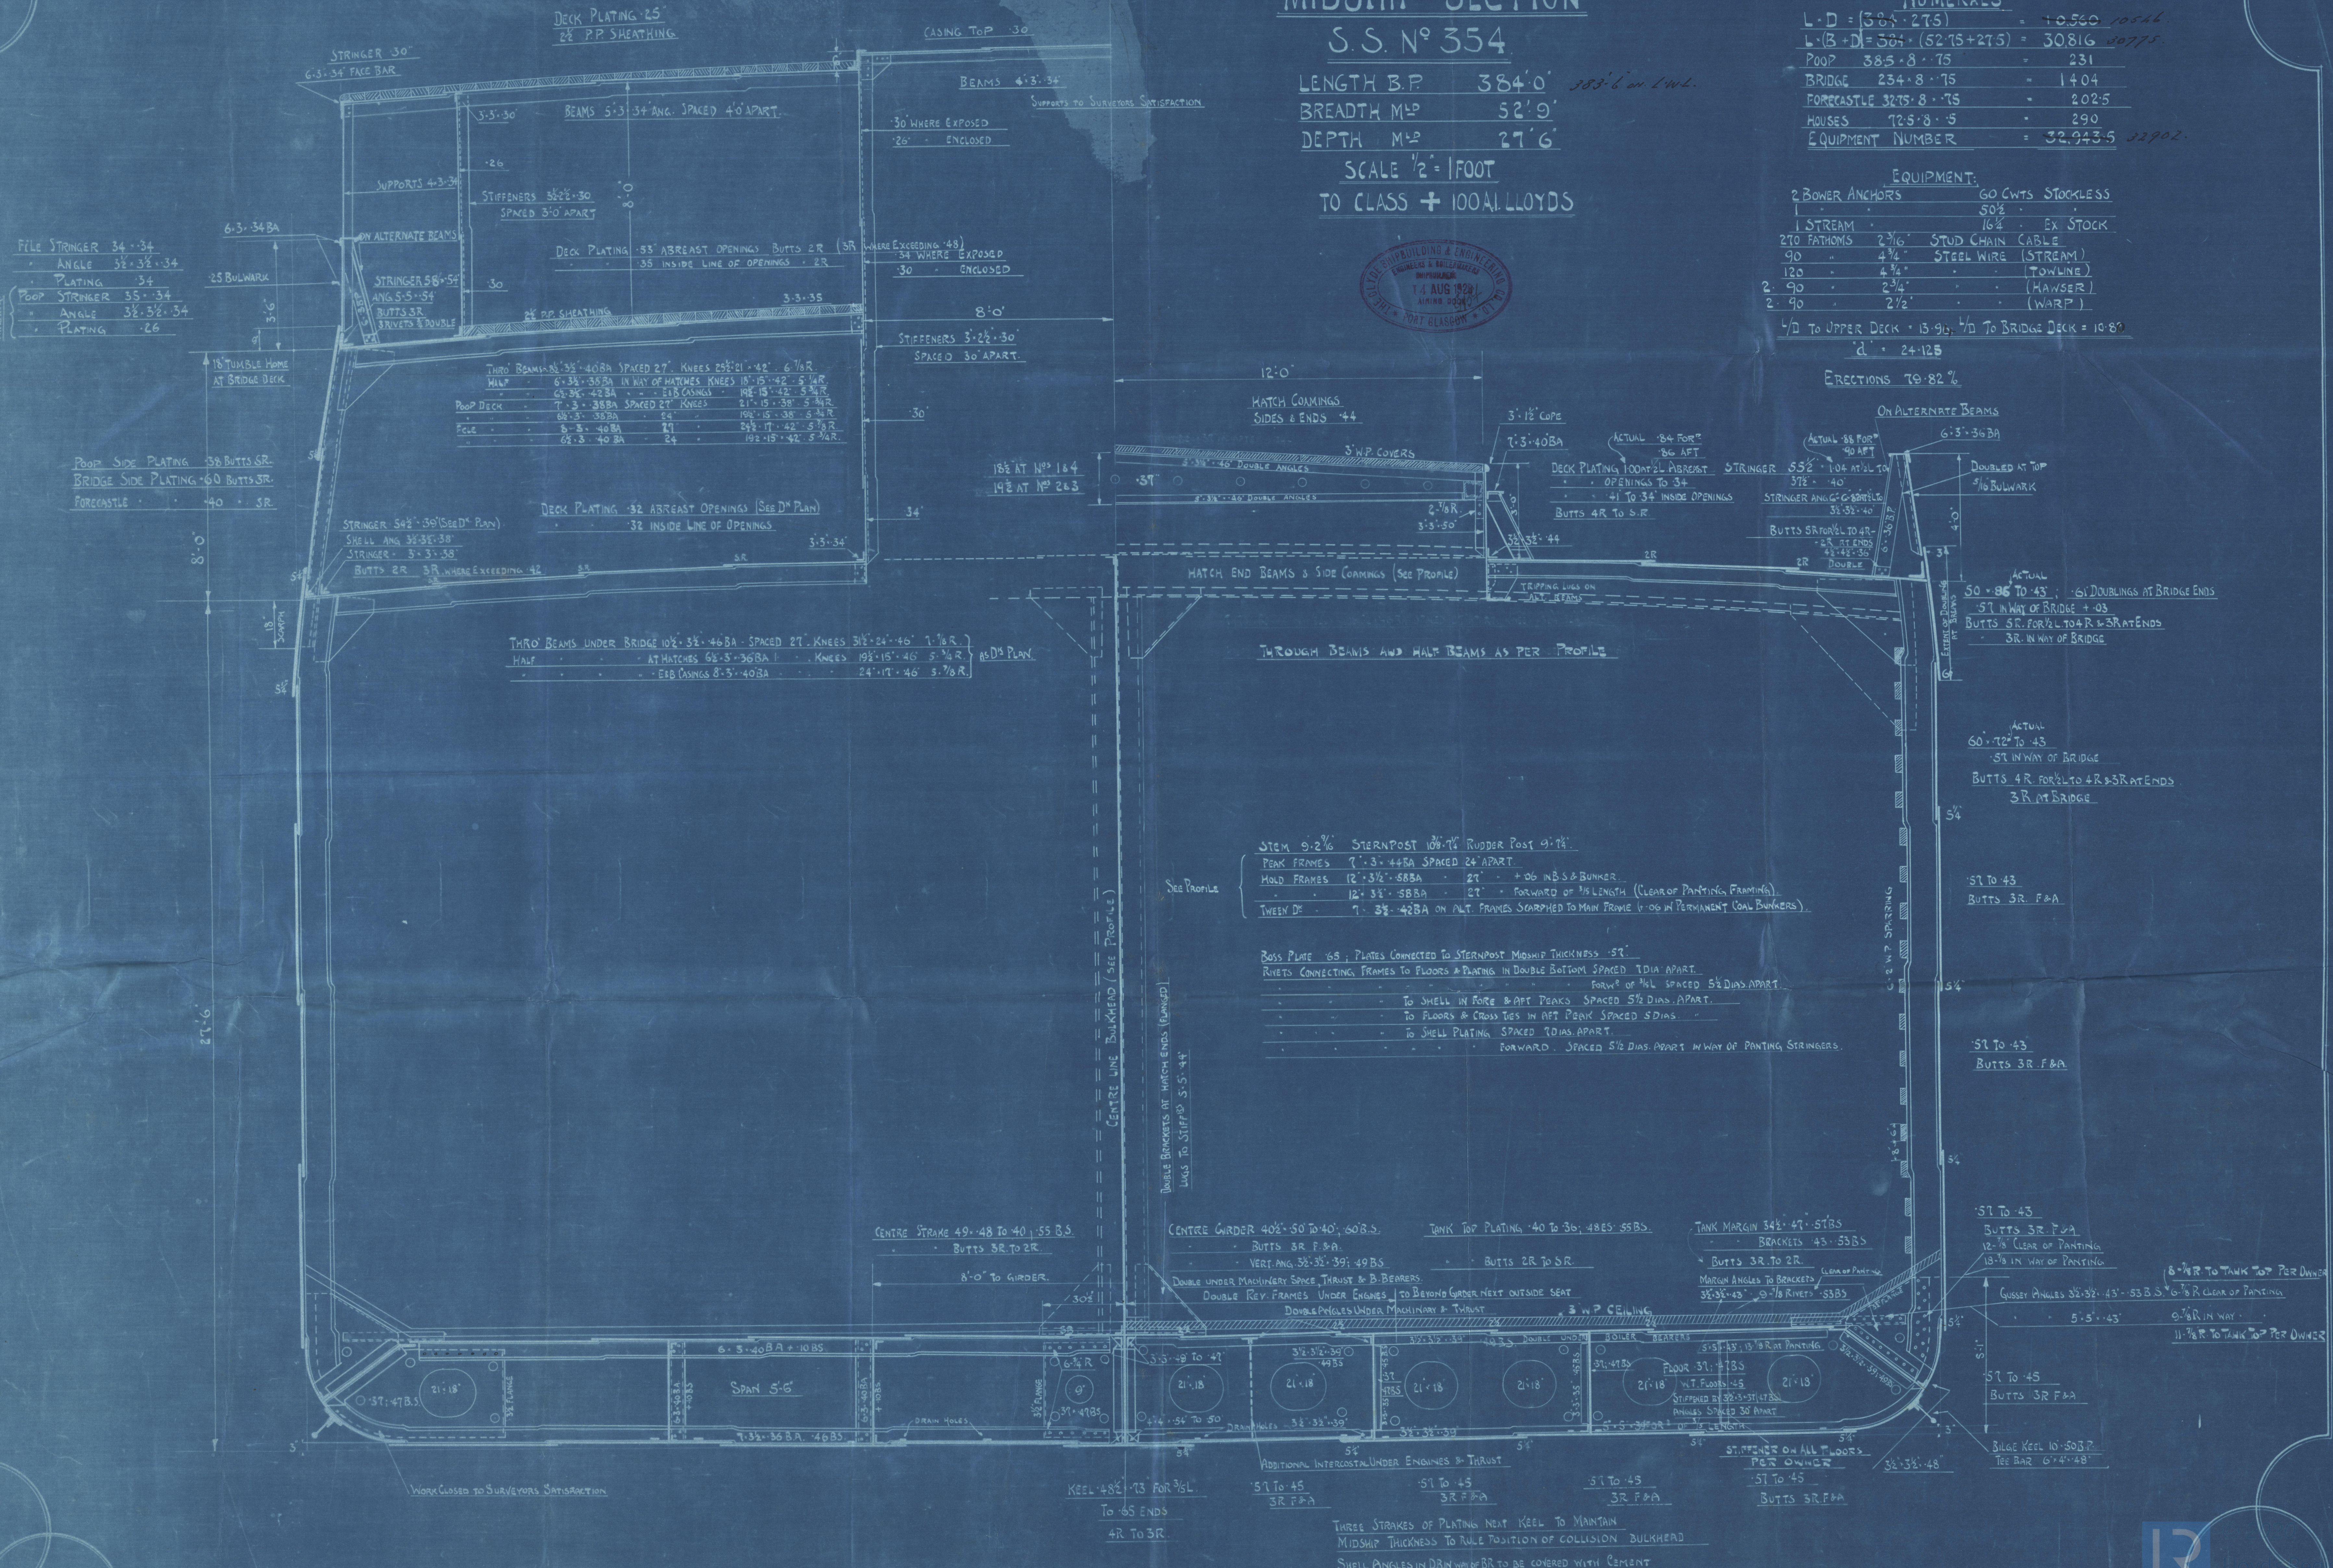




The Clyde S.B. Co. Ld.

J. S. ZONNEWYK

N. 354.

Midship Section  
as Built.

Grk. Rep. N. 18943.

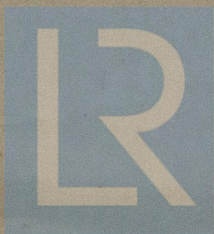

© 2020

Lloyd's Register  
Foundation

W279-0073