

SUNDERLAND

Messrs Osbourne Graham & Co



Profile

(As built)

No 220

S.S. "Lolworth"

SUNDERLAND RPT. No. 27785

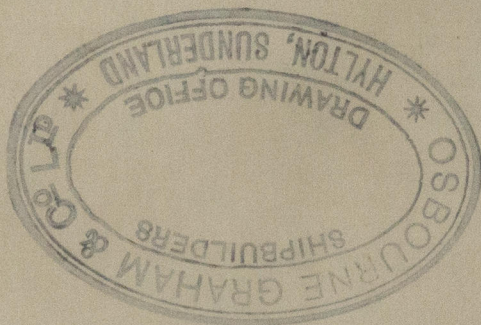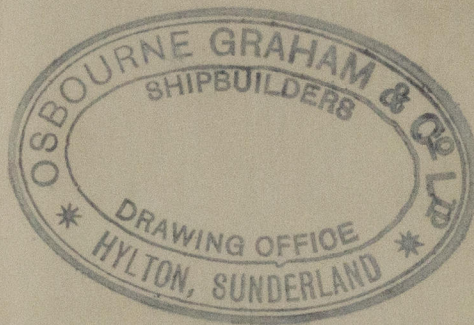

W285-0078



© 2021

Lloyd's Register
Foundation