

S.S. Hellesund (ex San Cristobal Martin)  
Oslo rept. No. 4937

Alterations to Nos. 1 & 2 hatchways.

W295-0198



© 2019

Lloyd's Register  
Foundation


Office

# SAN CRISTOBAL


LLOYDS DIMENSIONS 139'3" x 23'5" x 11'4" DEPTH MOULDED 12'7 1/2"

SCALE 1/8" = 1'-0"

as built now with Hatch-Trunk

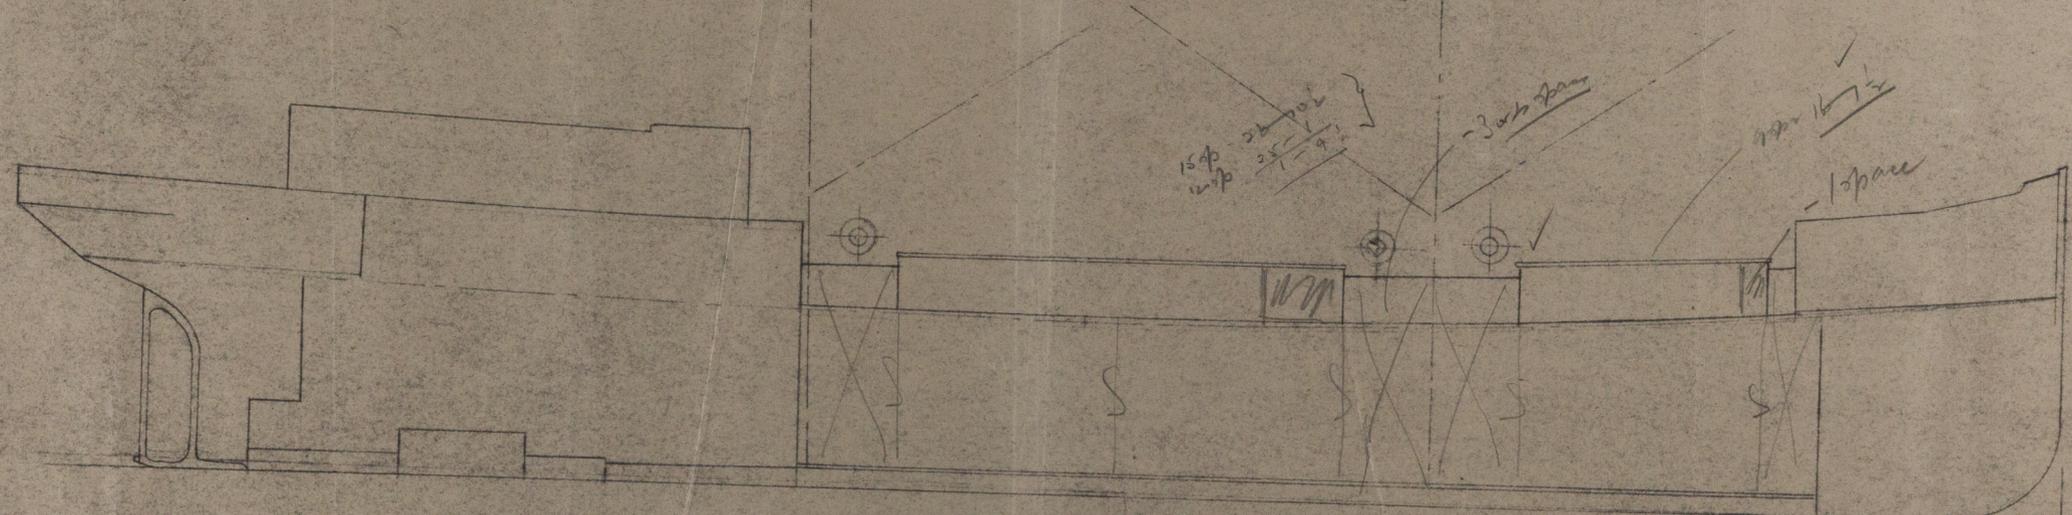

Existing pillar 3/8  
Spacing 21/2  
Hatches 18 x 13-1/2  
Foot of hatch 32-6 x 12-7/8  
CL thru  
2 1/2 inches  
4 ft 6 inches at  
CL thru

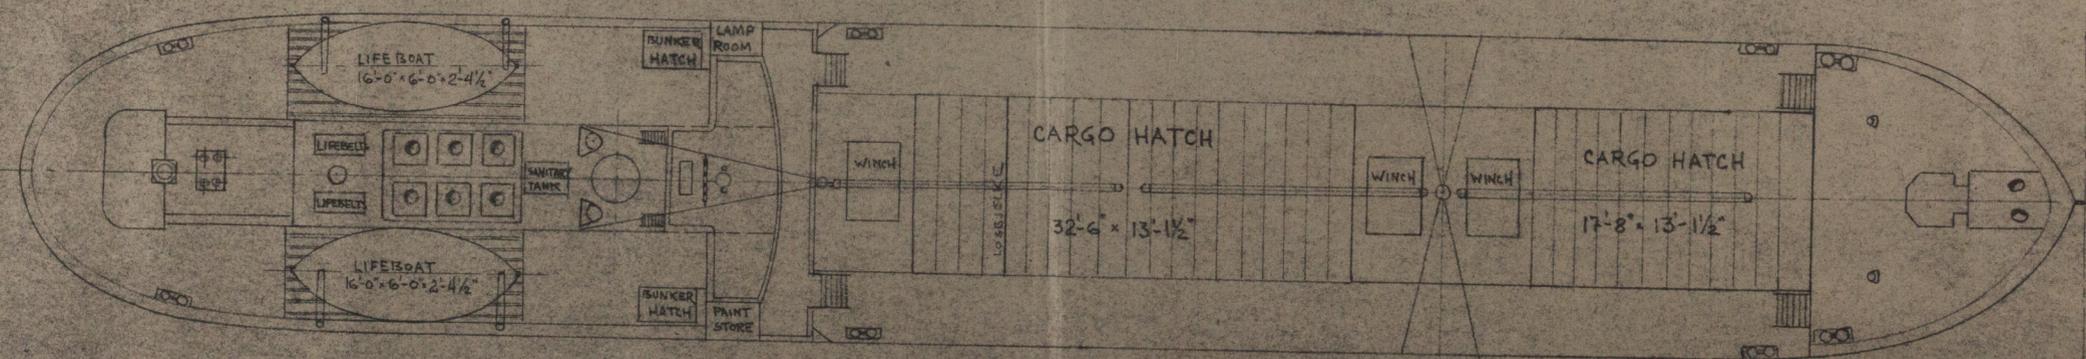

8610-562M  
W295-0158