

S.S. No 226.

MIDSHIP SECTION.

SCALE 1/2" = 1 FOOT.

DIMENSIONS L.B.P. 360'-0". NORMAL BREADTH MOULDED 51'-9". MAXIMUM BREADTH MOULDED 57'-3". DEPTH MOULDED 25'-9".

TO CLASS LLOYDS + 100 A.I. WITH SPECIAL NOTATIONS:- LONGITUDINAL FRAMING AT BOTTOM & DECK

ISHERWOOD COMBINATION SYSTEM.

"ARCFORM."

EQUIPMENT.

EQUIPMENT NUMERICAL.

L x (B + D)	= 360 x (51.75 + 25.75)	= 27,900.
POOP	= 33.16 x 75 x .75	= 186.
BRIDGE.	= 231 x 75 x .75	= 1,342.
FORECASTLE.	= 305 x 75 x .75	= 1,711.
DECKHOUSE & CASINGS	= 56 x 75 x .50	= 210.
SALOON DECKHOUSE.	= 25.68 x 75 x .50	= 96.
EQUIPMENT NUMERICAL		= 29,905.

2 BOWER ANCHORS STOCKLESS AT 56 1/4 CWTs EACH.

1 BOWER ANCHOR STOCKLESS AT 47 1/2 CWTs.

1 STREAM ANCHOR EX STOCK 15 CWTs.

270 FATHOMS OF 2 1/8" STUD LINK CHAIN CABLE.


90 FATHOMS OF 4 1/2" STEEL WIRE STREAM LINE (9/12 G.F.S.W.)

120 FATHOMS OF 4 1/2" STEEL WIRE TOWLINE (9/12 G.F.S.W.)


2 AT 90 FATHOMS 2 1/2" STEEL WIRE HAWSER (9/12 G.F.S.W.)

2 AT 90 FATHOMS 2 1/2" STEEL WIRE WARPS (9/12 G.F.S.W.)

FOR SCANTLINGS OF REINFORCED HATCH END BEAMS
SEE PROFILE & DECK PLAN.

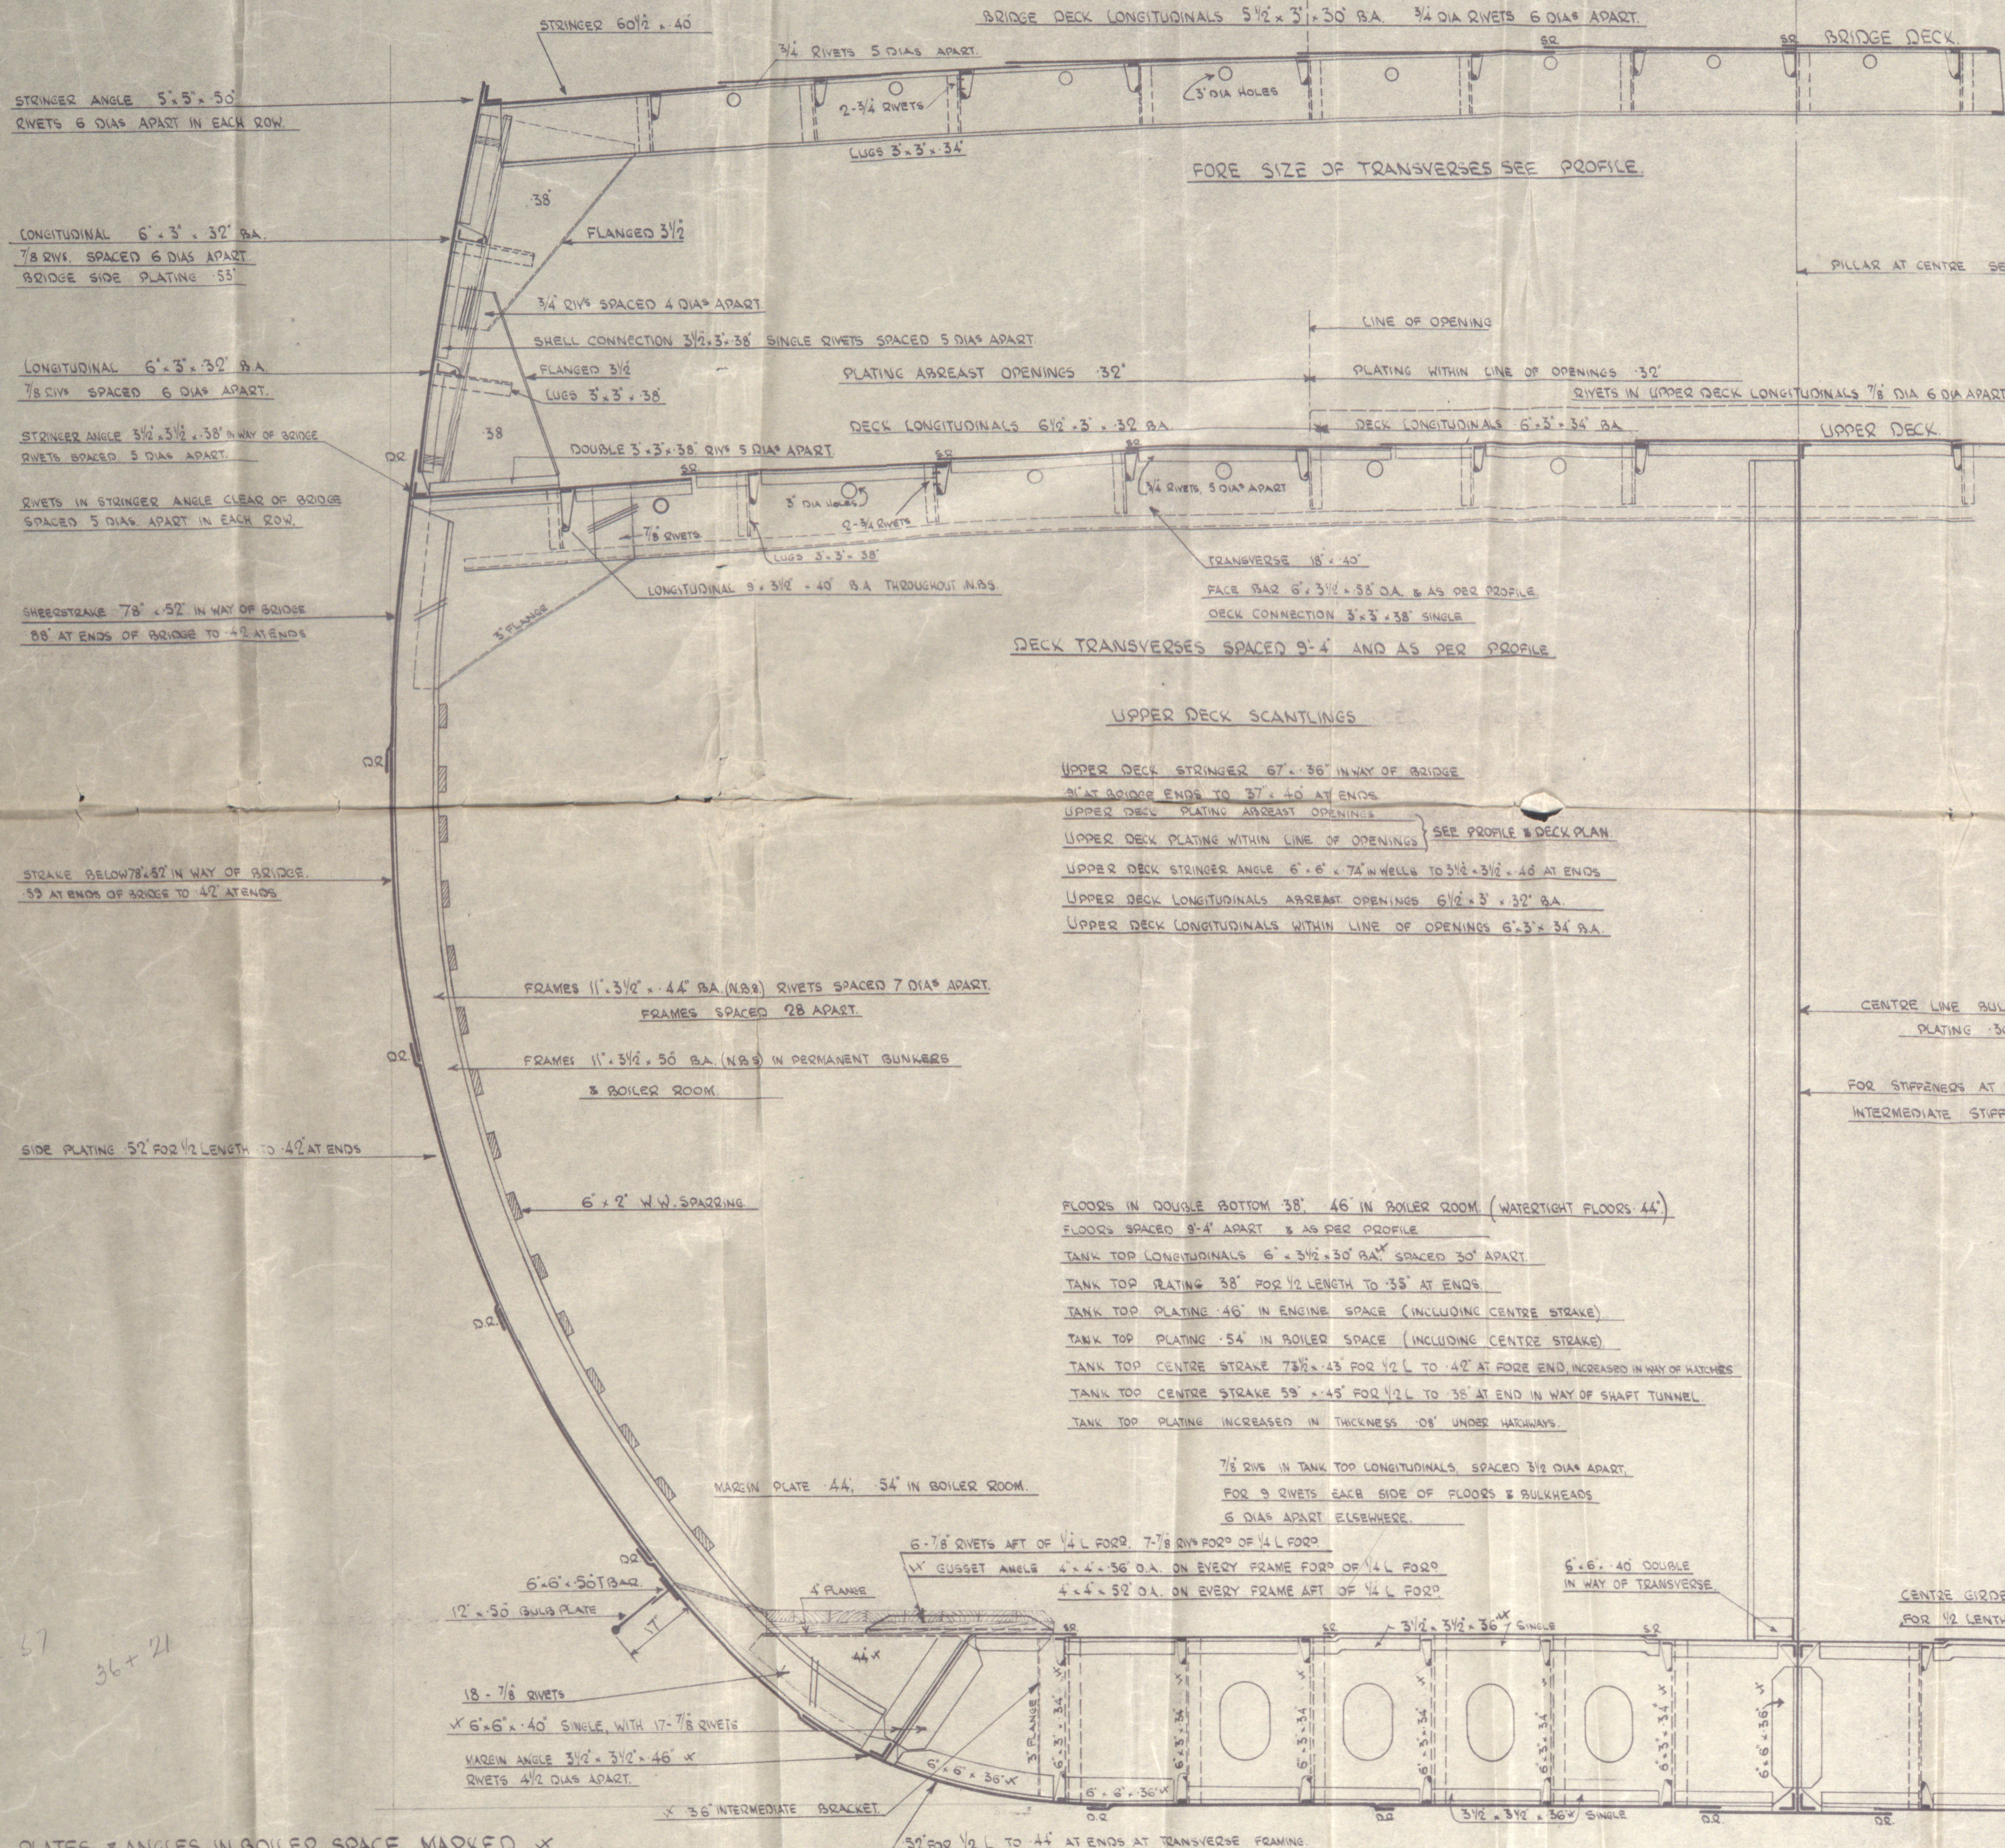

NOTE. PLATES & ANGLES IN BOILER SPACE MARKED X
NOT COVERED BY CEMENT INCREASED 10" IN THICKNESS.

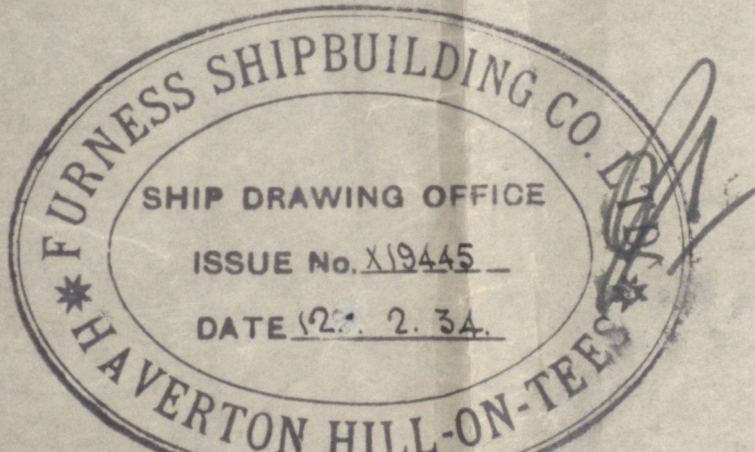

FURNESS S.B. C²


Nº 226 "ARCTEES"

MIDSHIP SECTION

AS BUILT

"English Trader."

S.S. "Arctees"
MDB. RPT. No. 15046

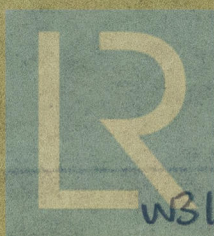

© 2020

Lloyd's Register
Foundation

W31-0112