


PROFILE & DECK PLAN

DIMENSIONS :- LENGTH B.P. 230'-0" BREADTH M^d 36'-0" DEPTH M^d 19'-3"

SCALE 1/8" = 1 FOOT

ISHERWOOD SYSTEM (PATENT)

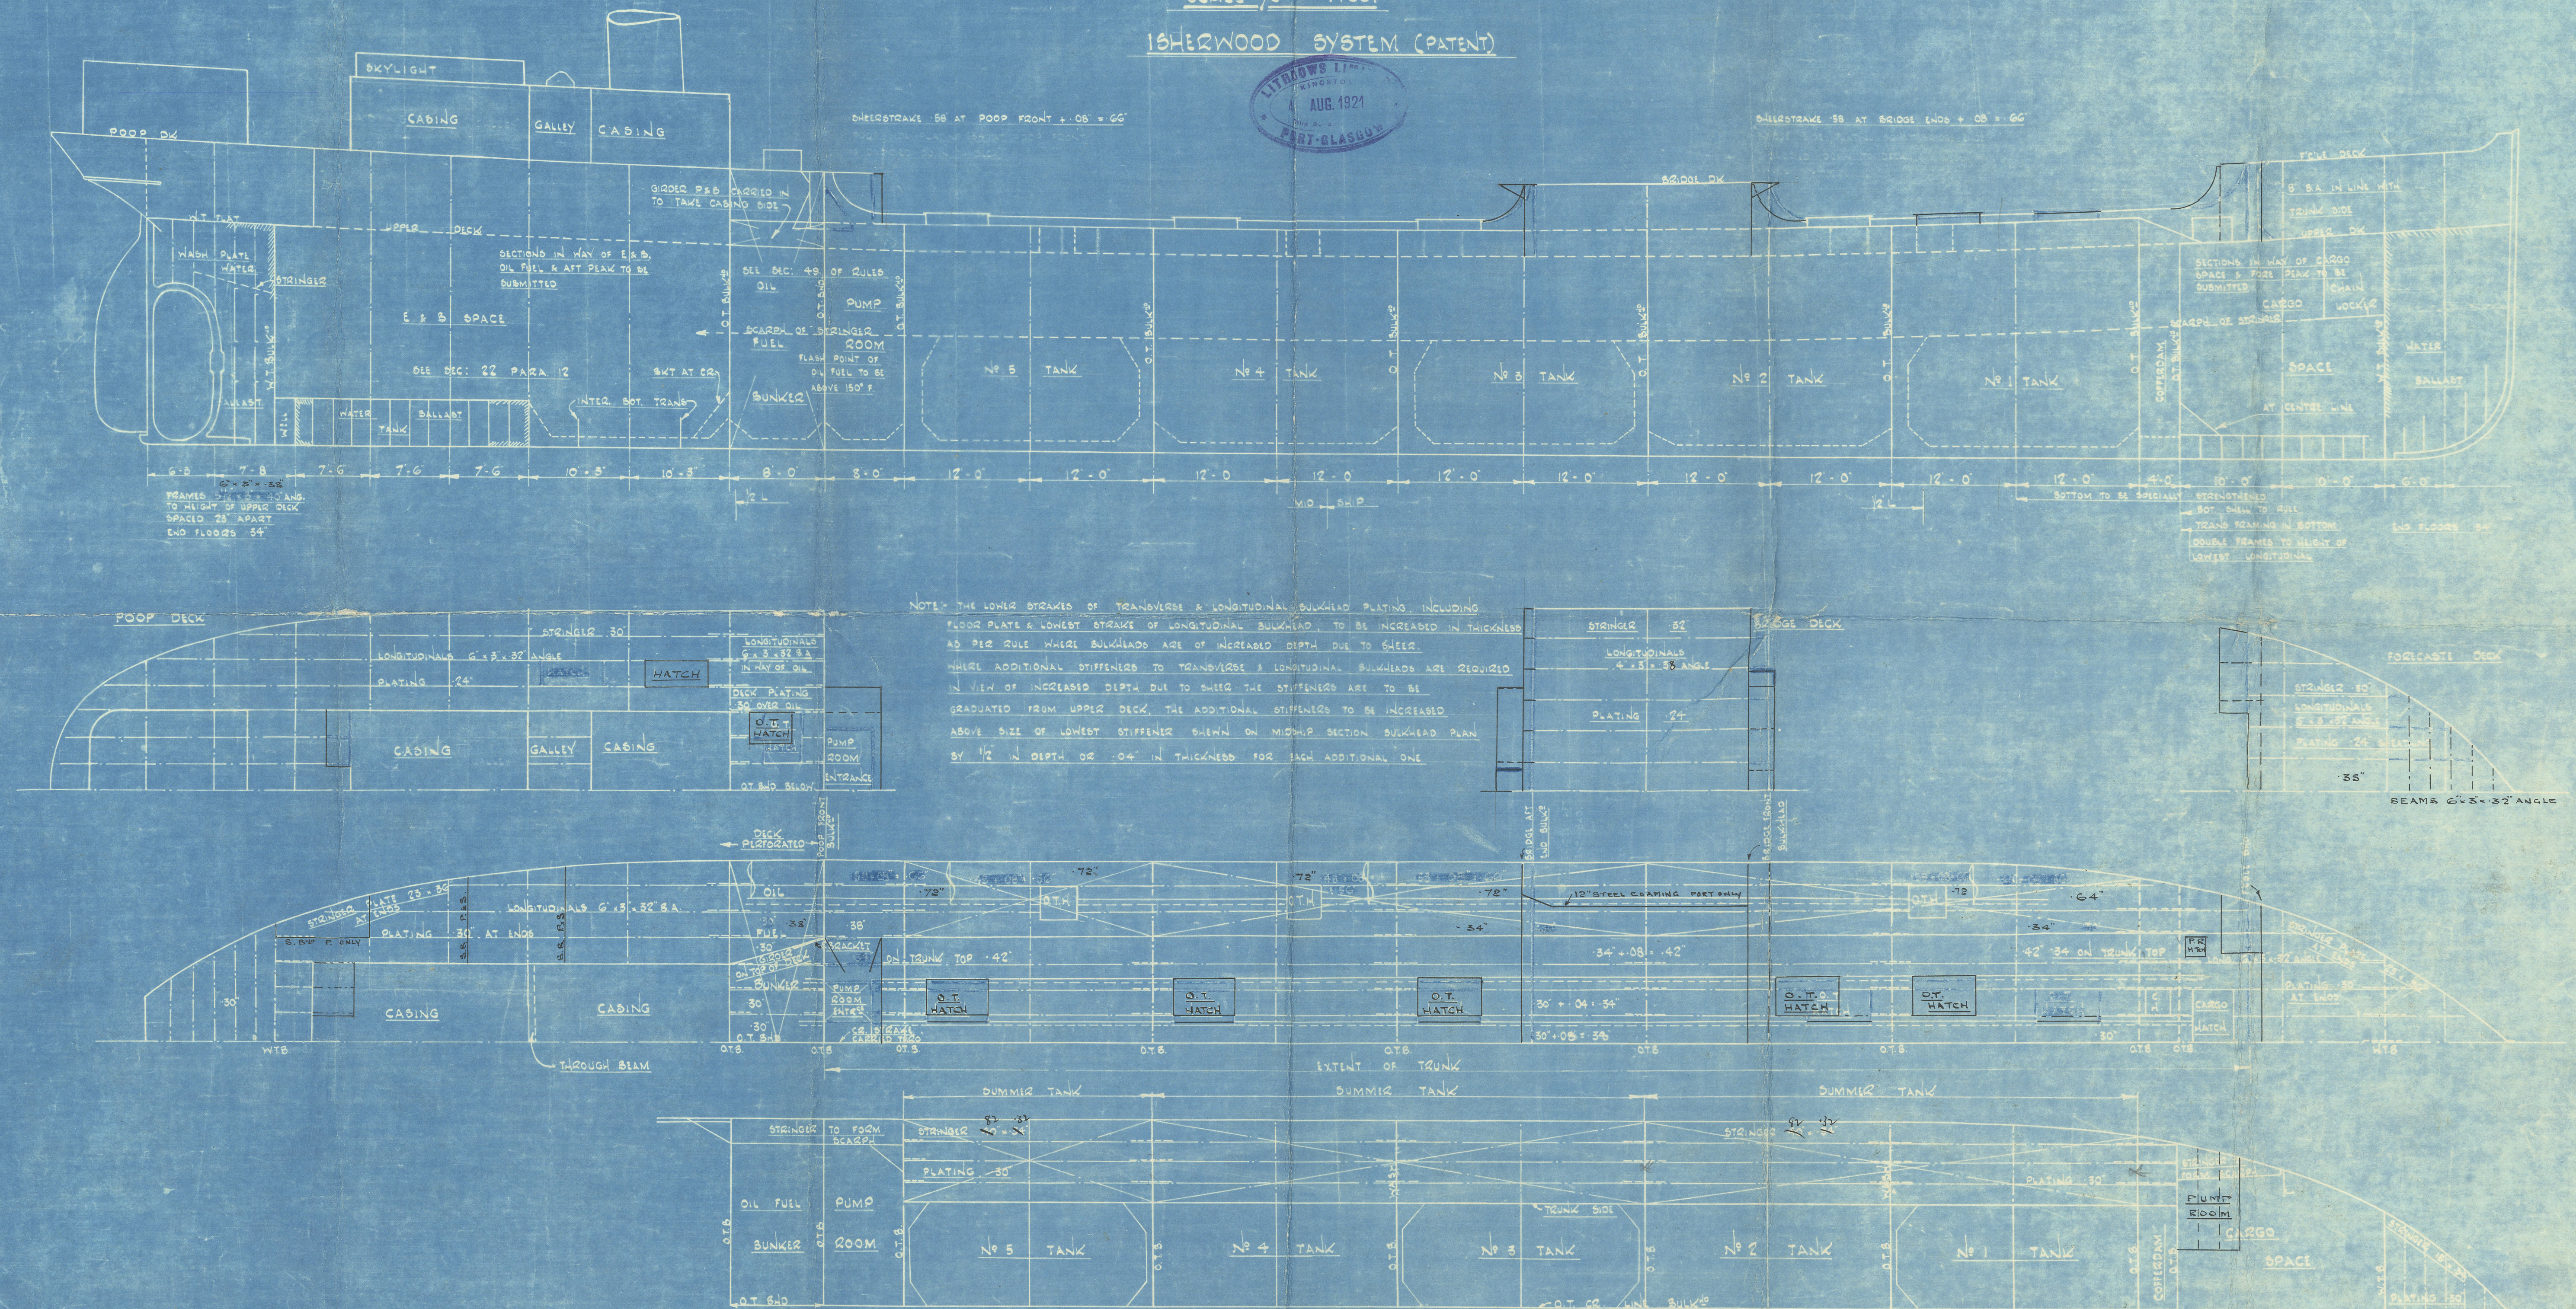

NOTE:- THE LOWER STRAKES OF TRANSVERSE & LONGITUDINAL BULKHEAD PLATING, INCLUDING FLOOR PLATE & LOWEST STRAKE OF LONGITUDINAL BULKHEAD, TO BE INCREASED IN THICKNESS AS PER RULE WHERE BULKHEADS ARE OF INCREASED DEPTH DUE TO SHEER. WHERE ADDITIONAL STIFFENERS TO TRANSVERSE & LONGITUDINAL BULKHEADS ARE REQUIRED IN VIEW OF INCREASED DEPTH DUE TO SHEER THE STIFFENERS ARE TO BE GRADUATED FROM UPPER DECK. THE ADDITIONAL STIFFENERS TO BE INCREASED ABOVE SIZE OF LOWEST STIFFENER SHOWN ON MIDSHIP SECTION BULKHEAD PLAN BY 1/2 IN DEPTH OR .04 IN THICKNESS FOR EACH ADDITIONAL ONE

LITHGOW'S LP 745
"BRITISH TOMMY"
PROFILE & DECK PLANS
AS BUILT.

Eng. Rpt. No. 17865.



© 2019

Lloyd's Register
Foundation