

T.S.M.Y. No 46. PROFILE & DECK PLANS.









DIMENSIONS: 185.0 S.P. (LLOYD'S LENGTH = 196.75)

BREADTH MLD 30.0. DEPTH MLD 16.0

SCALE: 1/4" = ONE FOOT

TRANSVERSE No 94-62

LONGITUDINAL No 27582

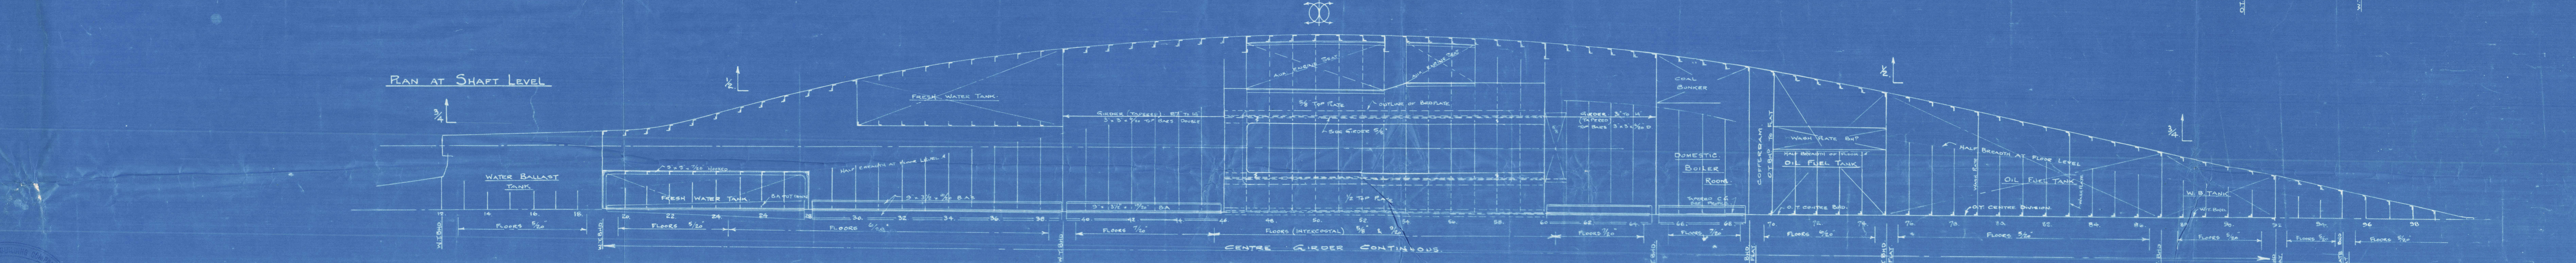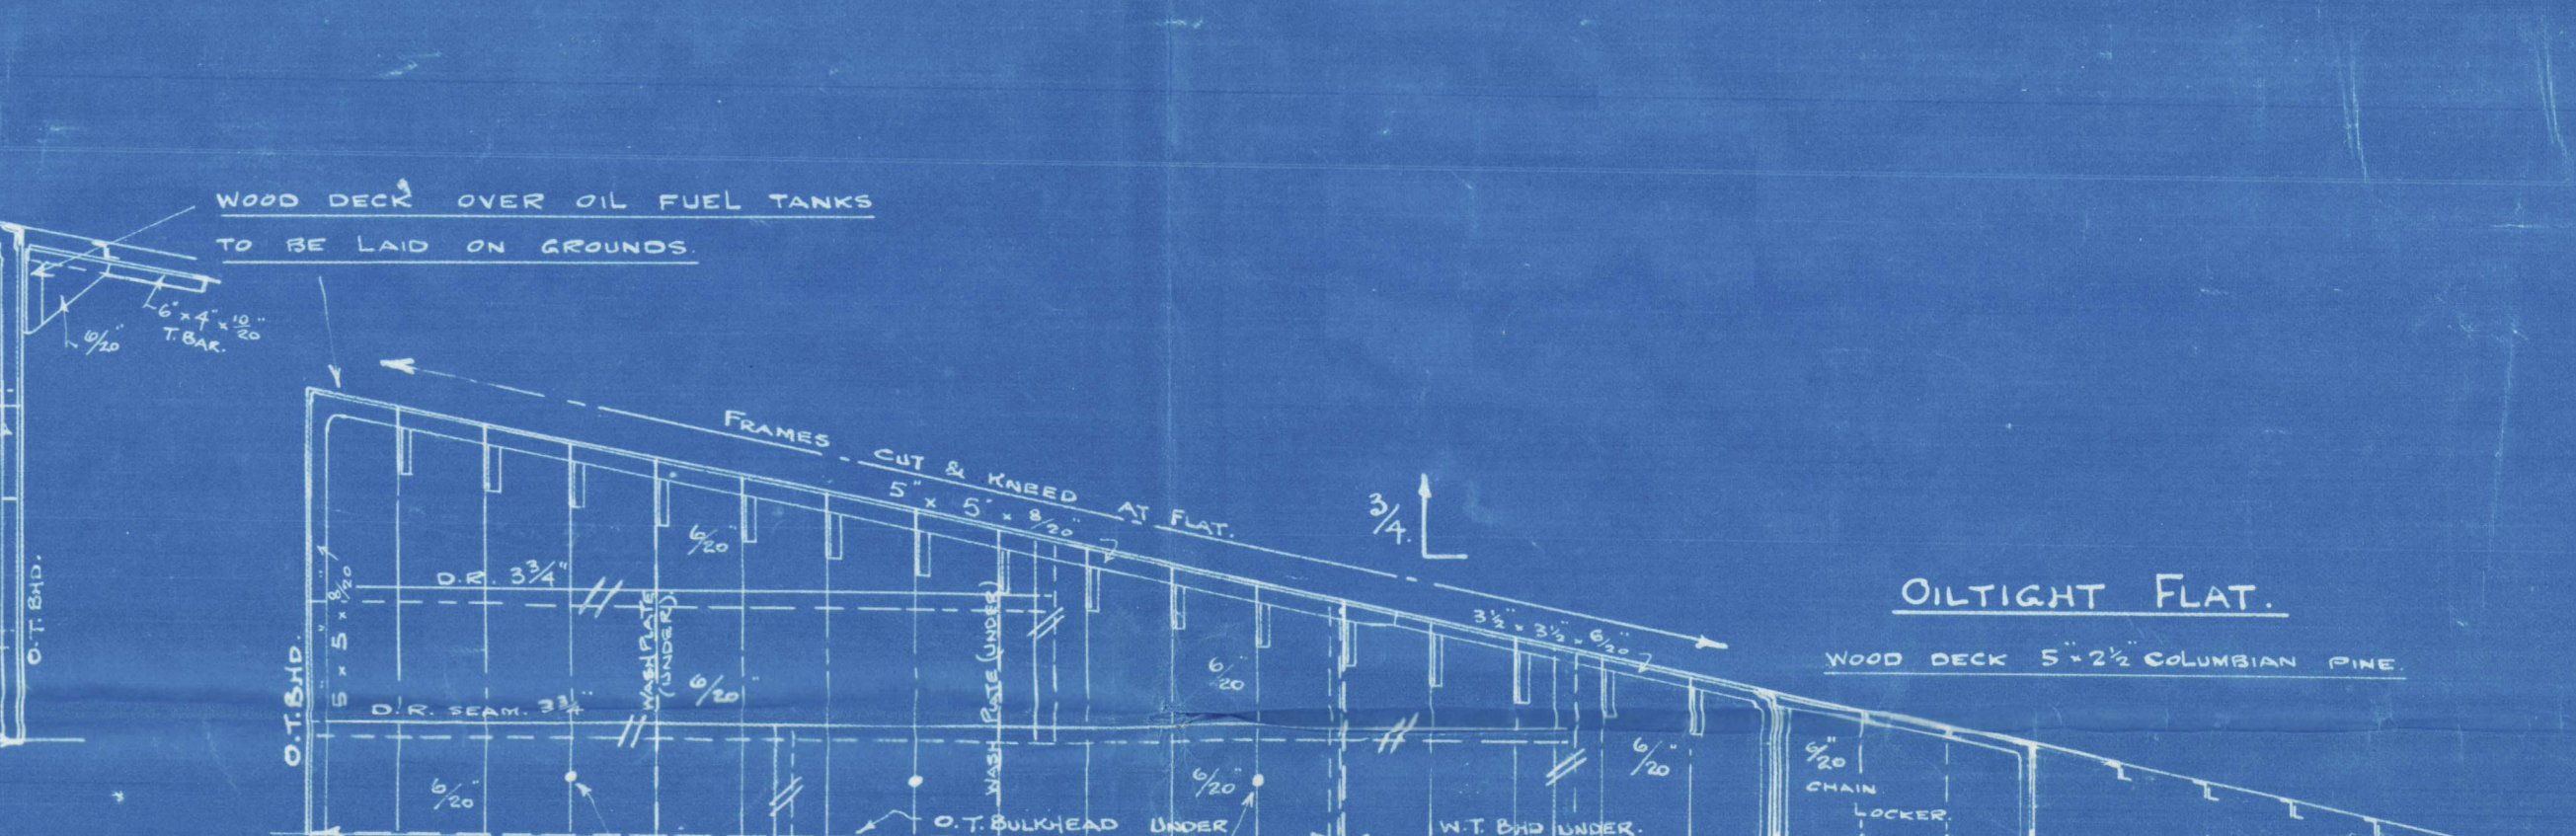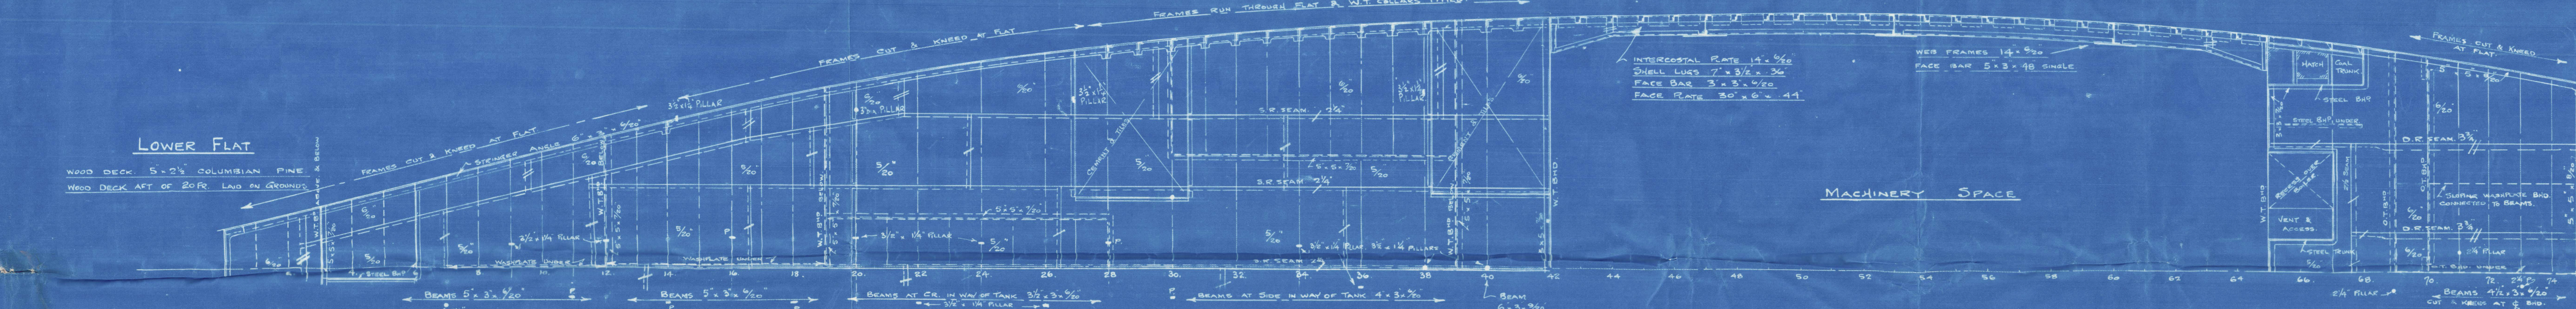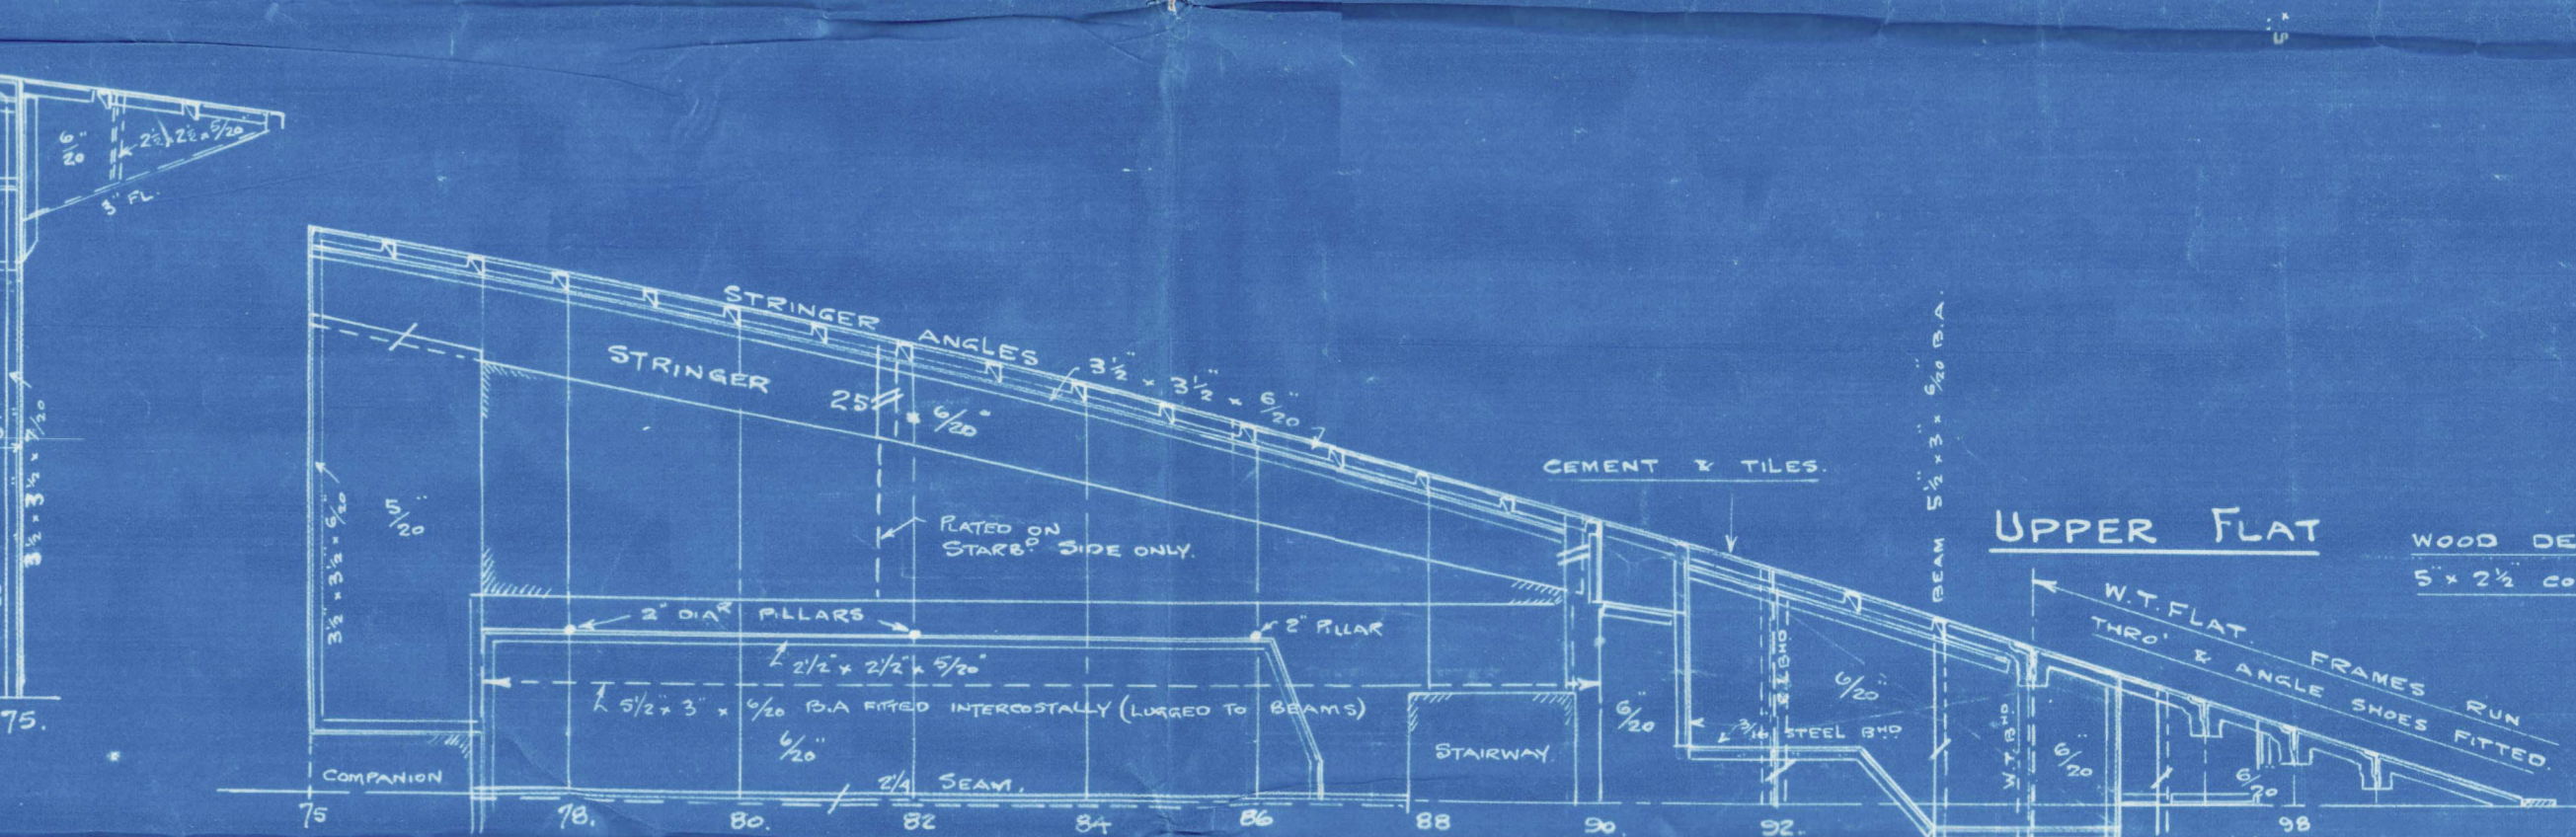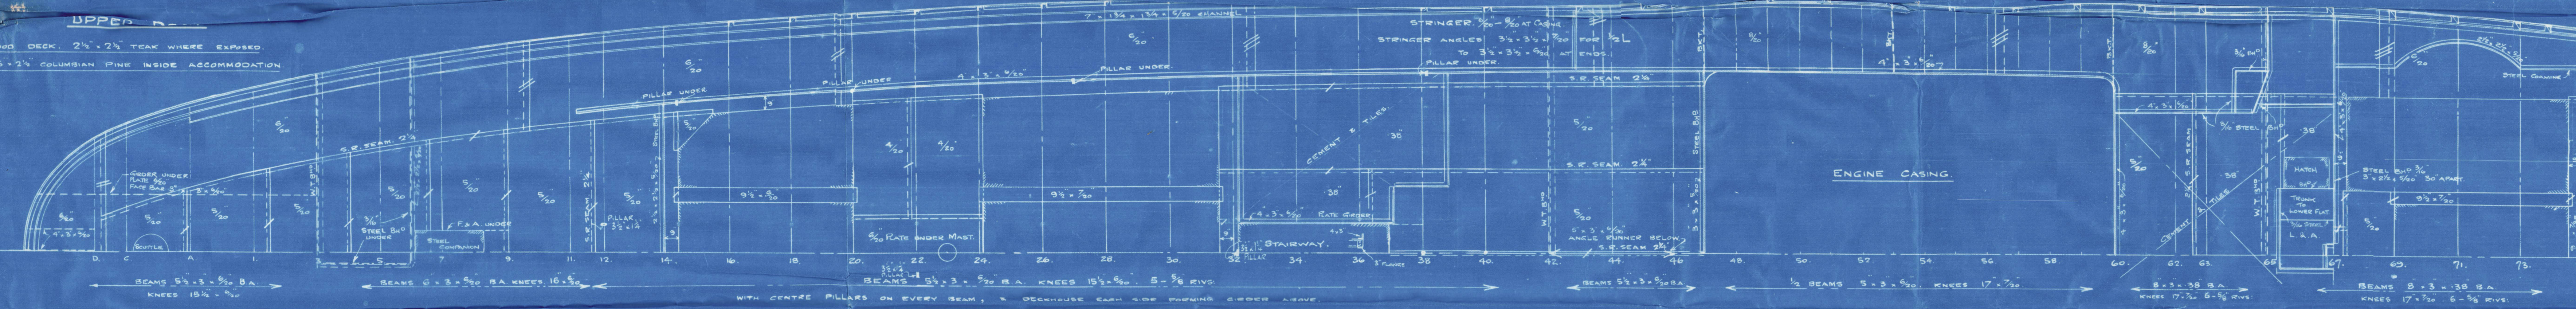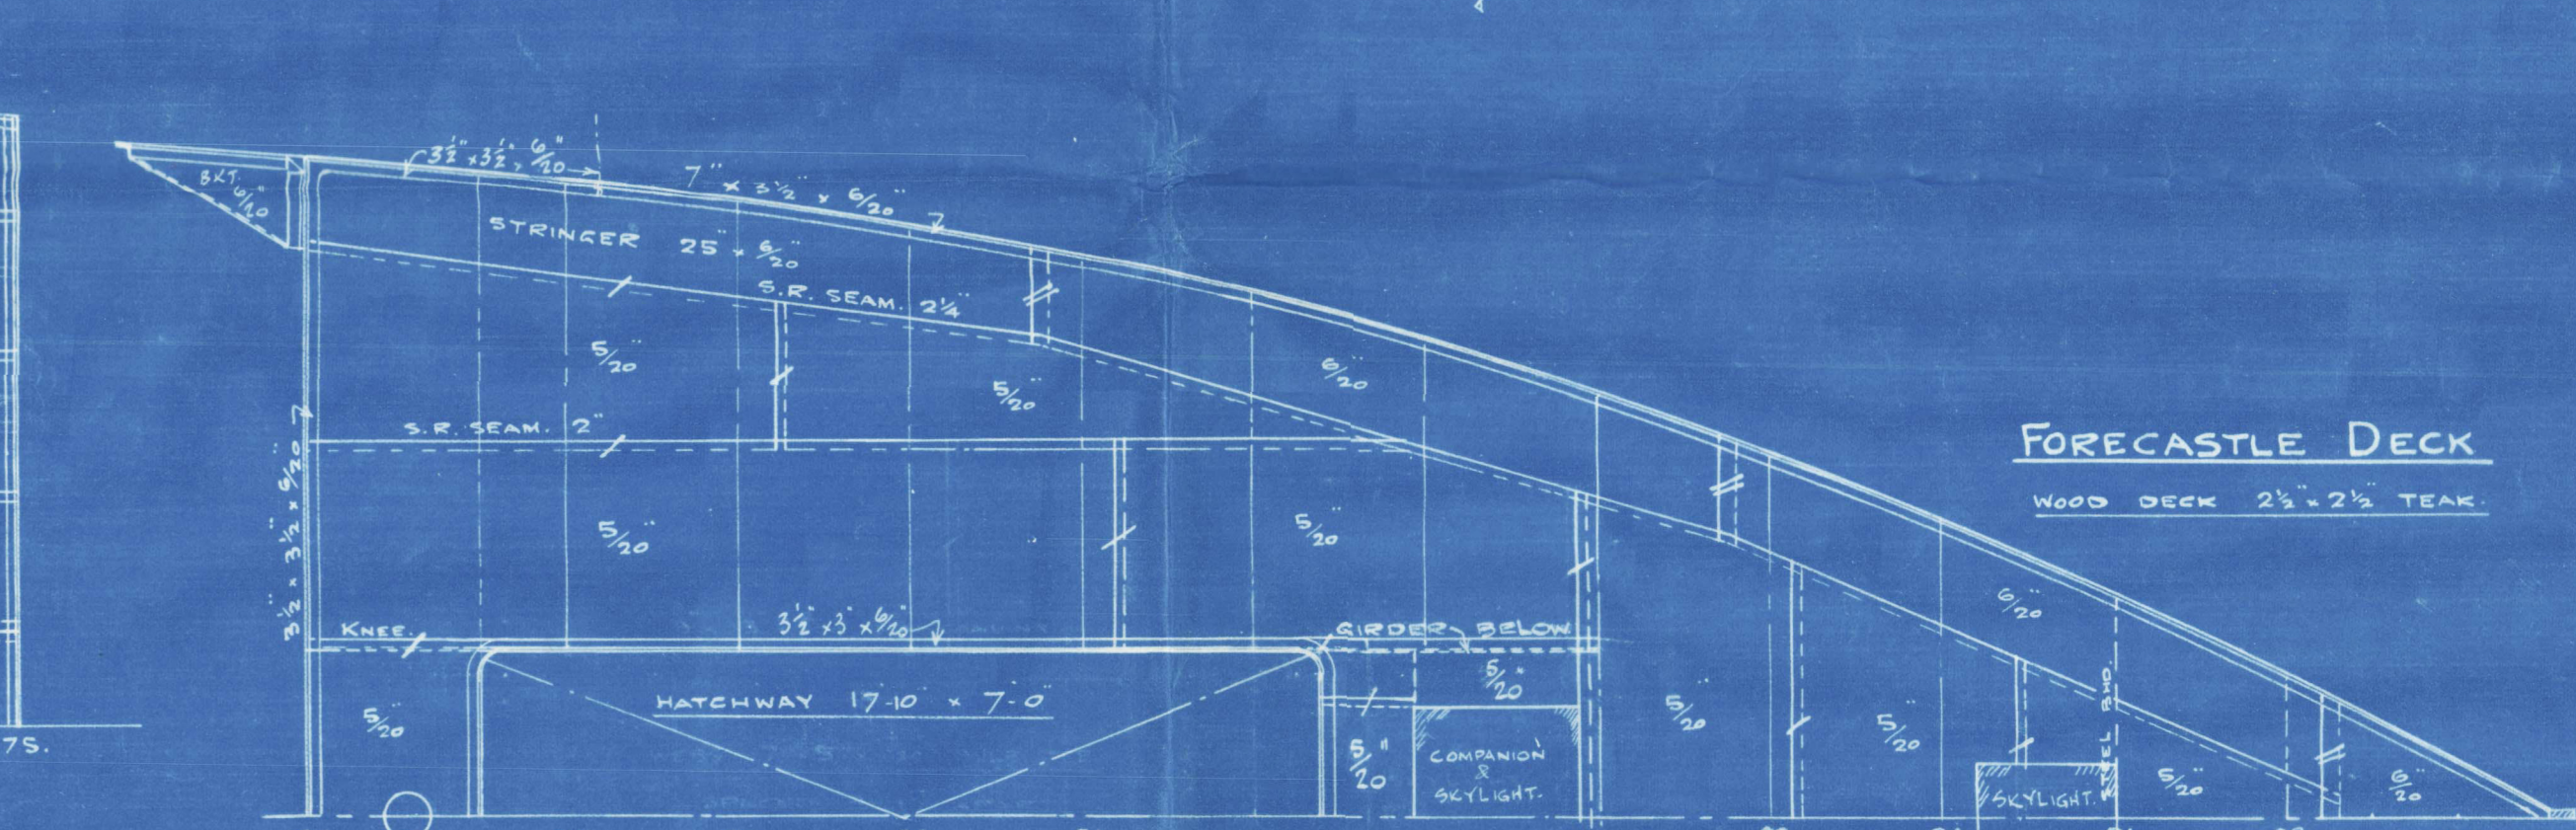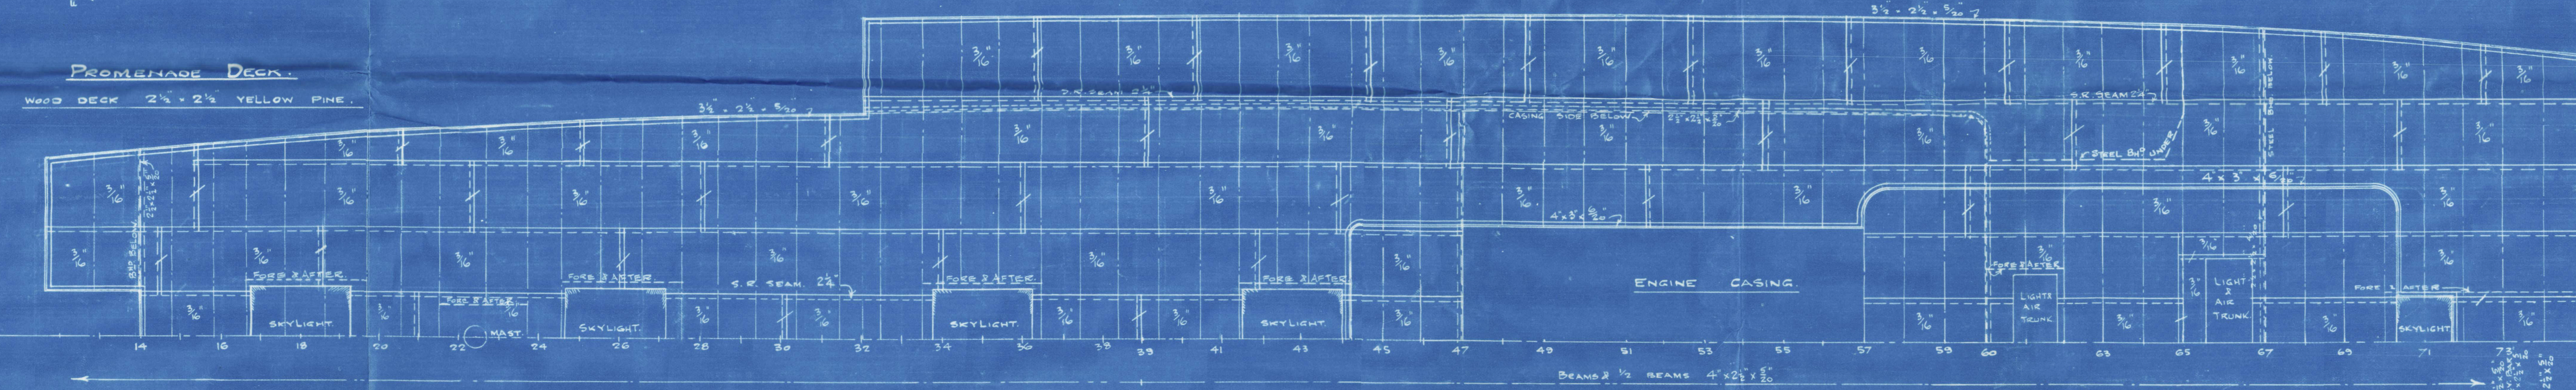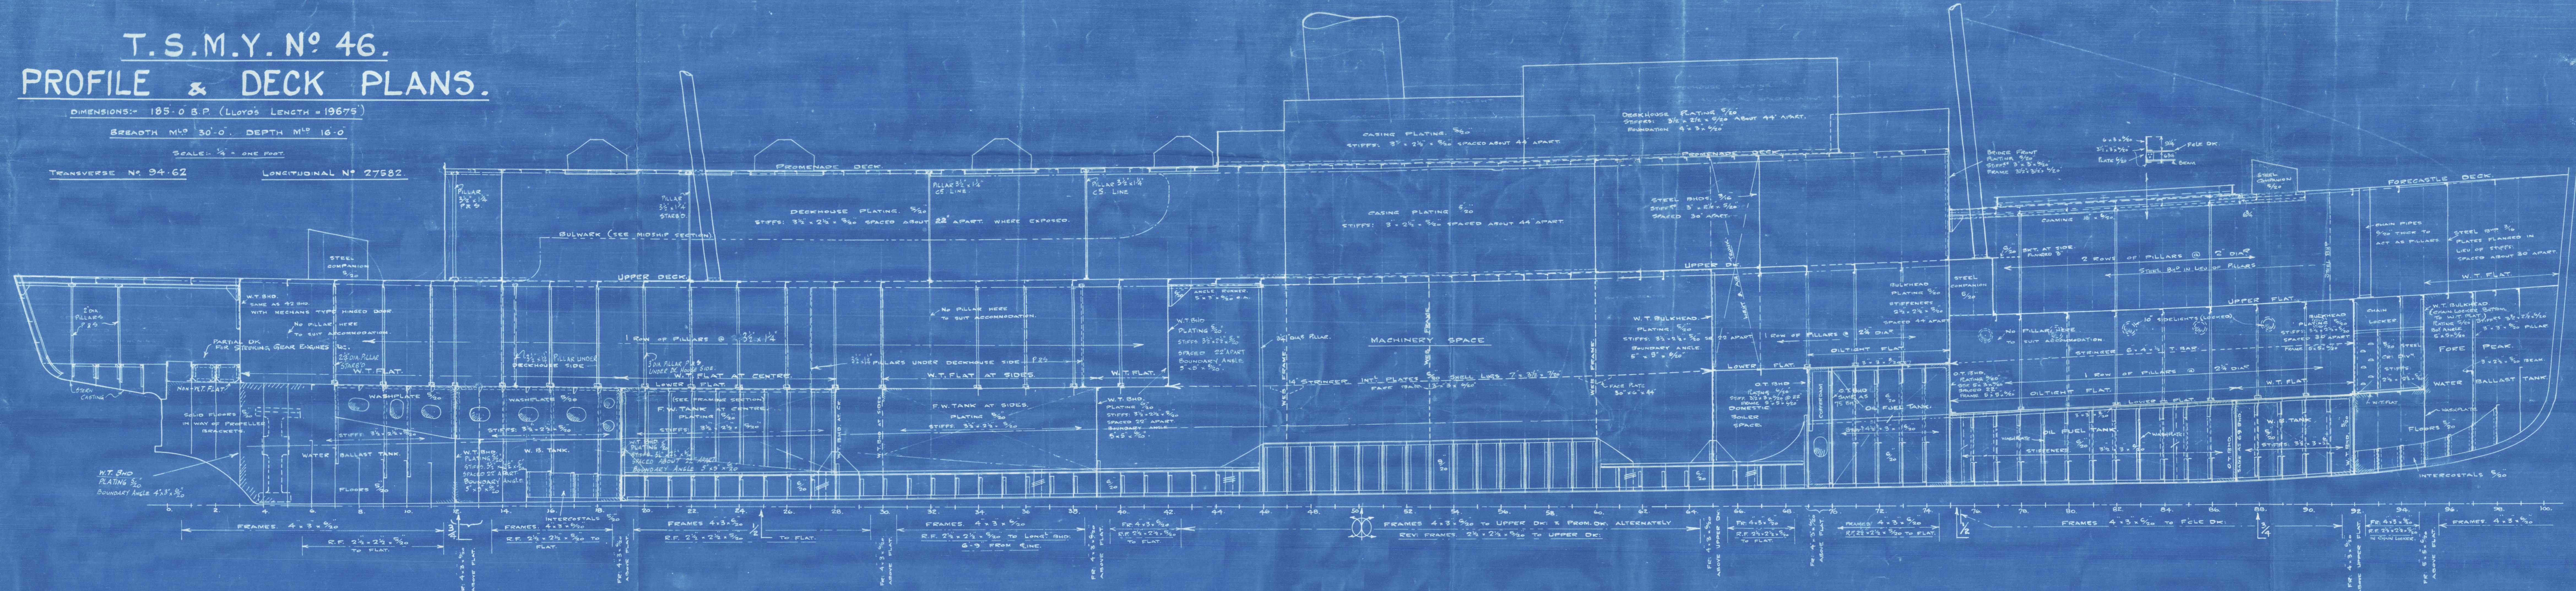

J. S. M. Yacht "Princess"

Turner Ship Bldg No. 46

Profile and Deck plans

(As Built.)

motor yacht

S.S. Princess

U.S. PAT. No. 11920.

W317-0093



© 1900
Library of Congress
Register
Foundation