



S. P. AUSTIN & SON, LTD.
SHIPBUILDERS & REPAIRERS,
WEAR DOCK YARD,
SUNDERLAND.
Date 30th August 1923
Reference No. 223 *HHH*

DIMENSIONS.		EQUIPMENT NO.		EQUIPMENT.	
LENGTH ON L.W.L.	207.5 FEET	L (B+D)	= 10062	2. BOWER ANCHORS	2 3/4 CWT STOCKS
BREADTH FOWLED	33.33 "	QUARTER W/ 131.33, 3.75 =	A92	1 " ANCHOR	20 1/2 " "
DEPTH TO UPPER DECK	14.66 "	FORECASTLE	$\frac{26.04 \times 7 \times 3}{4} = 137$	1 STREAM "	6 " EX. STOCK
L x D.	3042	WATER HOUSE	$\frac{12.76 \times 7}{2} = 45$	210 FATHOMS	1 7/8 STD CABLE
L (B+D)	10062	UPPER HOUSE	$\frac{8.5 \times 7}{2} = 30$	60 "	3 1/2 WIRE (STREAM CHAIN)
d TO UPPER DECK.	* 12.08 FEET	CASING	$\frac{AG 83.3 \times 7}{2} = 164$	90 "	3 1/2 " "
d TO QUARTER DECK.	* 15.83 "		<u>10930</u>	90 "	2 1/2 " "
1/2 TO UPPER DECK	14.15			90 "	1 1/2 " "
1/2 TO QUARTER DECK	11.27	* CORRECTED FOR FRAMING			

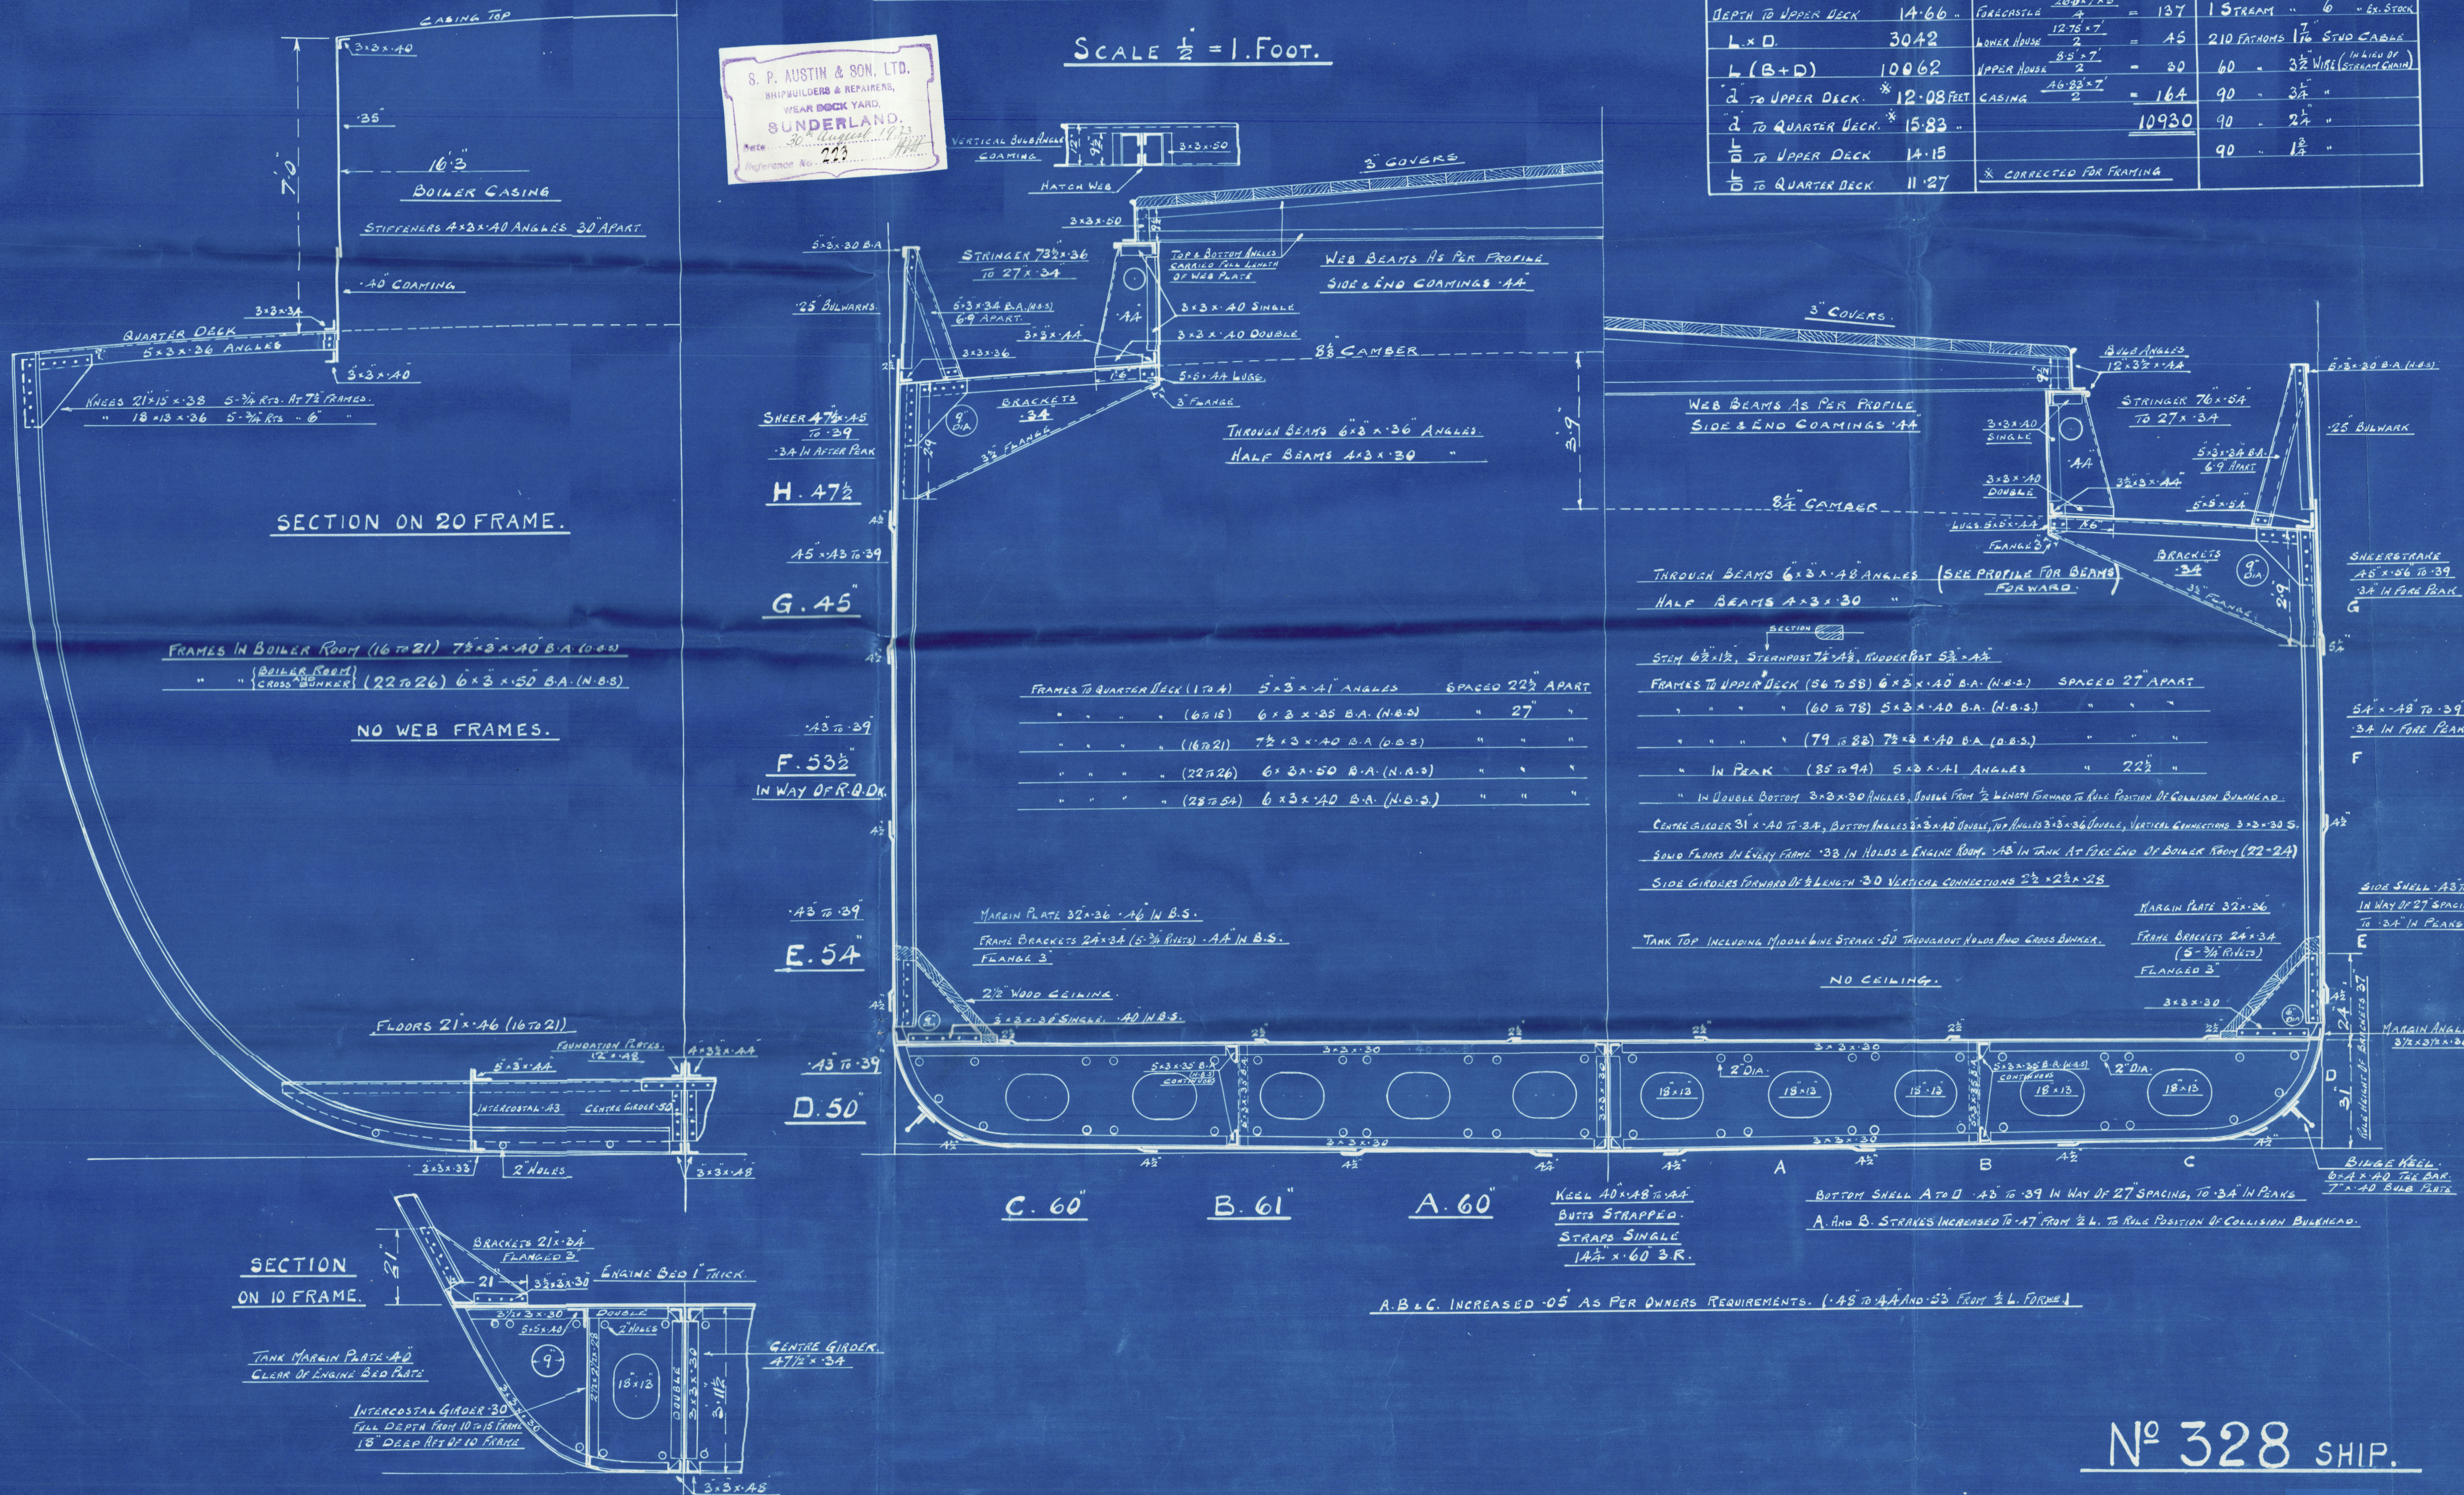

Nº 328 SHIP.

CORHAVEN
Medley Section
As built

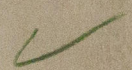

BUNDERLAND RPT. NO. 31241

RETAIN

RETAIN

W374-0189



© 2020
Lloyd's Register
Foundation