

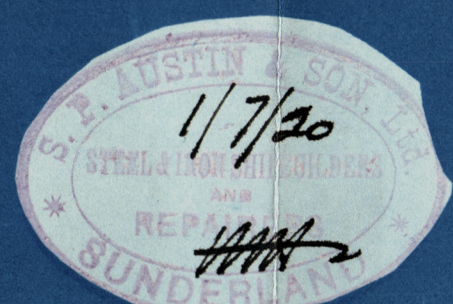
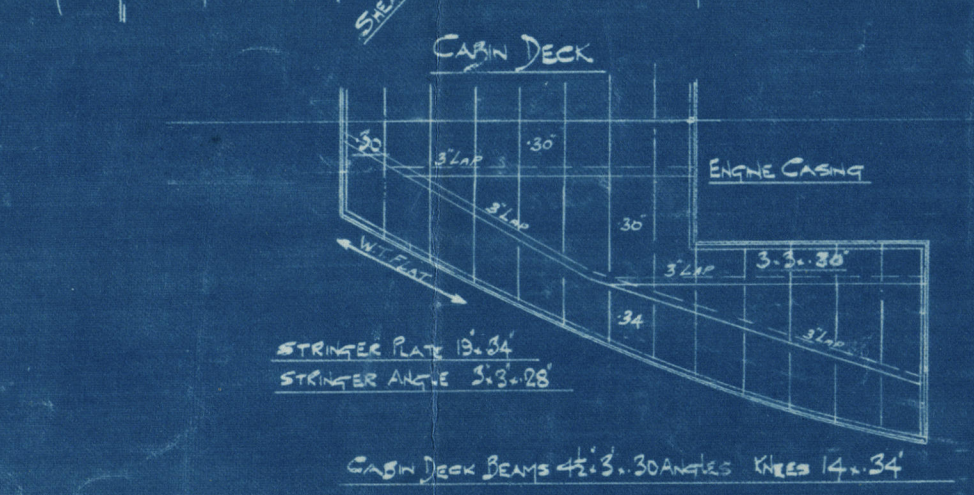
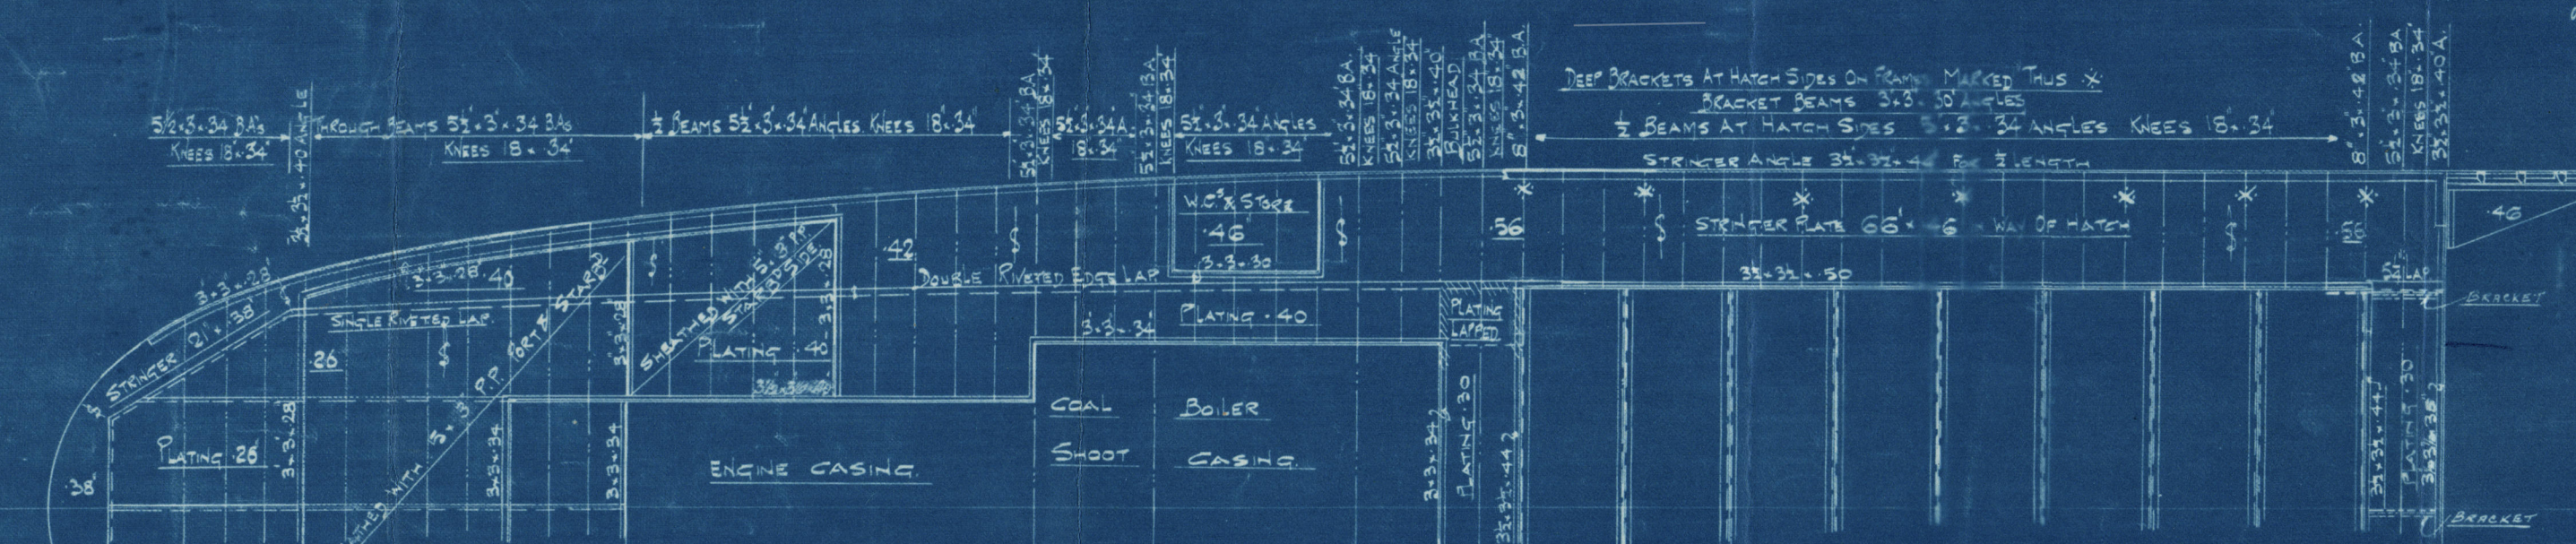
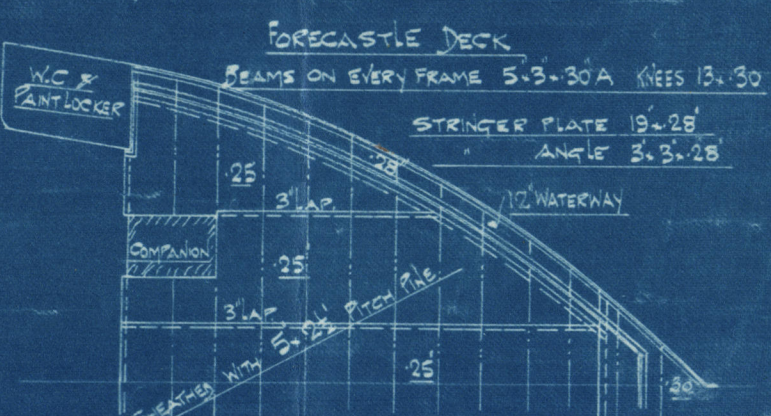
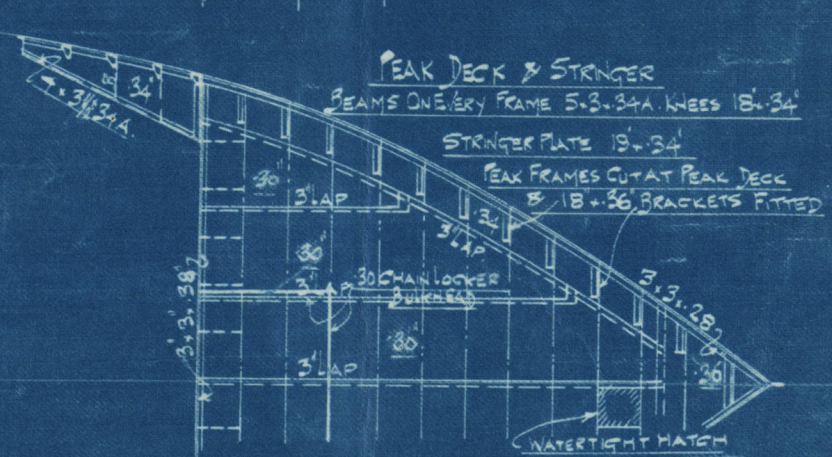
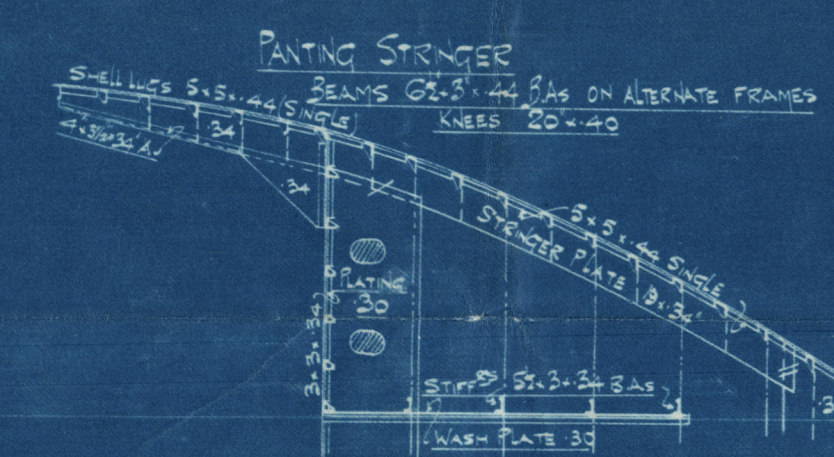
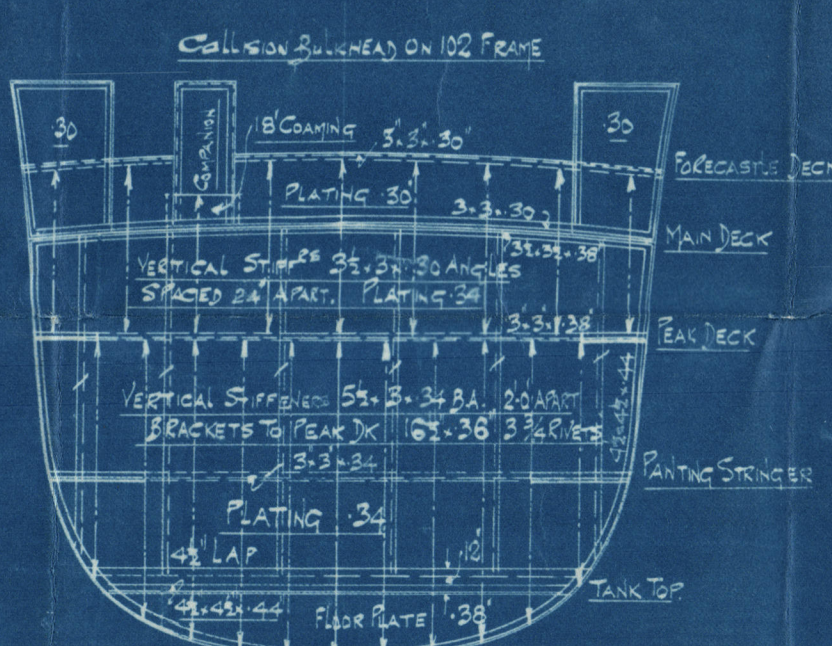
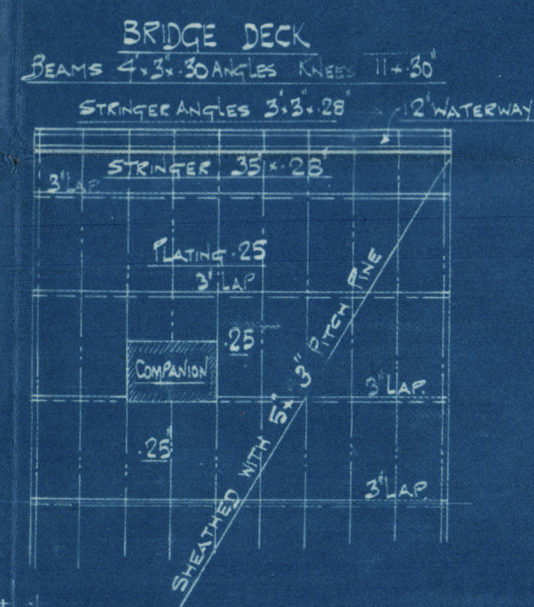
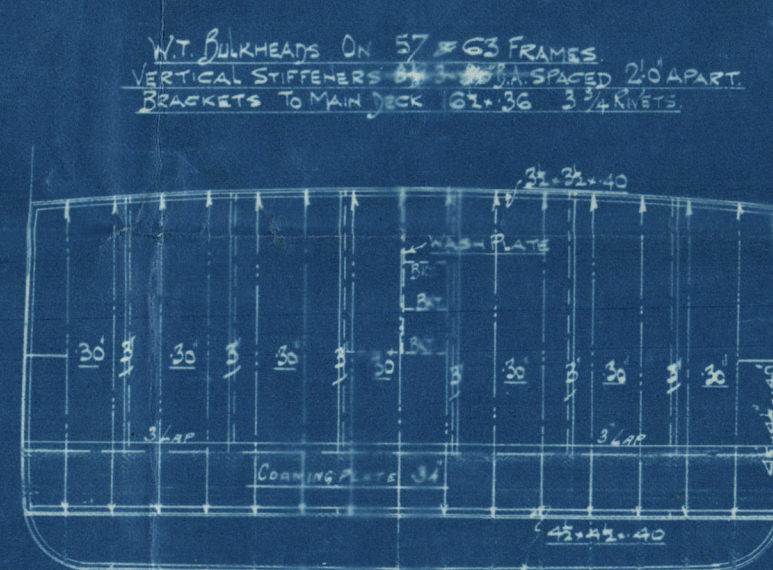



FREEDBOARD PARTICULARS	
LENGTH BETWEEN PERPENDICULARS	217.0'
AT LOAD WATER PLANE	216.8'
BREADTH EXTREMES	32.0'
DEPTH MOLDED	15.6'
DEPTH OF HOLD	13.55'
SHEER FORWARD	3.7'
5" FROM FORWARD	2.0'
AFT	1.9'
5" FROM AFT	1.0'
LENGTH OF RAISED QUARTER DECK	105.6' x 3.0' ABOVE MAIN DECK
BRIDGE	170.0' x 7.0'
SINK FORECASTLE	25.0' x 3.0' LINE DECK
COEFFICIENT OF DISPLACEMENT	751
UNDER DECK TONNAGE	776 TONS
RAISED QUARTER DECK TYPE	DEEP RULL ANGLE FRAMES
NOSE ON TANK TOP	CARGO RATIONS TO BE FITTED

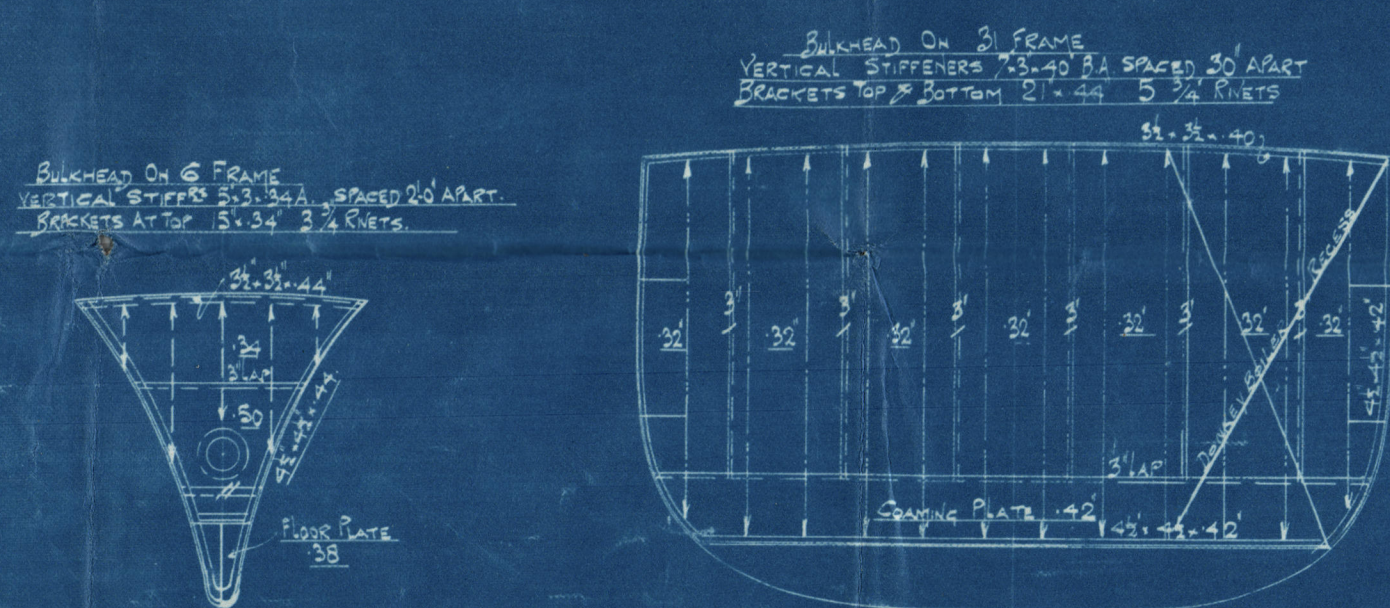

No. 291  
PROFILE 72 DECK PLAN.  
SCALE 5" = ONE FOOT.

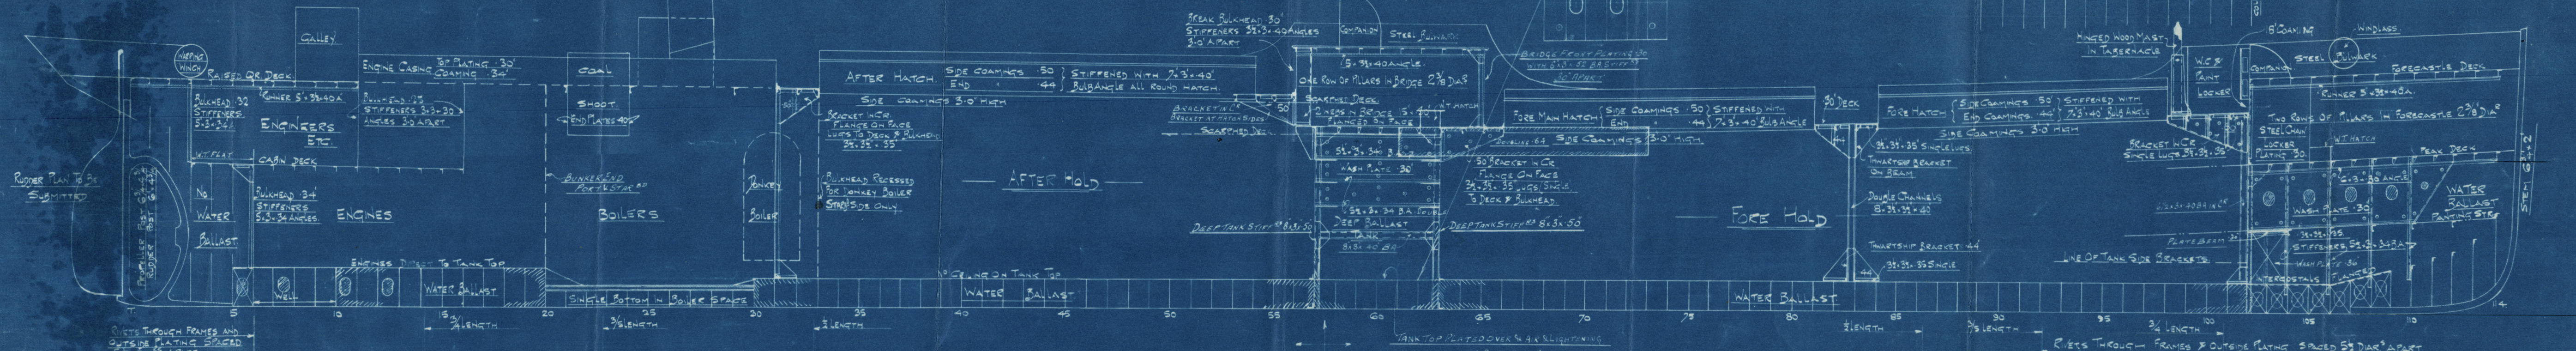

RAISED QUARTER DECK

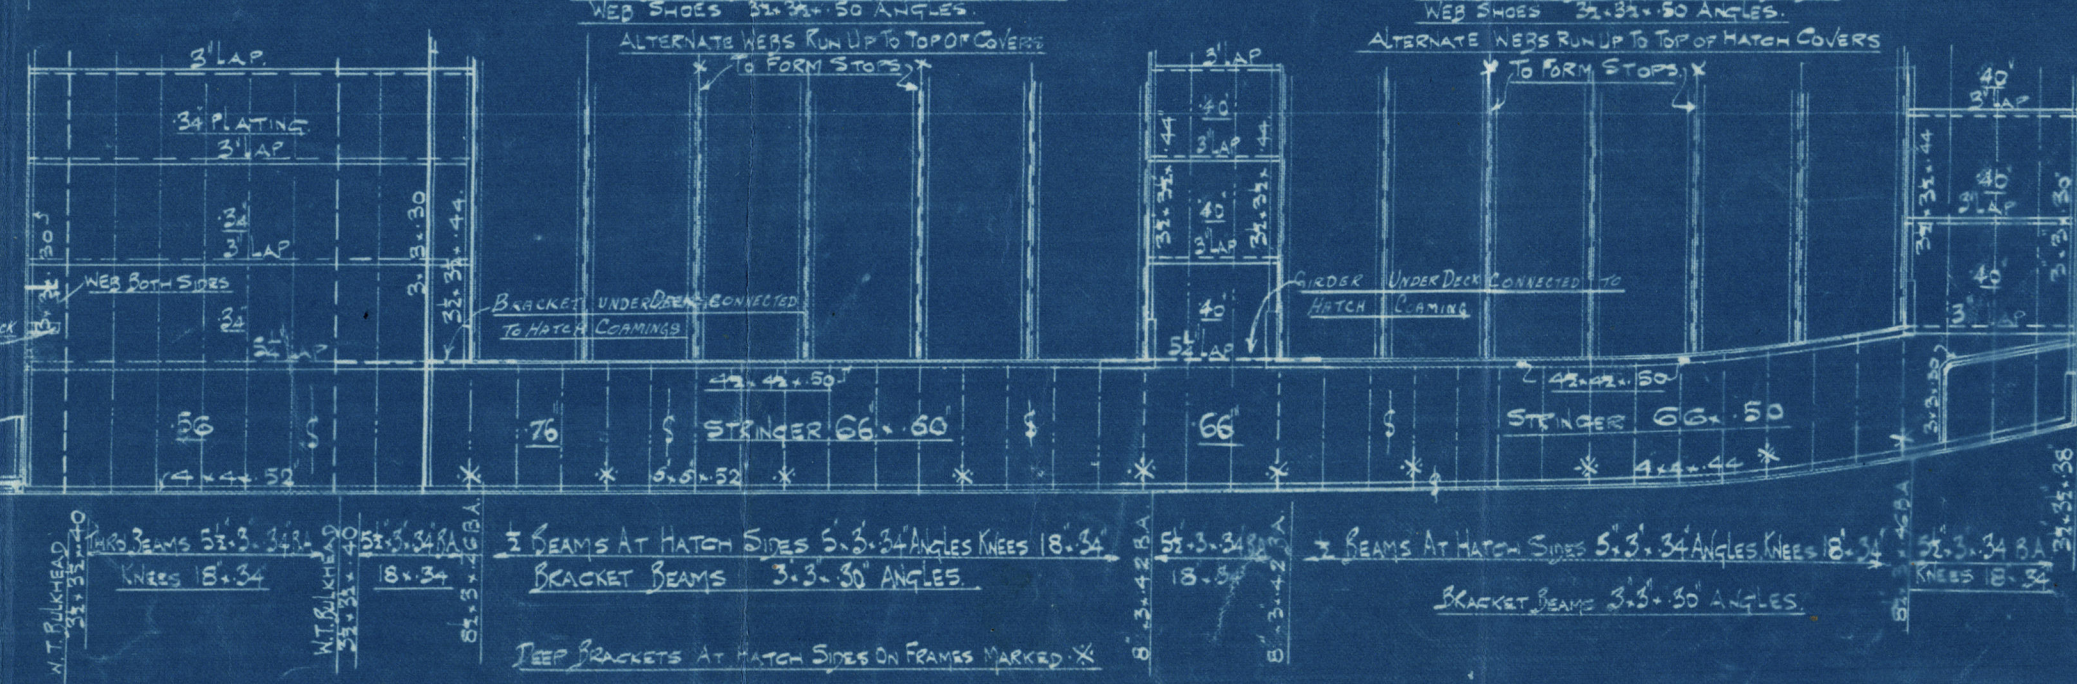

W395-0221



SUNDERLAND

MESSRS. S. P. AUSTIN & SON LD.

14° 291

PROFILE & DECK PLANS

(AS BUILT)

*Flashlight*

SUNDERLAND RPT. NO. 27855

RETAIN



© 2019

Lloyd's Register

W395-0221

Foundation