

S.S. ASPERITY



No 170

PROFILE & DECKS
OIL TANK STEAMER

DIMS: 187'-0" x 28'-0" x 13'-2" MLD LENGTH WL 186'-9"

SCALE 1/4" = 1 FOOT

CLASS 100 A1 AT LLOYDS CARRYING PETROLEUM IN BULK

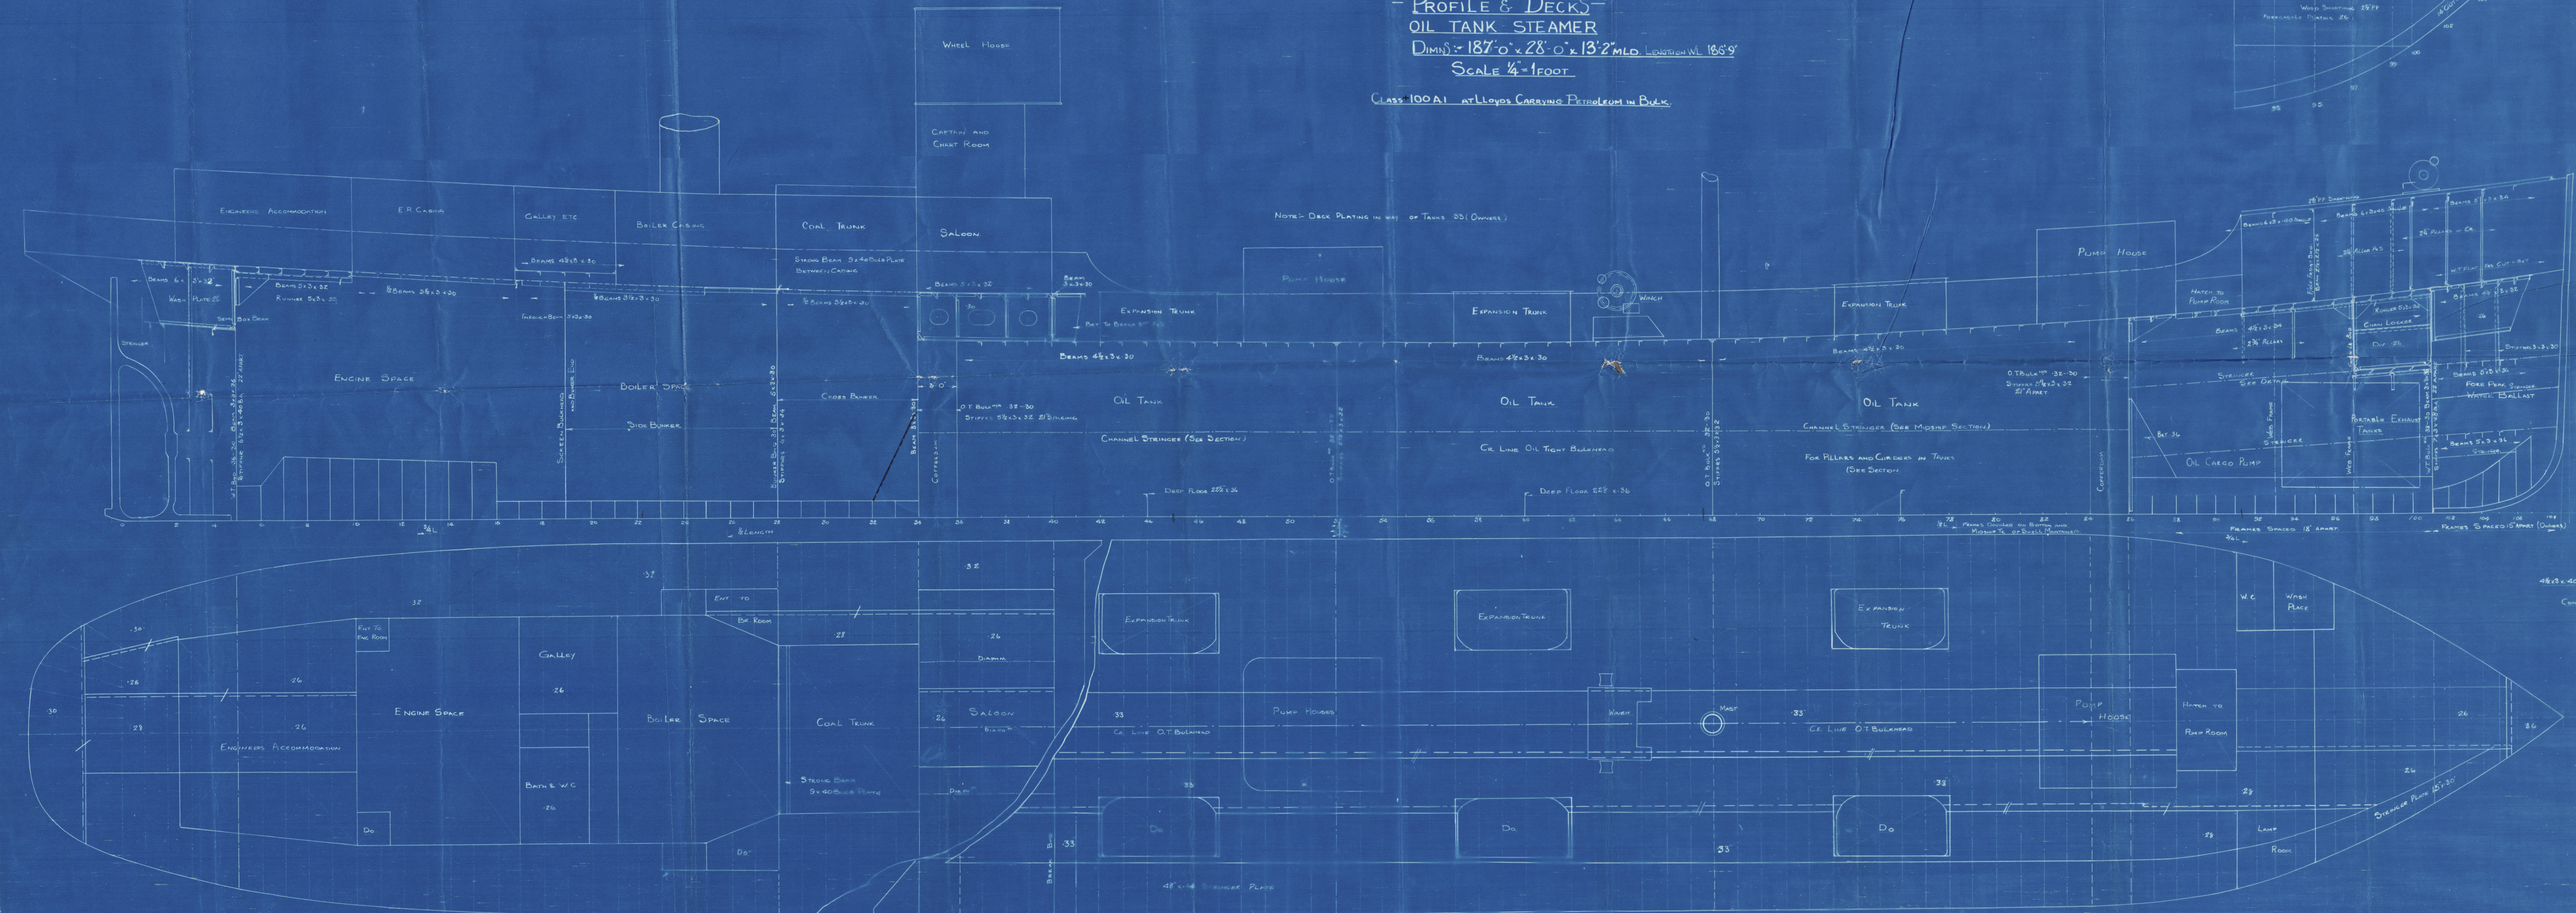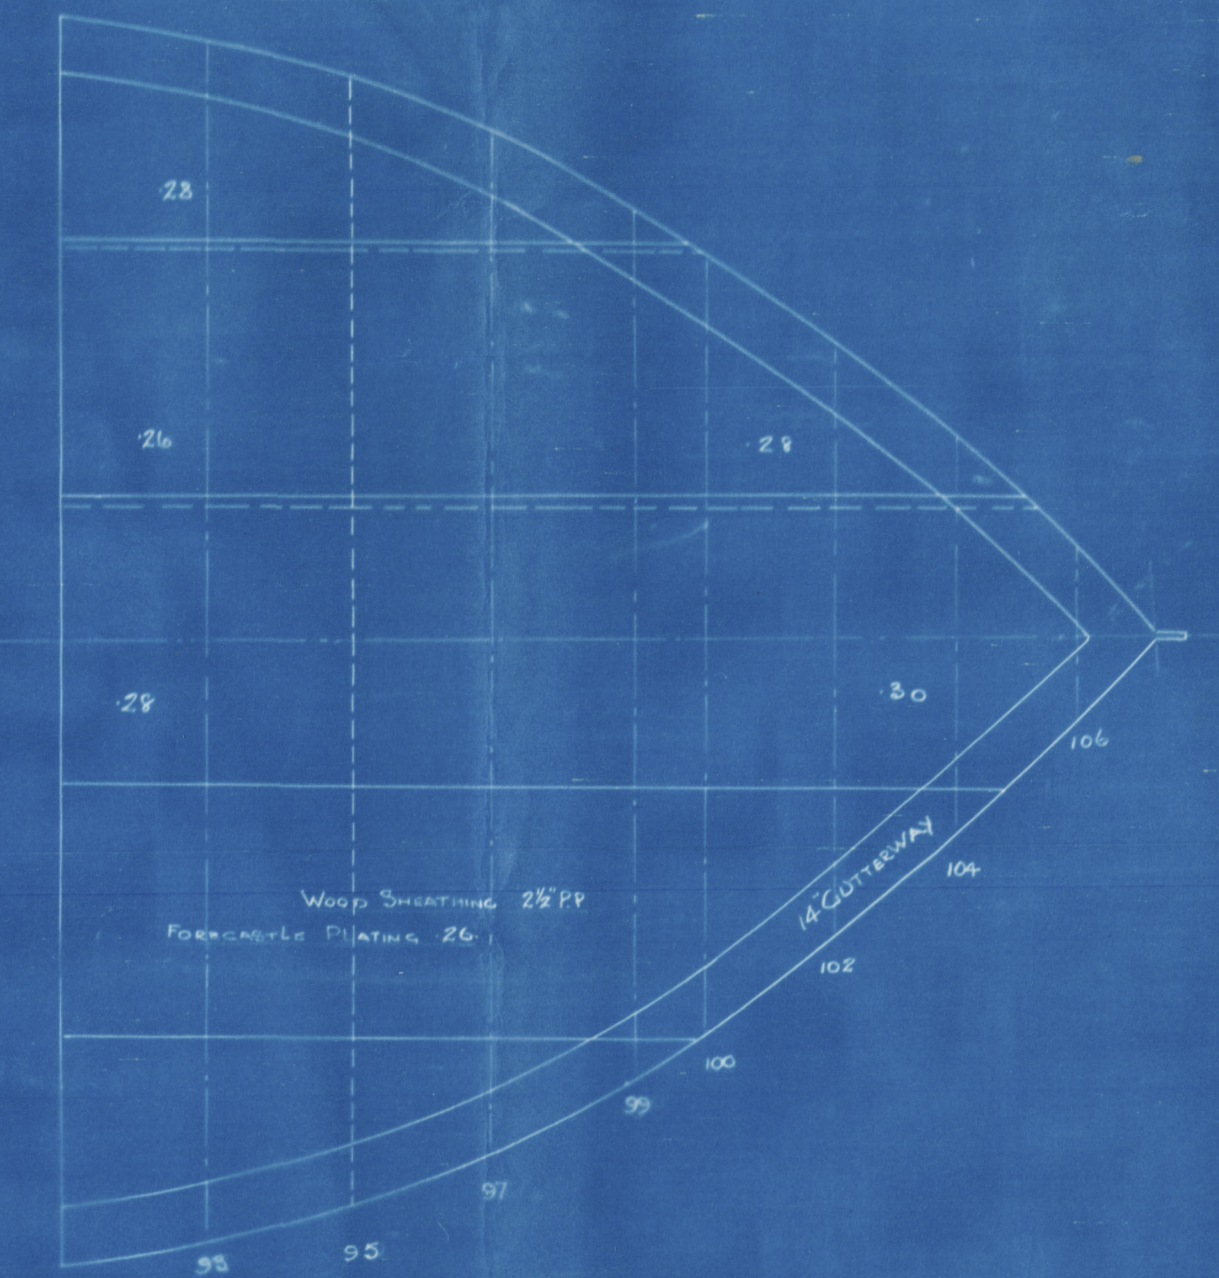

46.

SECTION OF STEAMER
(SEE DETAIL PLATE)

Geo. Brown & Co.
Oil Tanker.

ASPERITY

N. 170.

Profile & Deck Plans.
as Built.

Grk. Ref. N. 19097.



© 2021

Lloyd's Register
Foundation

W4-0221