

RULE EQUIPMENT.

NUMERAL	4 4 5 9 1
SHELTER TWEEN DECK	469 83
BRIDGE (each on each)	150
HOUSES	81
FORECASTLE	47
	4 8 8 8 8
2 BOWER ANCHORS	5 1/2 CWTs EACH STOCKLESS
1 STREAM	2 1/2 EX. STOCK
300 FATHOMS	2 9/16 STUD CHAIN CABLE
120 "	5 1/4 STEEL WIRE
130 "	6 " TOWLINE
4 100 "	8 MANILLA HAWSEERS & WARPS
1 KEDGE ANCHOR	12 CWTs EX. STOCK

S.S. N° 596 A. MIDSHIP SECTION.


NUMERALS	62 16
MOULDED BREADTH	32 75
LENGTH	94 91 19 N°
	449 83
L/D TO SHELTER DECK	11 5
L/D TO BRIDGE DECK	9 63

470-0 B.P. x 62-2 M.P. x 32-9 M.P.

To CLASS 100A.I. AT LLOYDS.

SCALE 1/2 INCH = 1 FOOT.

FORECASTLE.
SIDE PLATING .44 BUTTS DOUBLE.
FRAMES 8' x 3 1/2" x 48 B.A.
BEAMS 8' x 3' x 60 B.A. TO 8' x 3' x 42 B.A.
EVERY FRAME 2 ROW. KNEES 26' x 48'
STRINGER 38' x 38' BUTTS DOUBLE.
" ANGLE 3 1/2" x 3 1/2" x 28'
DECK PLATING .30 BUTTS SINGLE.
PILLARS 2 ROWS 3" DIA.

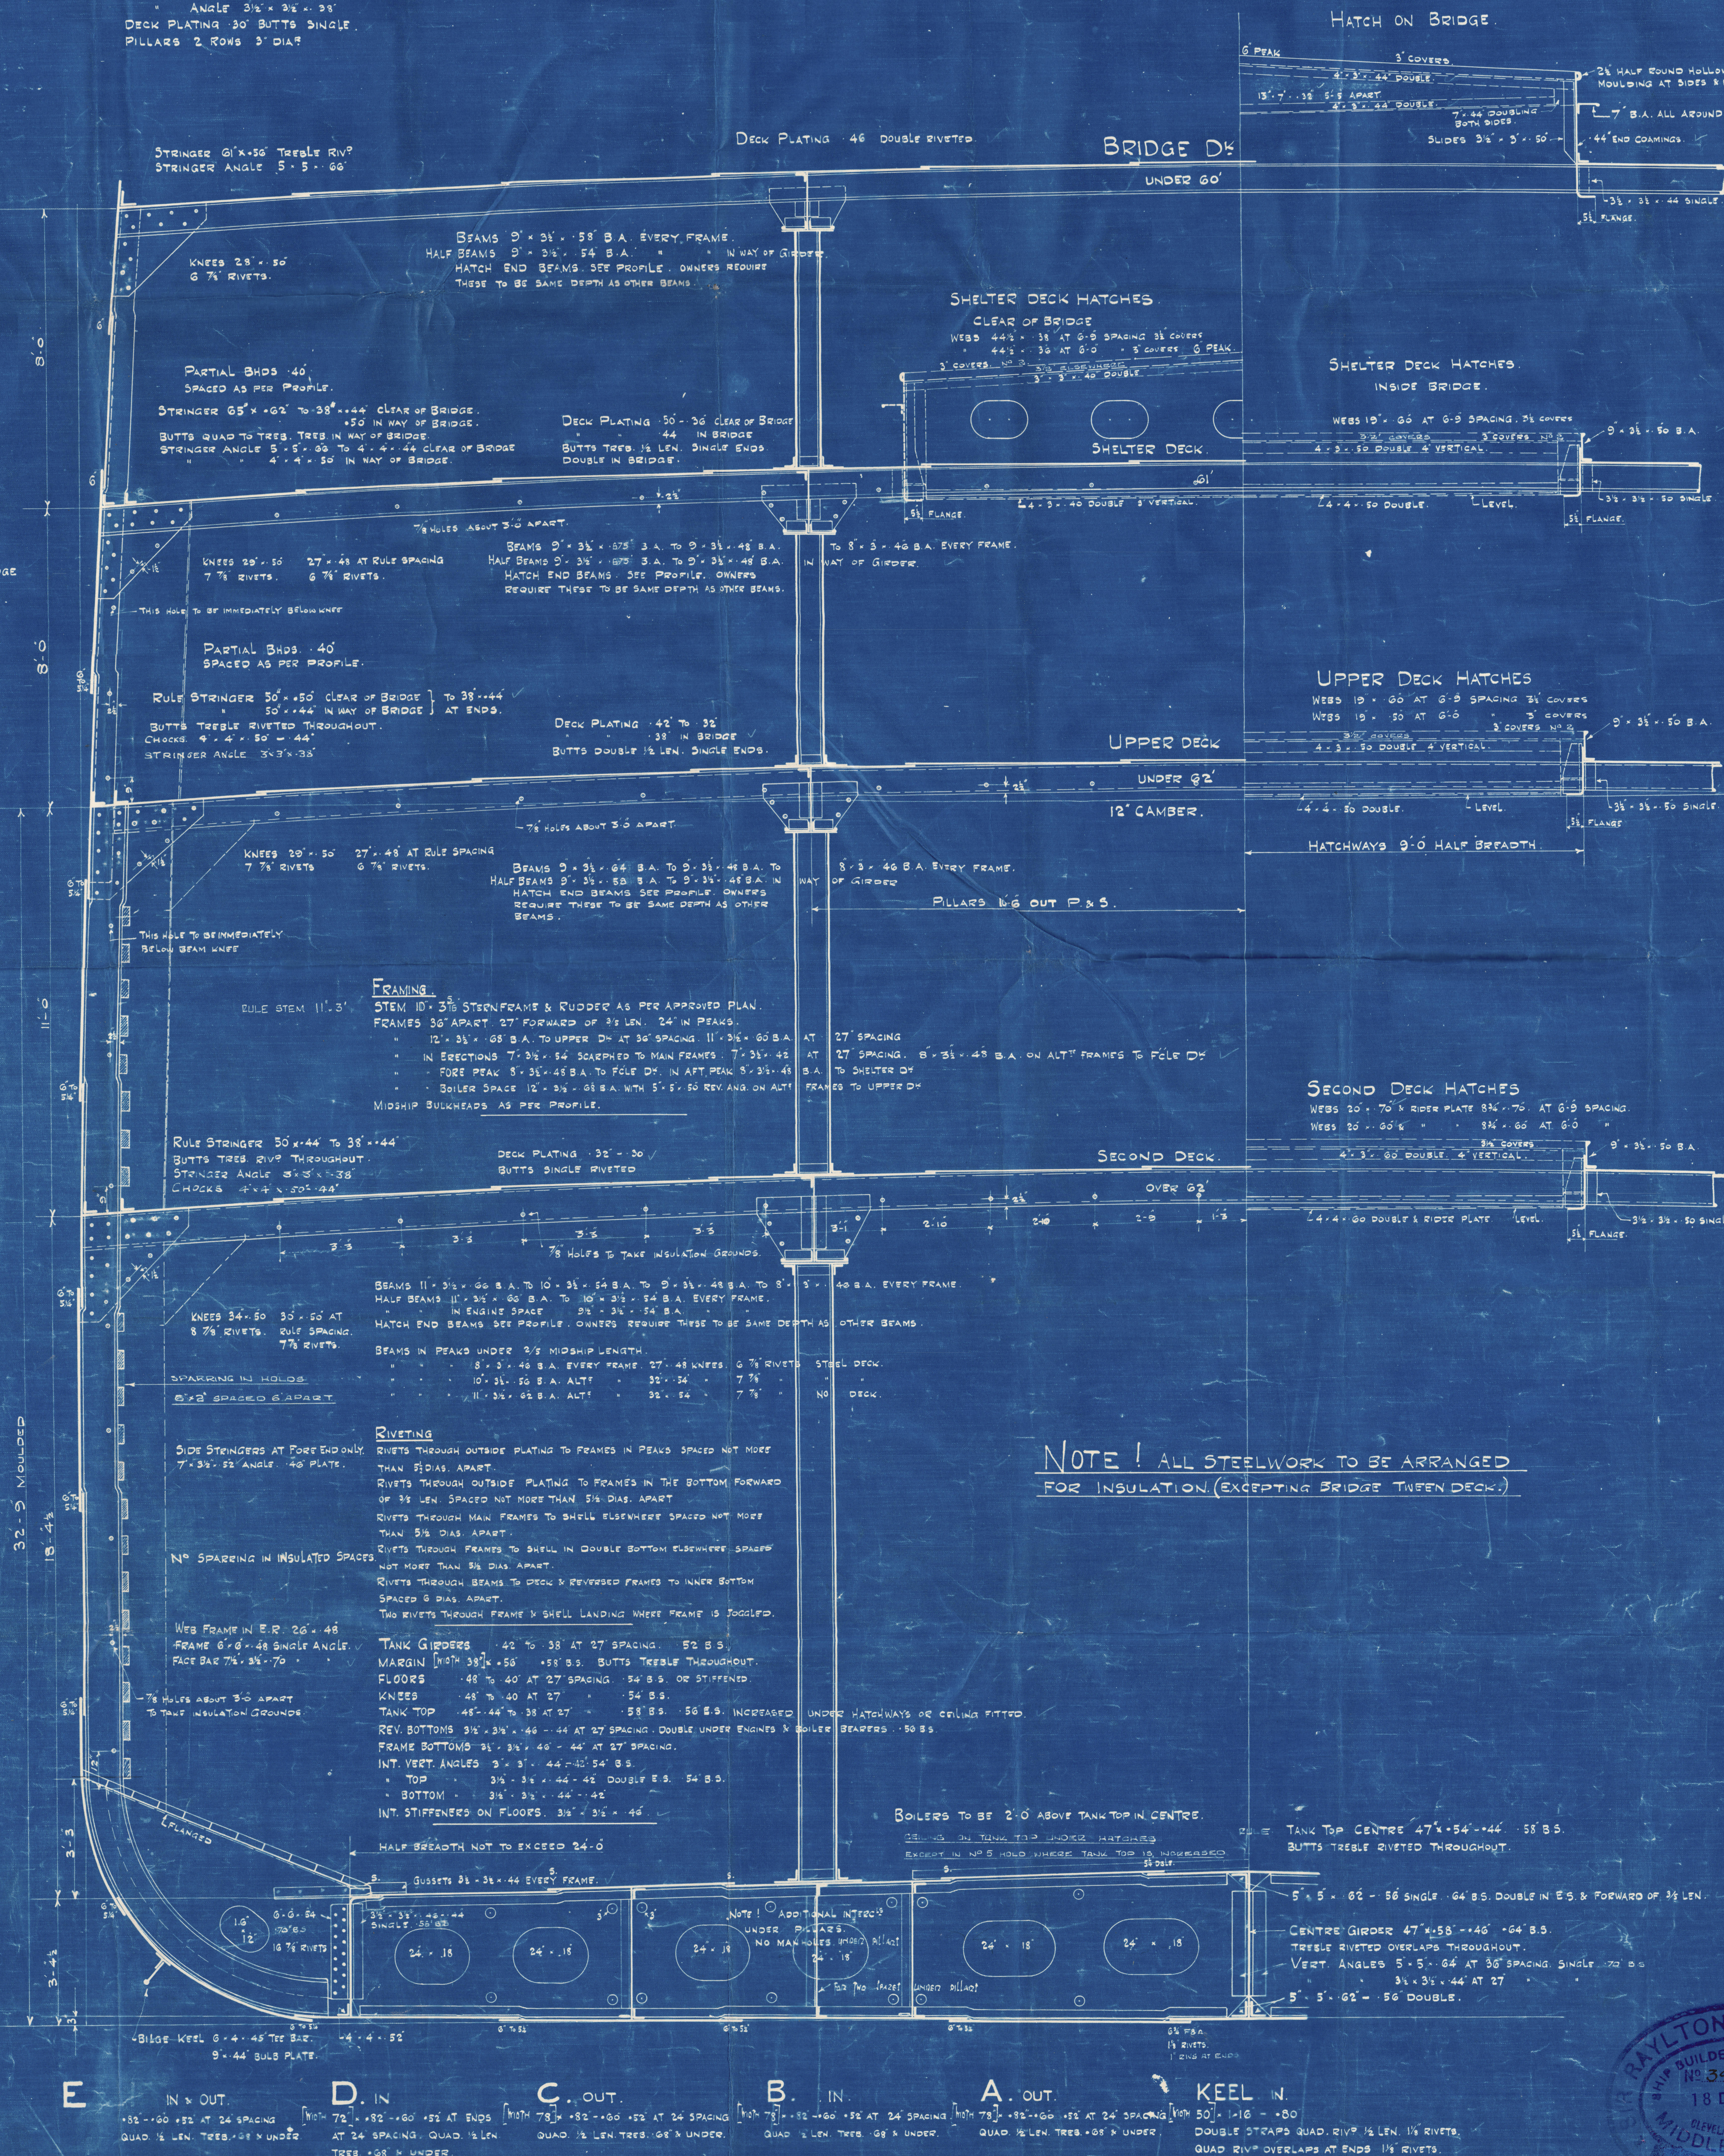

A.B. & C STRAKES TO MAINTAIN THEIR MIDSHIP THICKNESS FORWARD TO COLLISION SHD.
HALF DEPTH INTERCOSTALS FORWARD TO RULE REQUIREMENTS.



MESSRS SIR R. DIXON & CO.

No 596 a


S.S. HURUNUI

MIDSHIP SECTION ✓

AS BUILT.

MIDDLESBRO' 10931

REMAIN

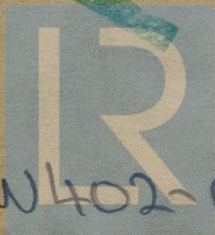

© 2020

Lloyd's Register
Foundation

W402-0149