

MIDSHIP SECTION S.S. NO 366.


Scale $\frac{1}{2}'' = 1 \text{ ft.}$

Length on L.W.L. 363-0'. Breadth Mid. 51-33'. Depth Mid. to Upper Dk 25-0'.

TO CLASS 100 A.I.



Poop Dk Stringer Plt. 33' 34"
" " " Bar 3 1/2" x 3/4"
Focle " " Plt. 33' 34"
" " " Bar 3 1/2" x 3/4"

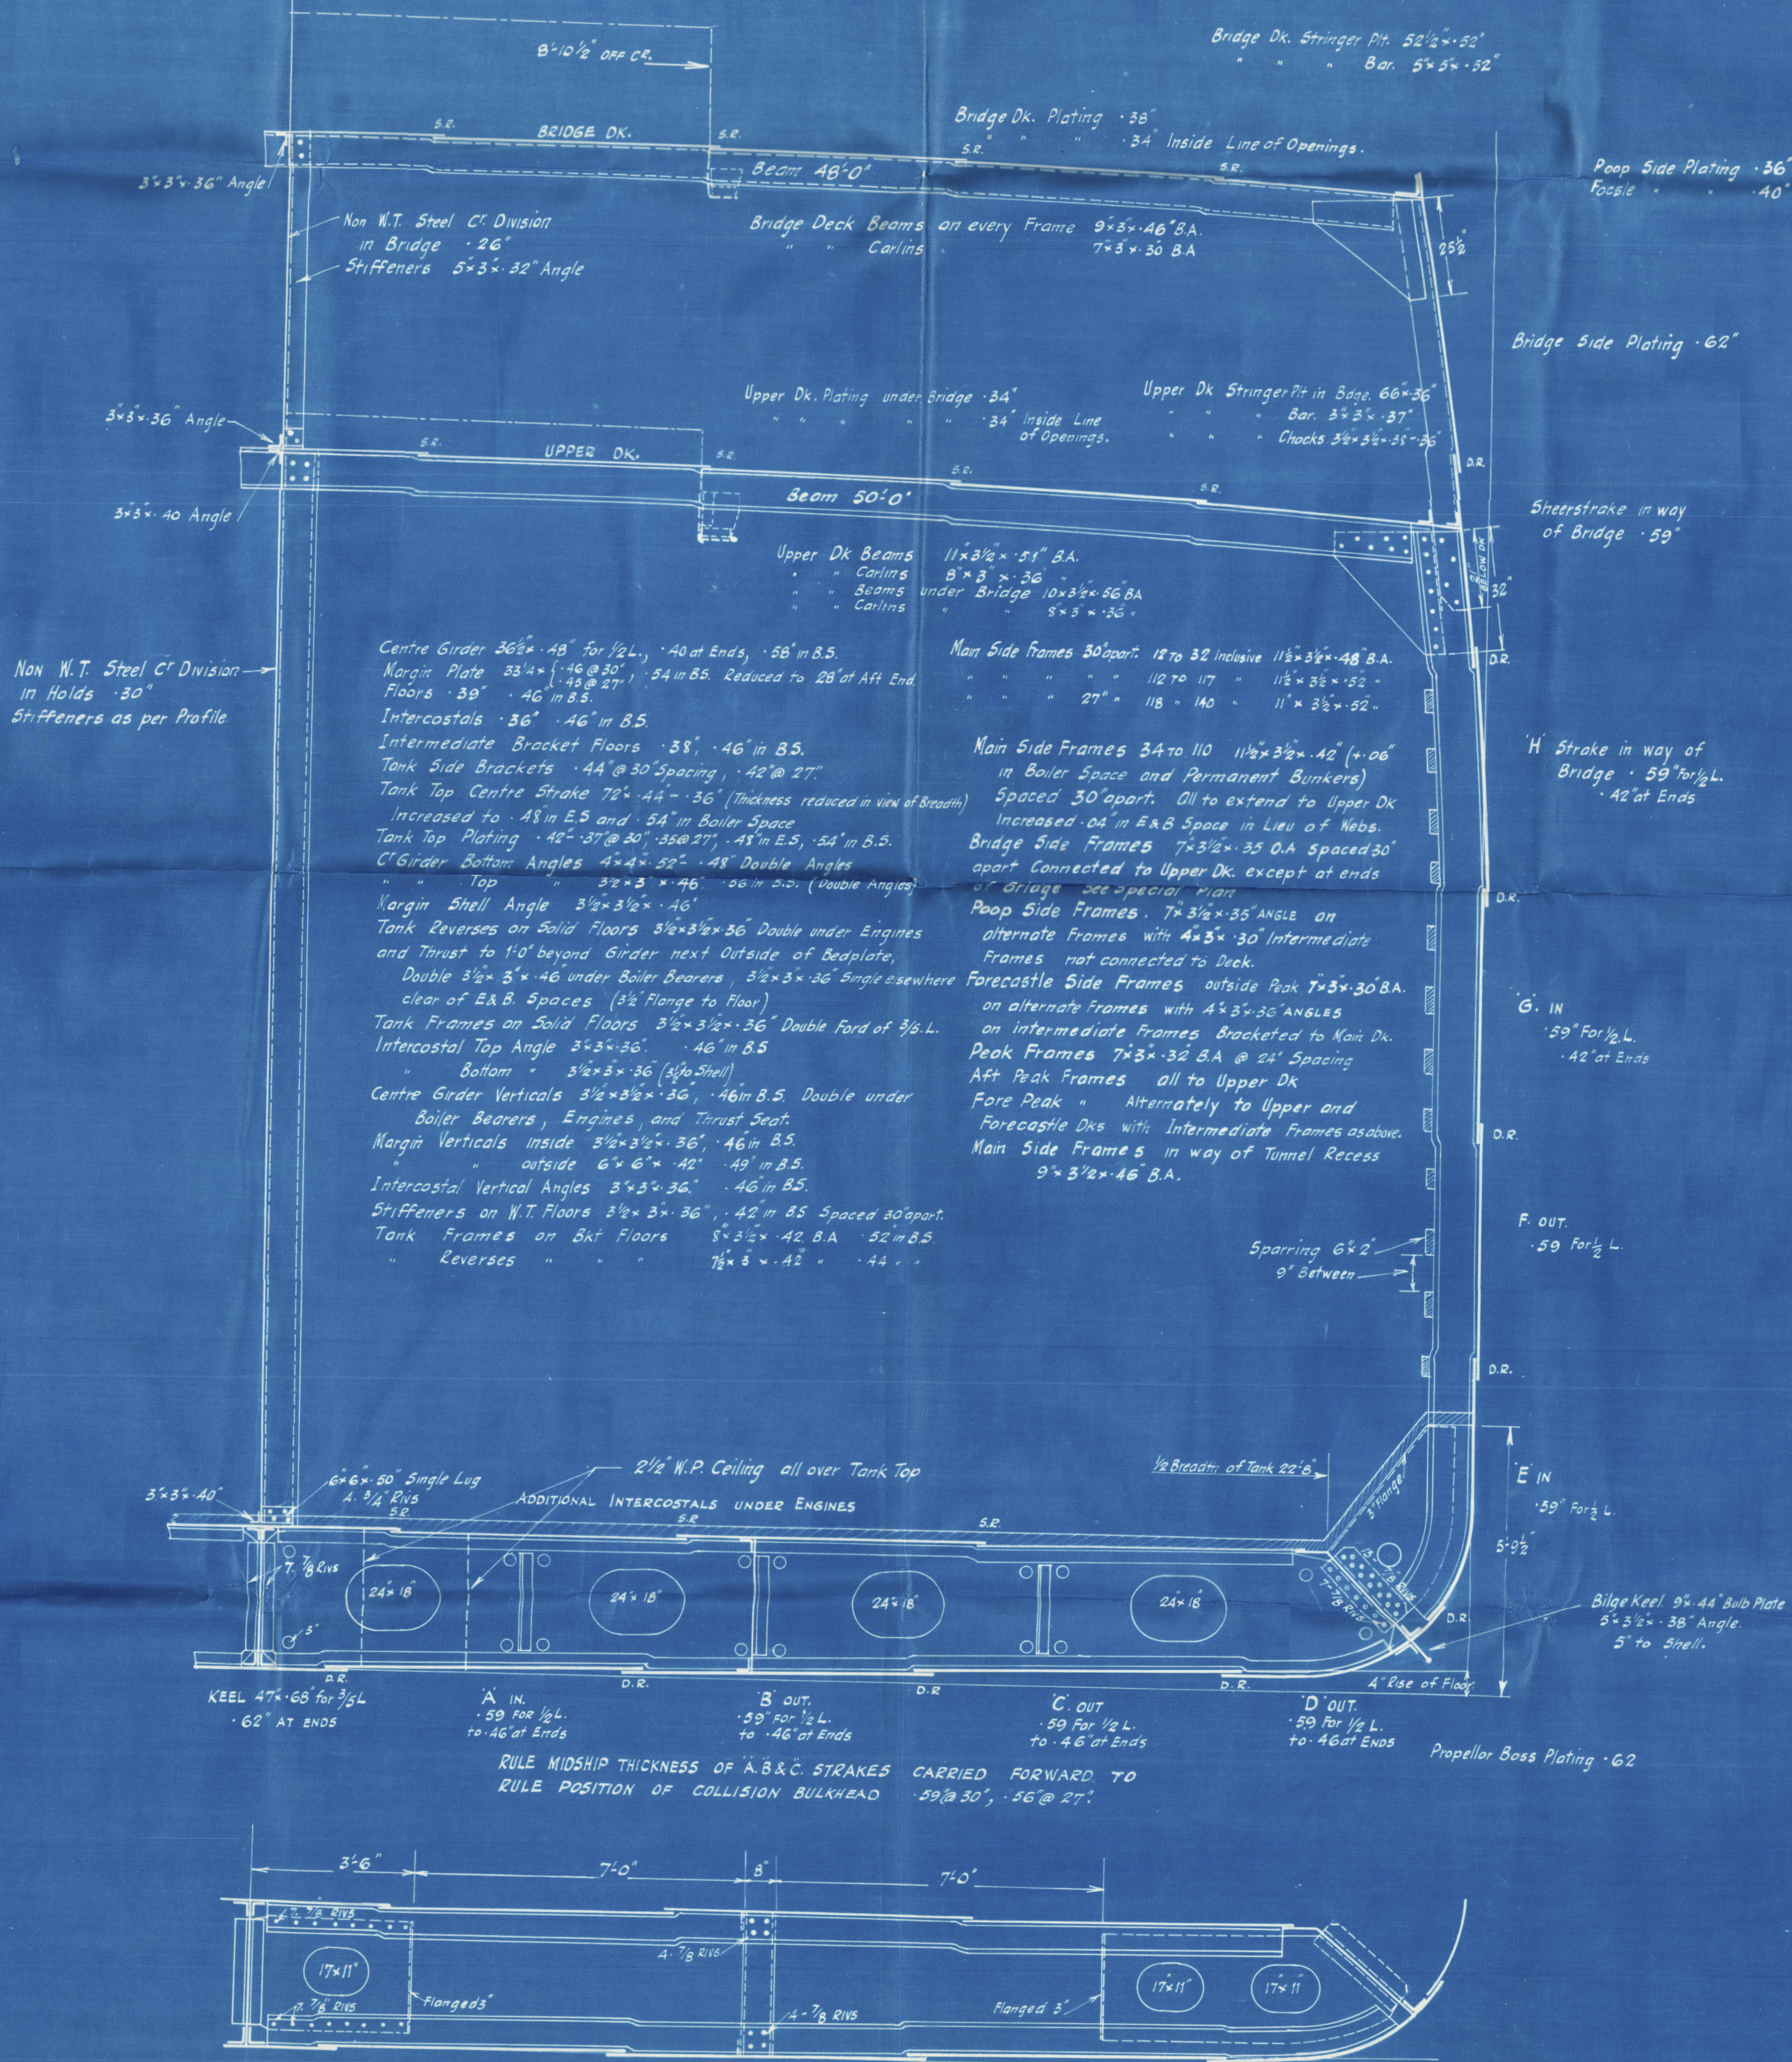

R DUNCAN & Co

Nº 366

S. S. GRAIGWEN


MIDSHIP SECTION

As BUILT.

GREENOCK REPORT Nº 18500

RETAIN

W403.-0113

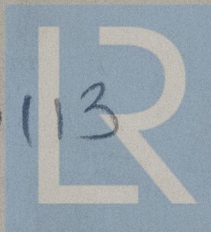

© 2020

Lloyd's Register
Foundation