

Sunderland.

Meen Short Brecked

Massey Section

S/S No. 427

S. S. Holy stone

(As Built)

Report No. 29601

WHT 0149



© 2019

Lloyd's Register
Foundation

SECTION IN WAY
OF DEEP TANK.




BRIDGE DECK PLATING: 14 3/16 BETWEEN HATCHES (SEE DECK PLAN).
FORECASTLE STRINGER 30. FORECASTLE DECK 30. BUTTS SINGLE.
POOP STRINGER 30. POOP DECK 28 (SHEATHED WITH 2" PINE). BUTTS SINGLE.

— MIDSHIP SECTION —

— S.S. 427 —

— SCALE 1/2" = ONE FOOT —

S.S. "HOLYSTONE"

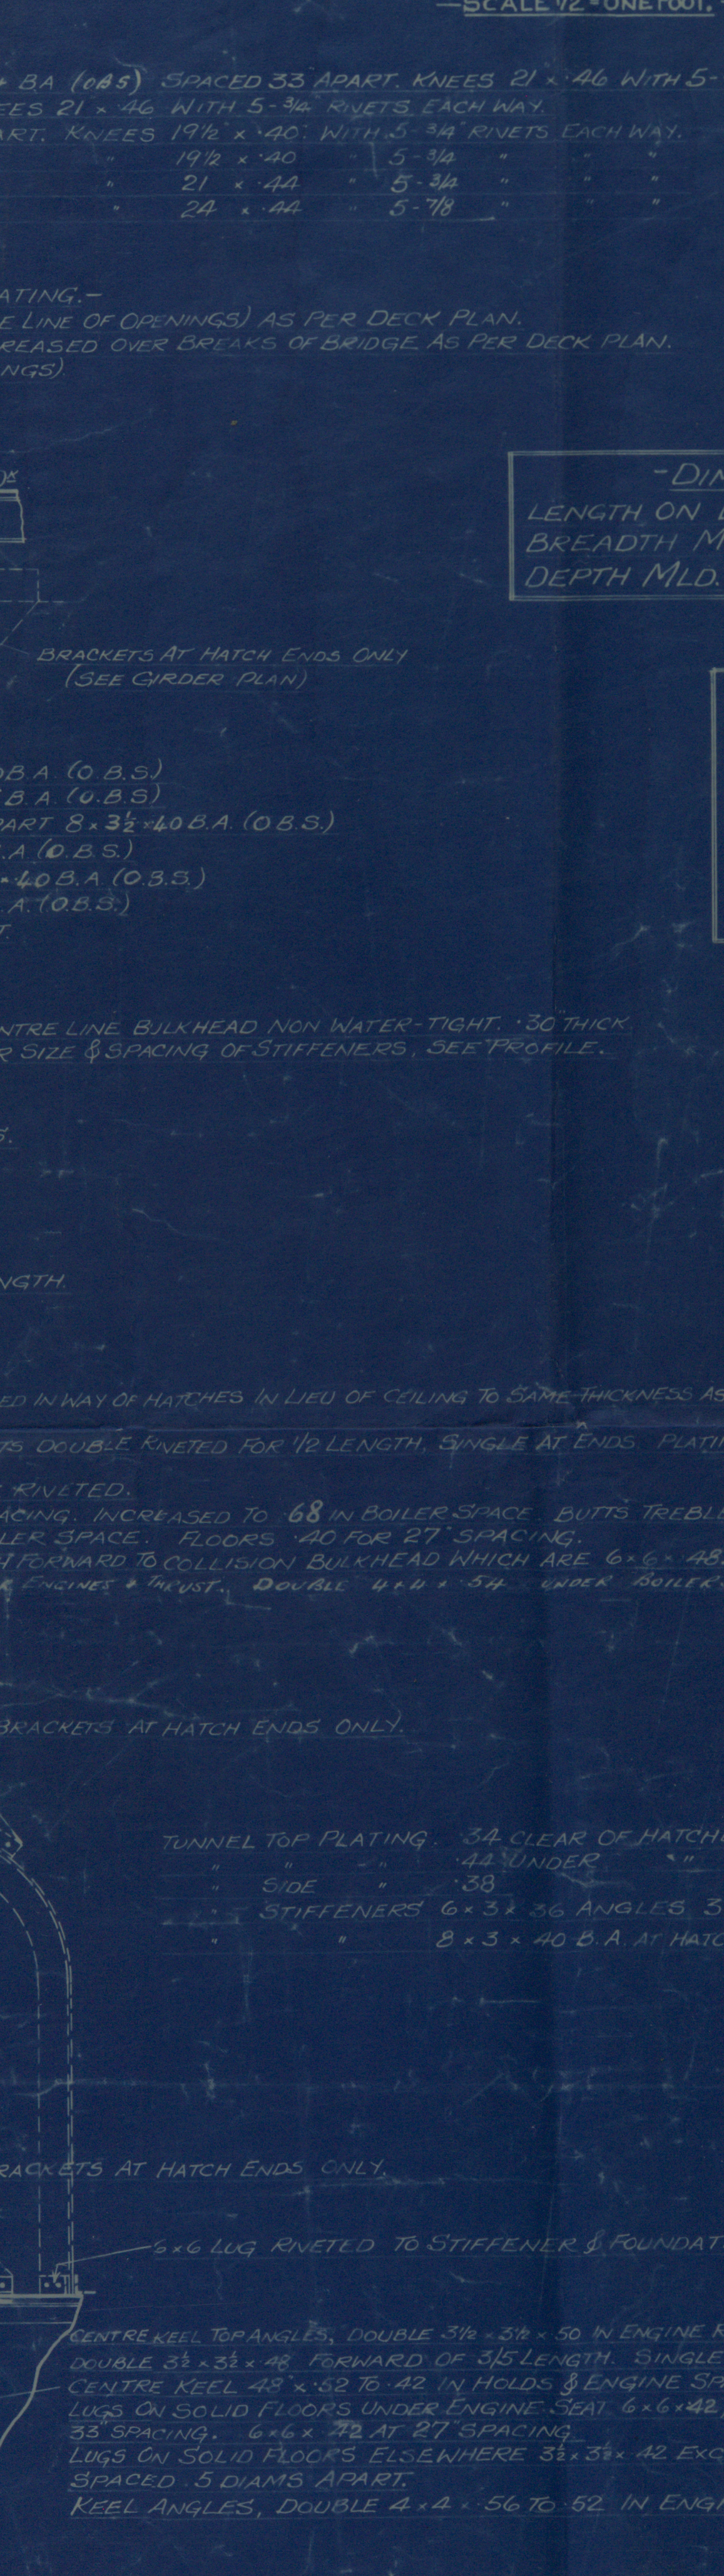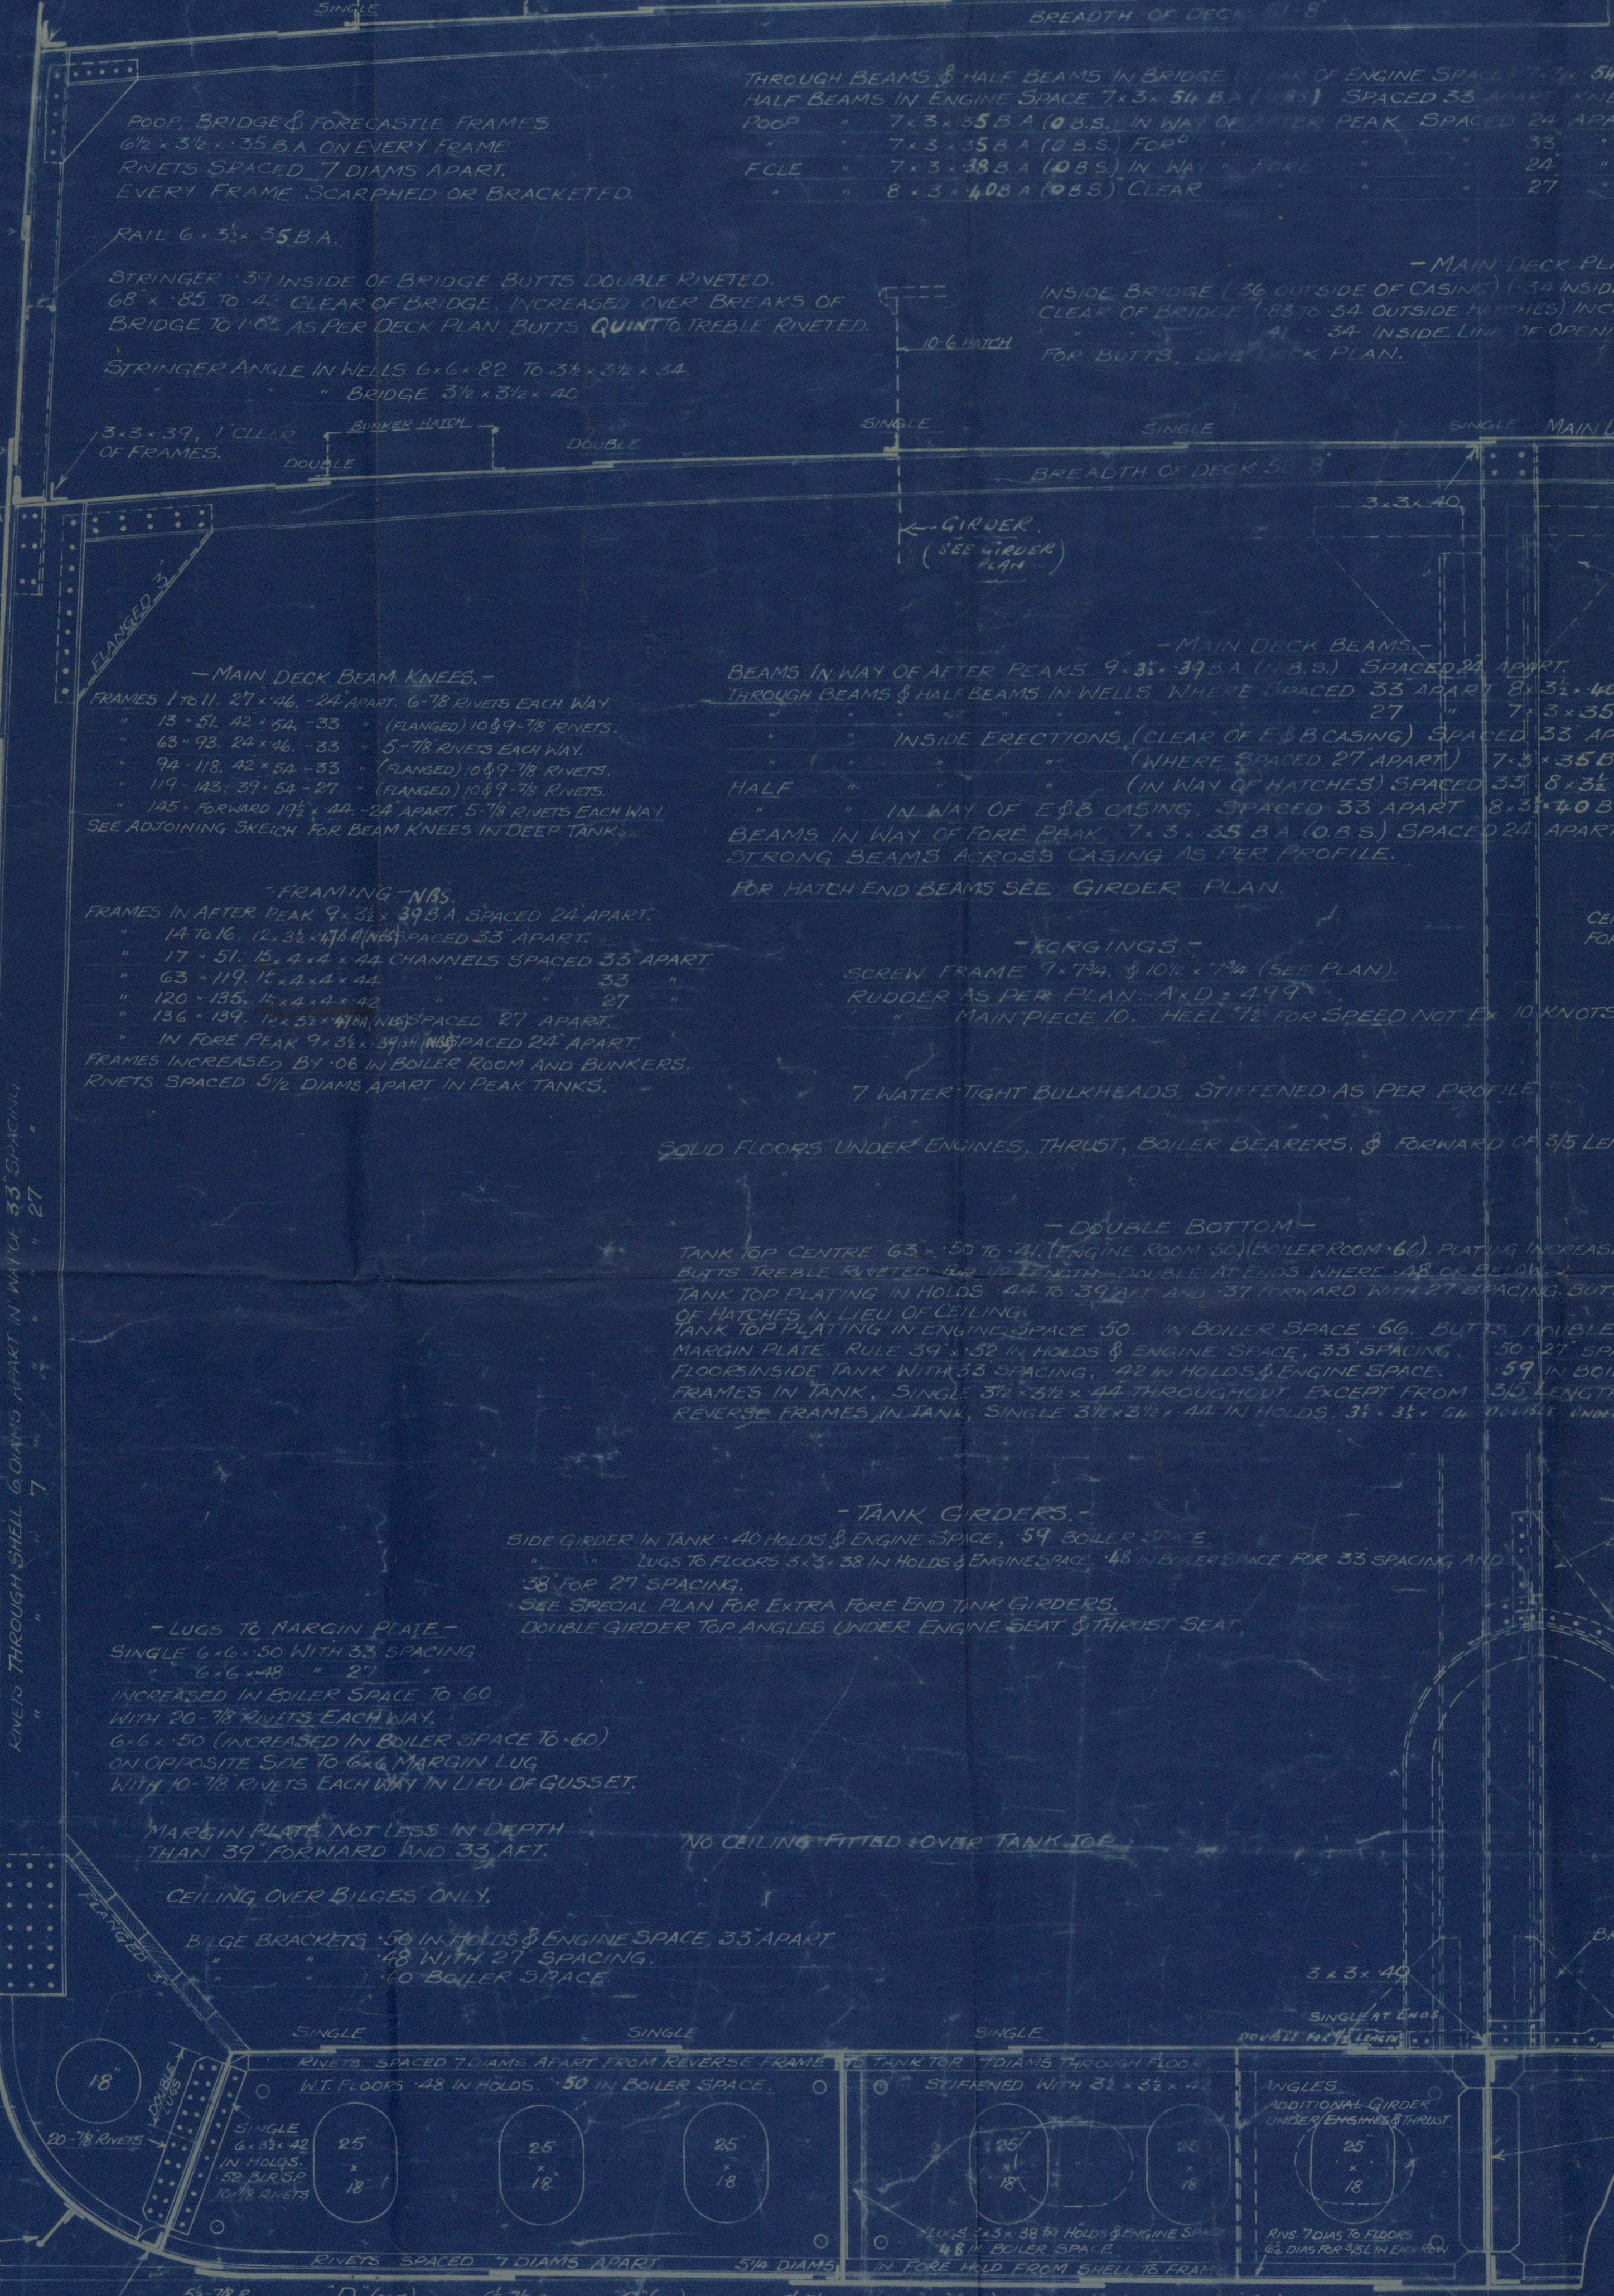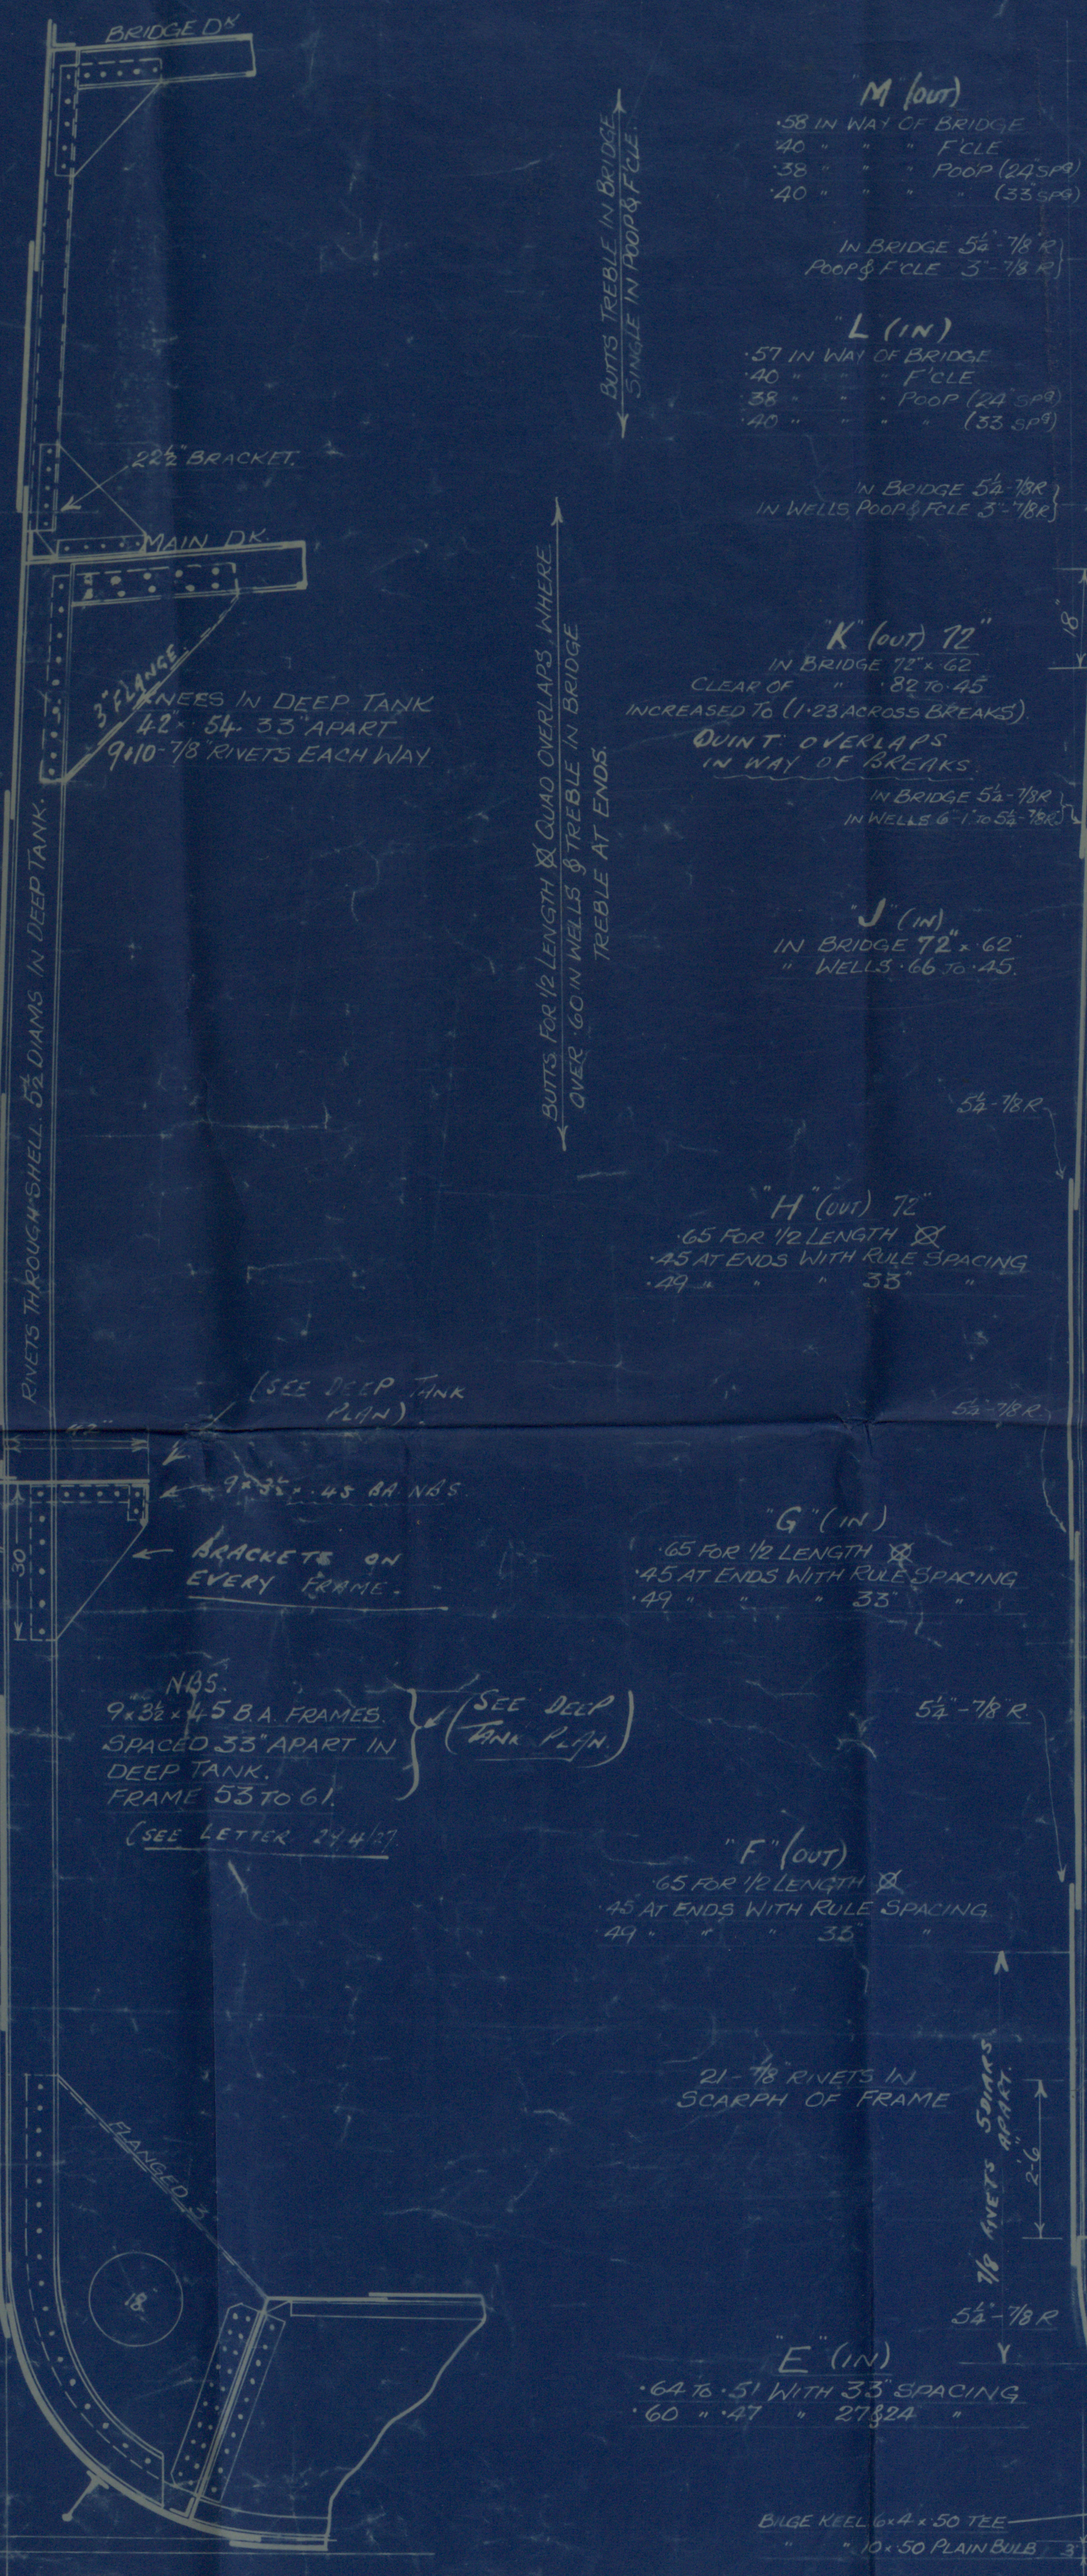

— DIMENSIONS —
LENGTH ON L.W.L. 397.25'
BREADTH M.L.D. 53.66'
DEPTH M.L.D. 31.5'

— LLOYD'S NUMERALS —
L x D = 397.25 x 31.5 = 12513.
L x (B+D) = 397.25 (53.66 + 31.5) = 33830
1/4 TO MAIN DECK = 12.61
1/4 TO BRIDGE DECK = 10.04
d = 31.6 - 3.94 = 27.66
KNEES INCREASED IN DEPTH TO 90. d = 26.77
ERECTIONS 14.99% OF LENGTH OF SHIP

— CLASS. 100 A1 LLOYD'S —

— OUTFIT NUMBER —
L x (B+D) 397.25 x 85.16 = 33830.
POOP = 33
BRIDGE = 112.75
FORECASTLE = 35.5
181.25 x 8 x 34 = 1087.
HOUSES:
SALOON HOUSE 20
CASING & ENG'G " 57.9
77.9 x 8 x 31.1
35228

— OUTFIT —
2 STOCKLESS ANCHORS 63 3/4 CWT. EACH.
1 " " 54 1/2 " " (EX-STOCK)
1 STREAM " 17 1/2 " " (EX-STOCK)
270 FATHOMS 2 1/4" STUD CHAIN CABLE
" 4 1/4" STEEL STREAM WIRE
120 " 5" TOW LINE (STEEL WIRE)
2-90 FATHOMS 2 3/4" STEEL OR 8" HEMP
2-90 " 2 1/2 " 7 "

BUTTS OF SHELL FROM "B" TO "J" INCLUSIVE TREBLE OVERLAPS THROUGHOUT.
BUTTS OF "A" STRAKE, QUADRUPLE RIVETED FOR 1/2 LENGTH, TREBLE AT ENDS.
SIDE SHELL 61 TO 45 FROM 3/5 LENGTH FORWARD TO STEM.

PLAN No. 1426
DATE - 2 1-28

SHORT BROS. LIMITED,
SHIPBUILDERS,
SUNDERLAND.