

No 51.

PROFILE & DECK PLANS.

DIMENSIONS:- 244'-6" B.P. 37'-10" M.P. 19'-7" M.P. TO UPPER DECK


TO CLASS 100 A.I. LLOYDS

SCALE 1" = ONE FOOT


NO SHEER ON FREEBOARD DECK EXCEPT THAT DUE TO 9 CAMBER

MINIMUM SCANTLINGS REQUIRED


BRIDGE DECK

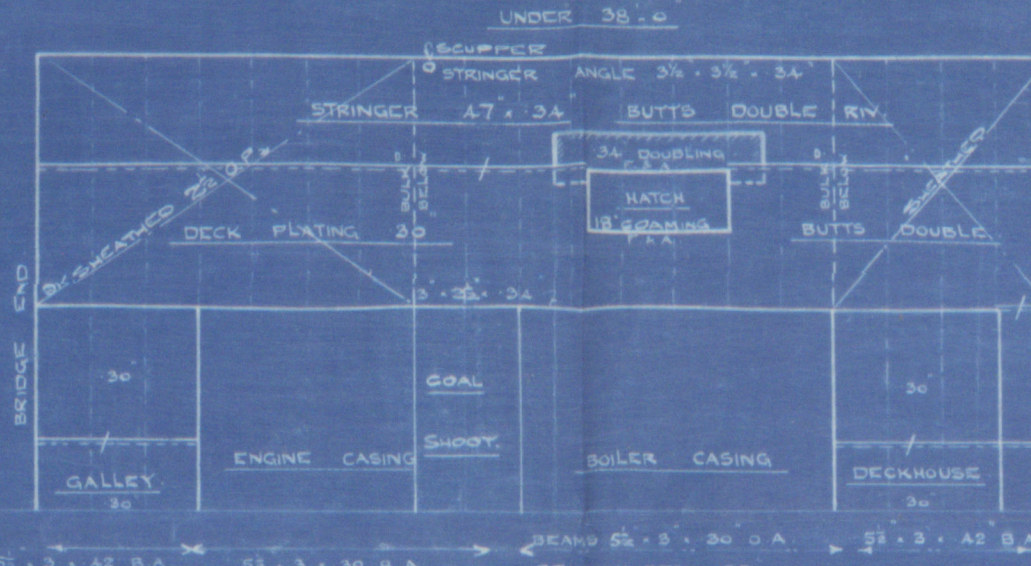


DETAIL OF UPPER DECK IN WAY OF BUNKER

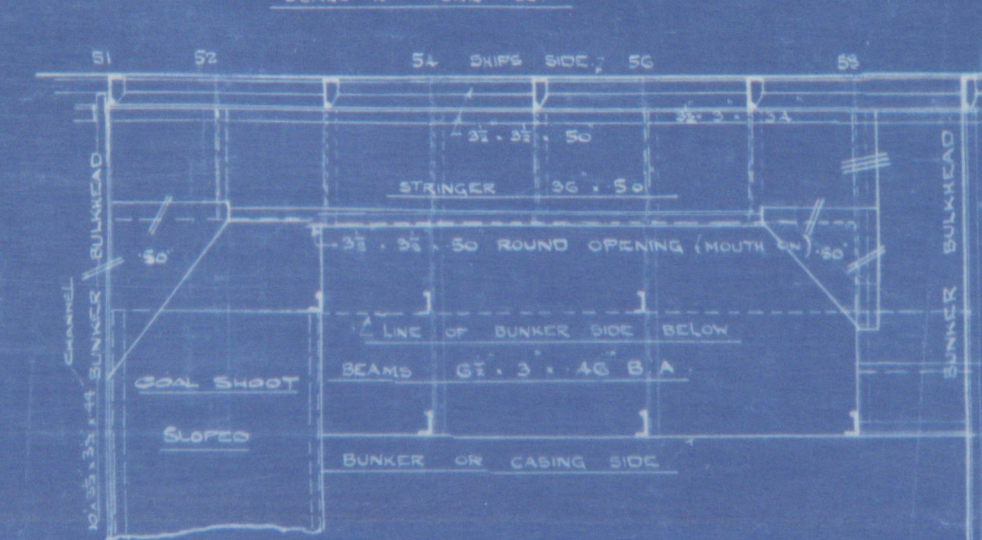

UPPER DECK

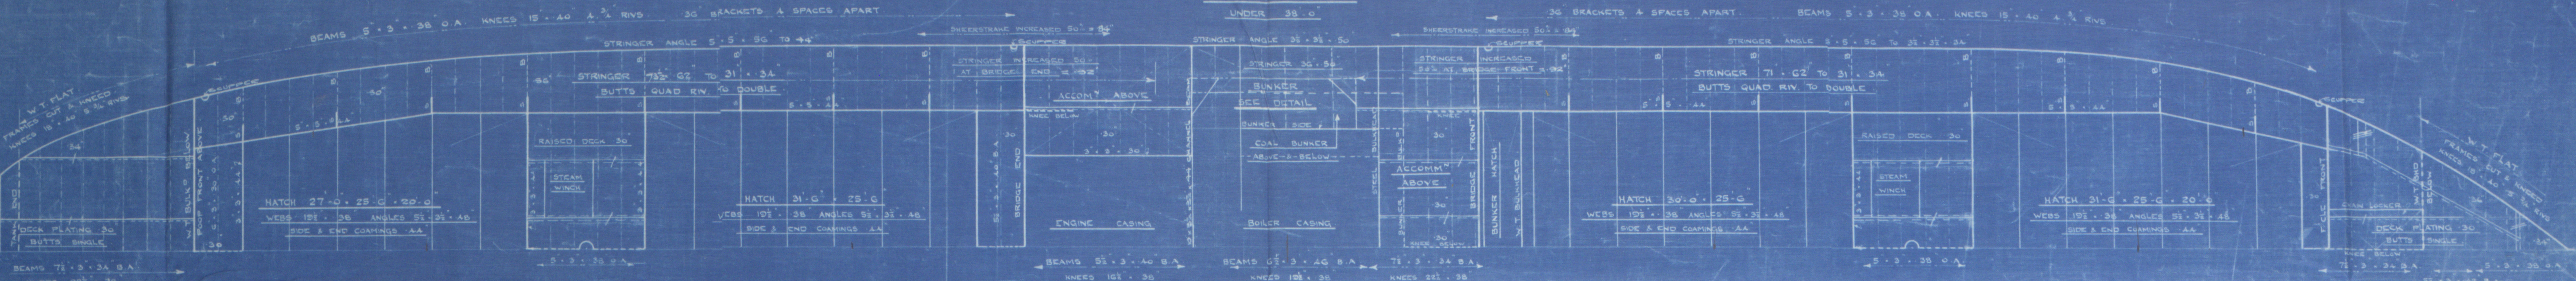

TANK TOP

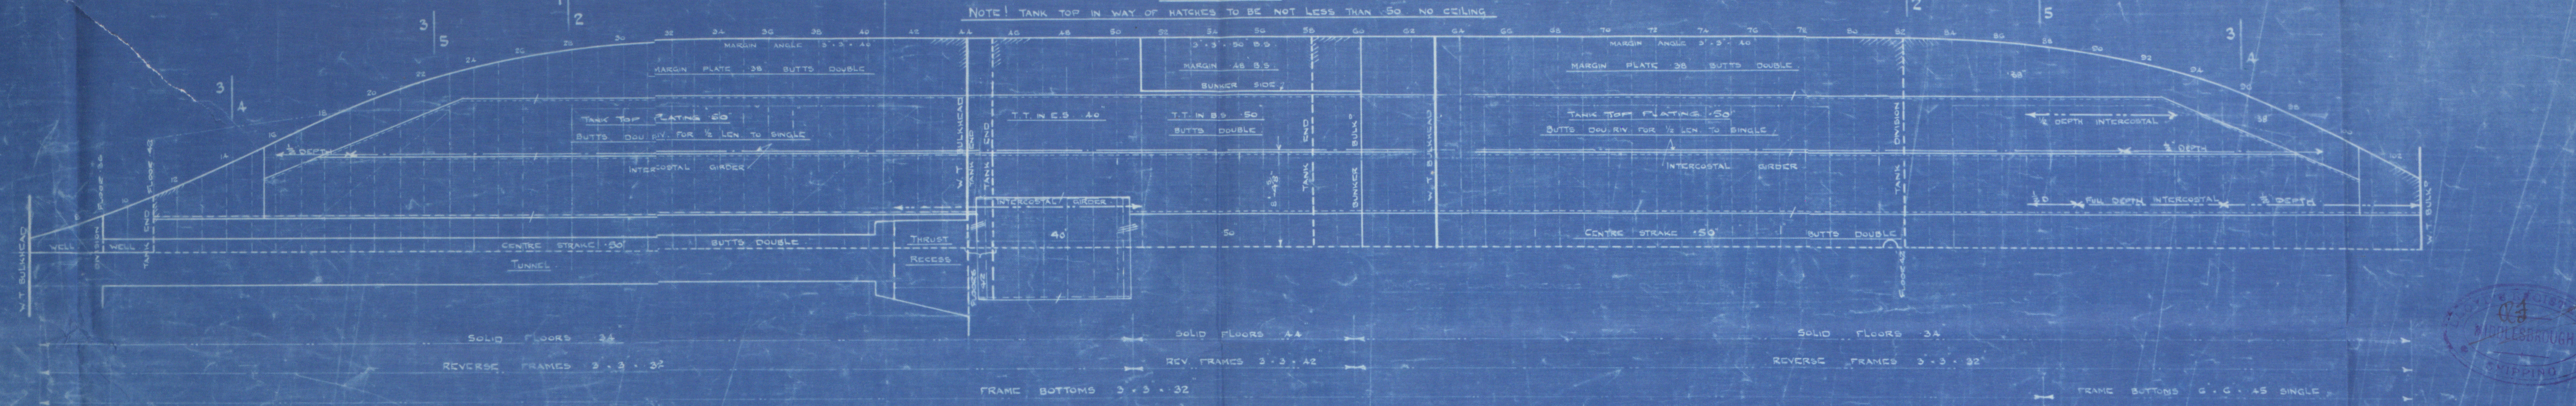

S. S. Hookwood


Mess Furnish Ship Bay No 51

Profile & Deck Plans
as Built

Middlebrough Locks

No 11641

RETAIN

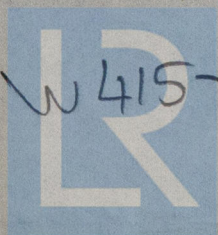

W 415-0077

© 2019

Lloyd's Register
Foundation