

S.S. TORCHBEARER.

S.S. N^o 182.

MIDSHIP SECTION.

CORRECTED TO SHIP AS BUILT.

SCALE 1/2" = 1 FOOT.



PRINCIPAL DIMENSIONS.


LENGTH B.P. 225'-0"

BREADTH M.L.^o 35'-9"

DEPTH M.L.^o 17'-3 1/2"

CLASS 100A.1. LLOYD'S SPECIAL SURVEY.

STEEL DECK WITHIN LINE OF HATCHES '30'
32 AT ENGINE & BOILER CASING

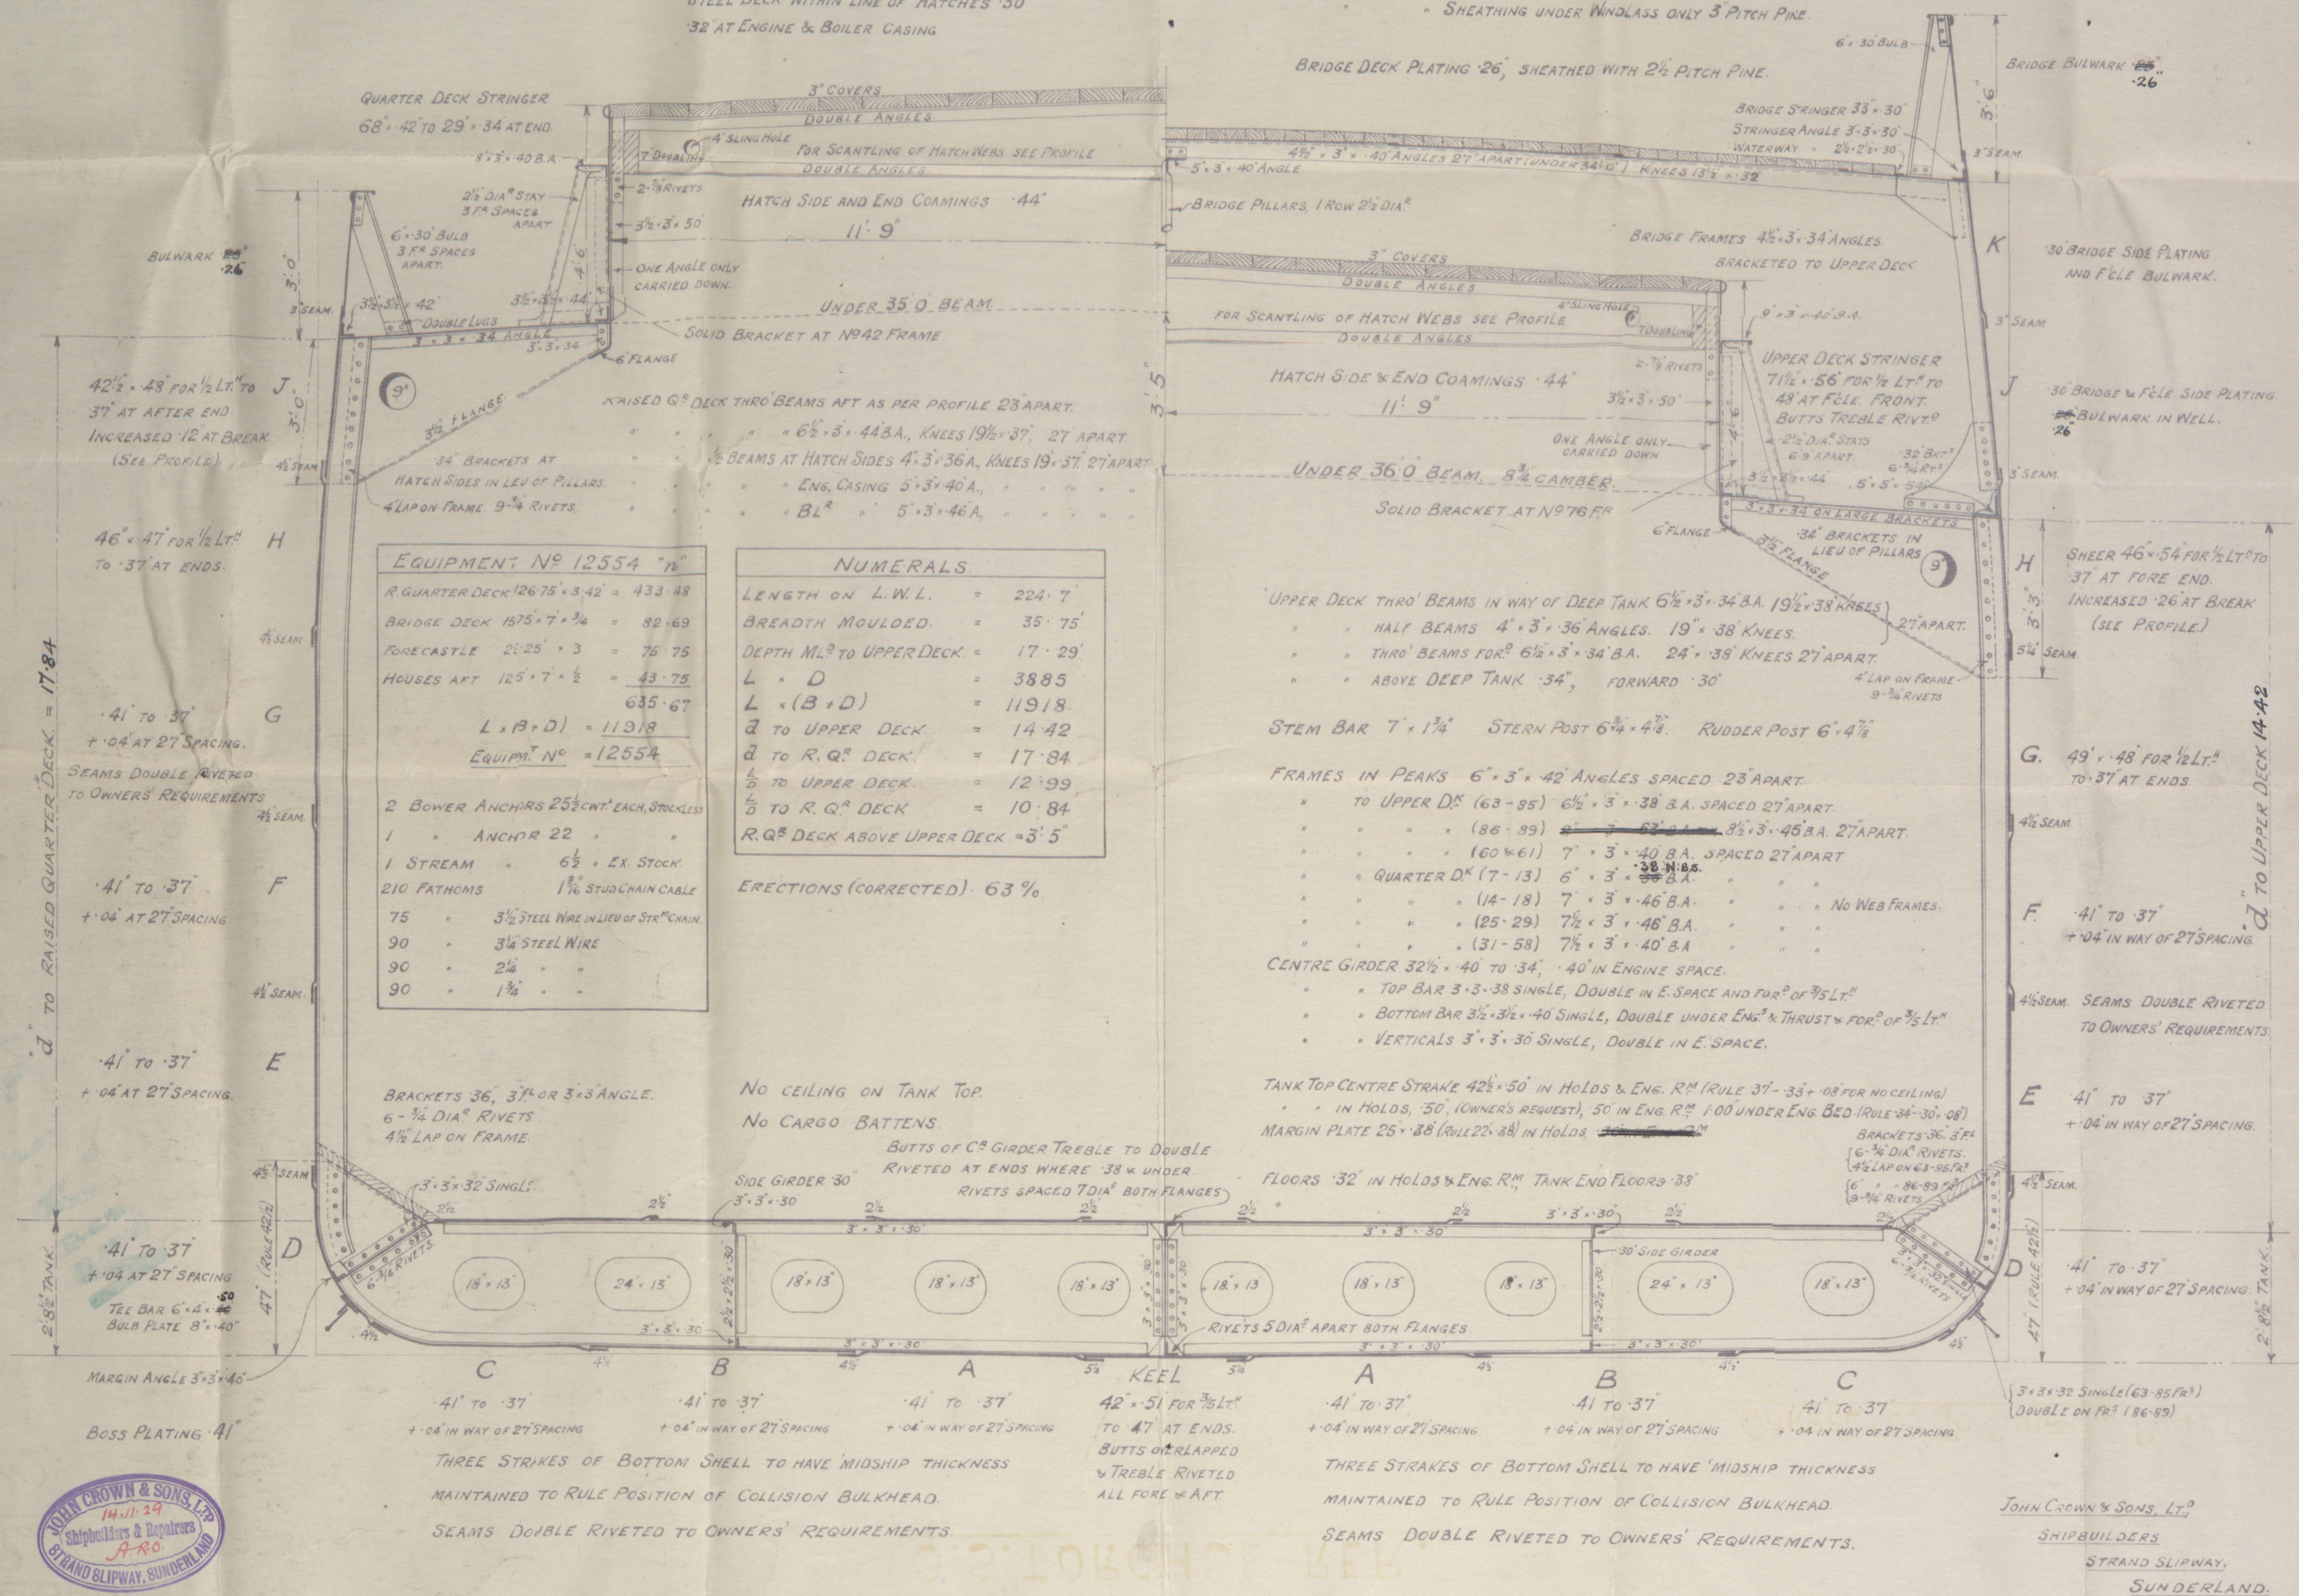

Sunderland.
John Brown & Sons.

- No 182 -


"S.S. TORCHBEARER."

Midship Section.
(-as built). ✓

SUNDERLAND RPT. No. 30200



RETAIN

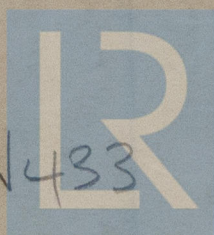

W433

© 2019

Lloyd's Register
Foundation