

S.S. "TORCHBEARER."

No 182 SHIP


PROFILE & DECKS.

CLASS 100A1. LLOYD'S SPECIAL SURVEY

SCALE 3/4" = ONE FOOT.

CORRECTED TO SHIP AS BUILT.

MEASURED	VERTICALS
LENGTH ON L.M.L.	225.0
BREADTH EXT.	36.0
BREADTH MID.	35.75
DEPTH M.D.	17.50
DEPTH OF HOLD.	15.25
UNDER DECK TANKING.	97.00
DISPLACEMENT CORP.	76
NO CEILING ON THIN TOP.	
DEEP BULB FRAMES.	NO CROSS BATTENS FITTED.

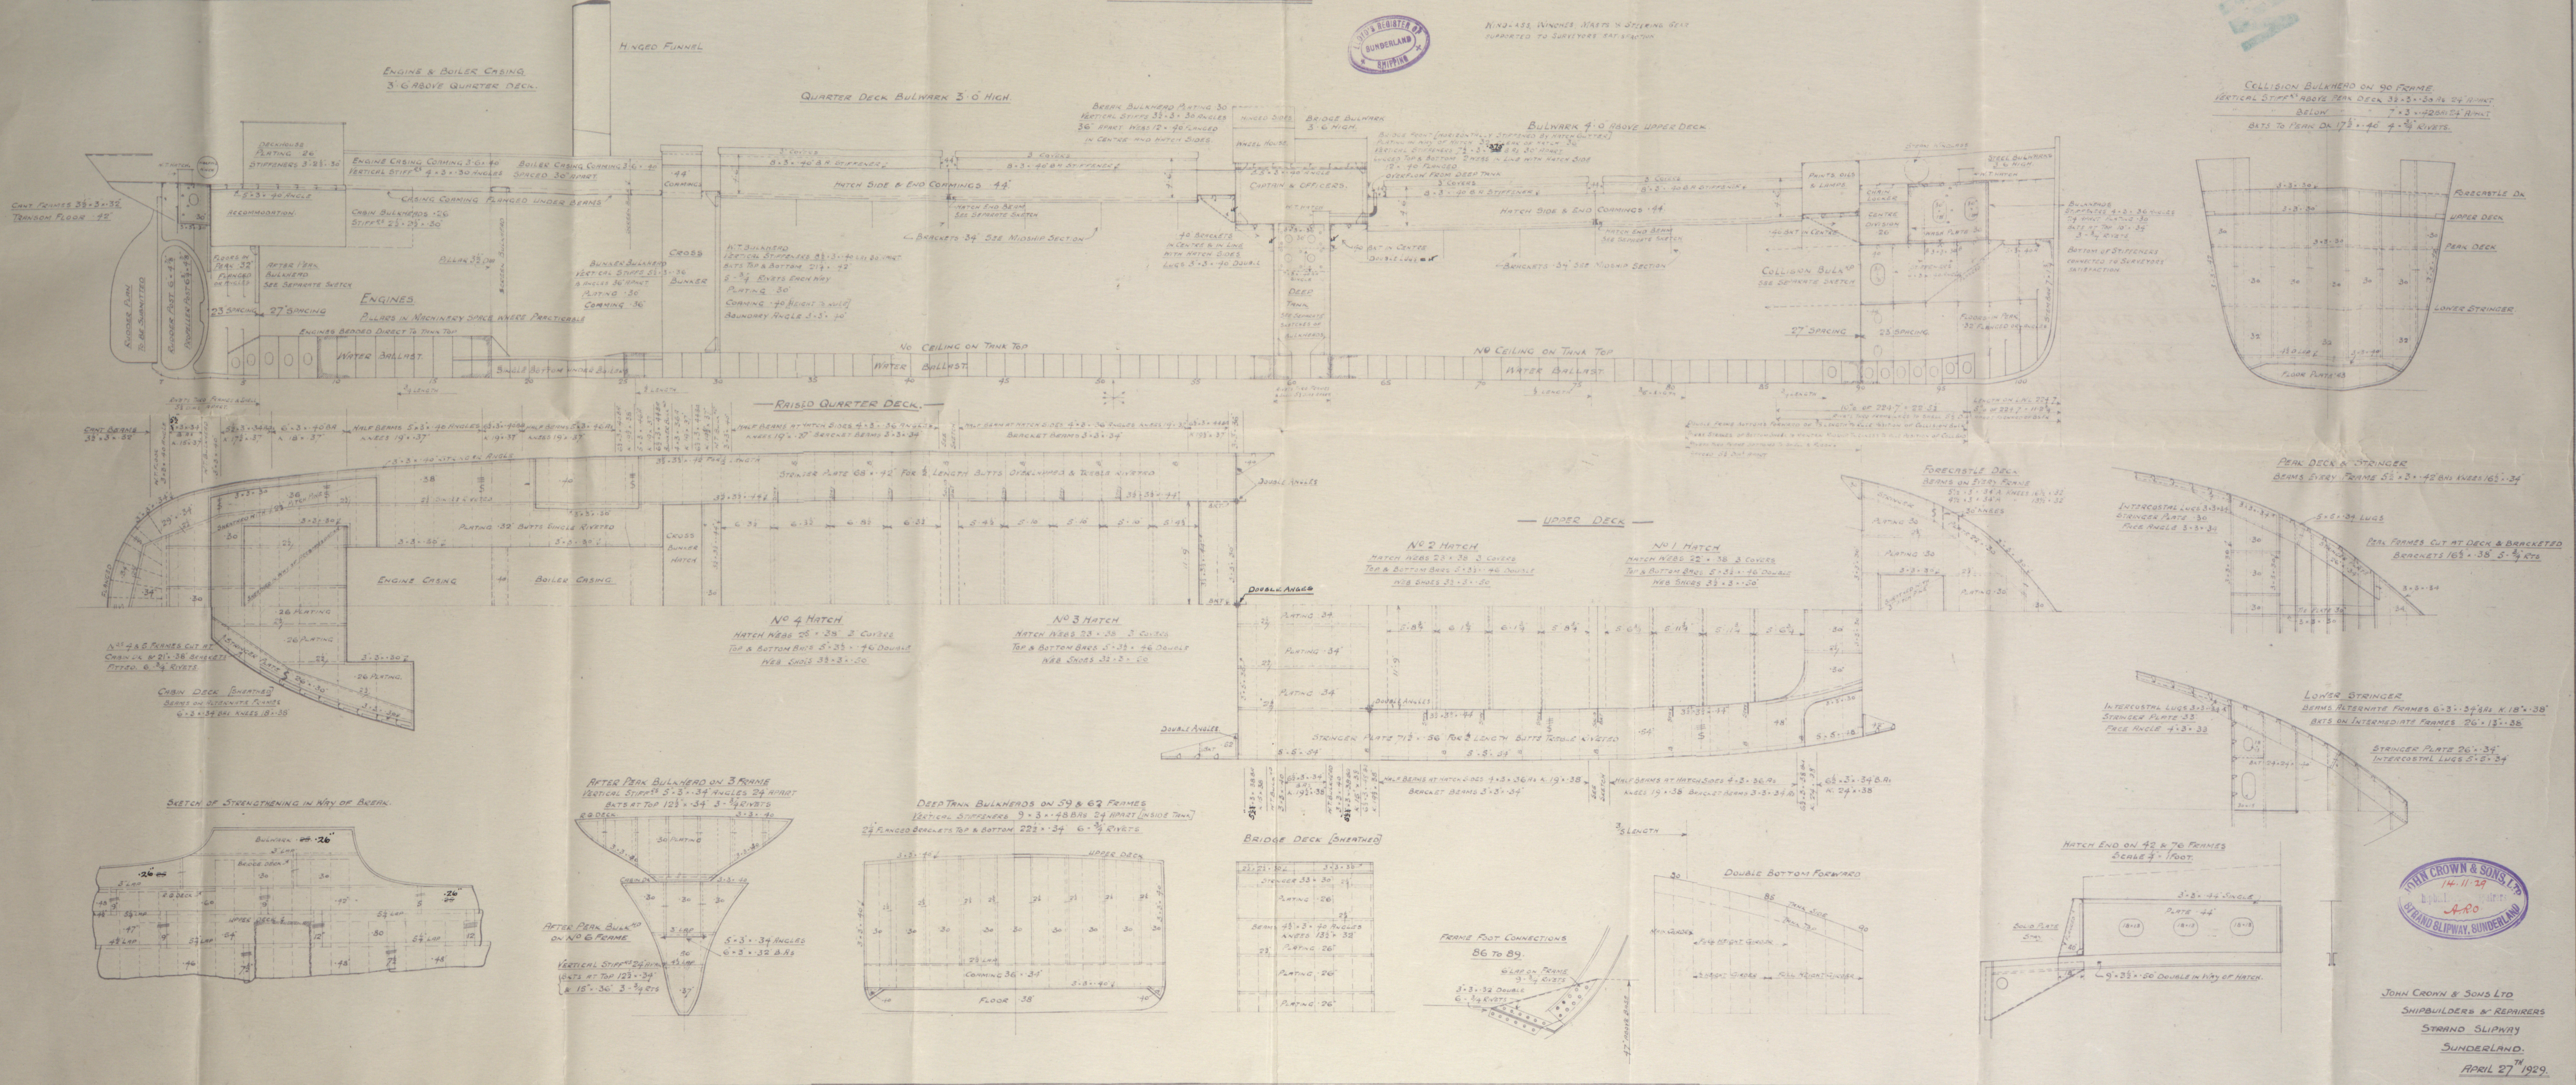

Sunderland.
John Crown & Sons.

- No 182 -


"TORCHBEARER."

Profile & Decks.
(-as built) ✓

SUNDERLAND RPT. NO. 30200.



RETAIN

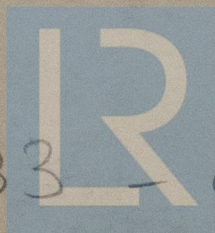

© 2019

Lloyd's Register
Foundation

W433 - 0168