


5/5. CHEVYCHASE. PROFILE & DECK PLAN STEEL SCREW STEAMER. TO CLASS 100 A.I. LLOYDS.

DIMENSIONS 305' 0" B.P. x 45' 3 1/2" BREADTH MLD. x 23' 6" DEPTH MLD.
 SCALE:- 1" = 10'.


NOTE:- NEW BRITISH STANDARD BULB ANGLES ARE ADOPTED
 EXCEPT WHERE OTHERWISE NOTED




DETAIL OF HATCH SIDE GIRDER END
 AT BRIDGE END.
 SCALE 1" = 10'.

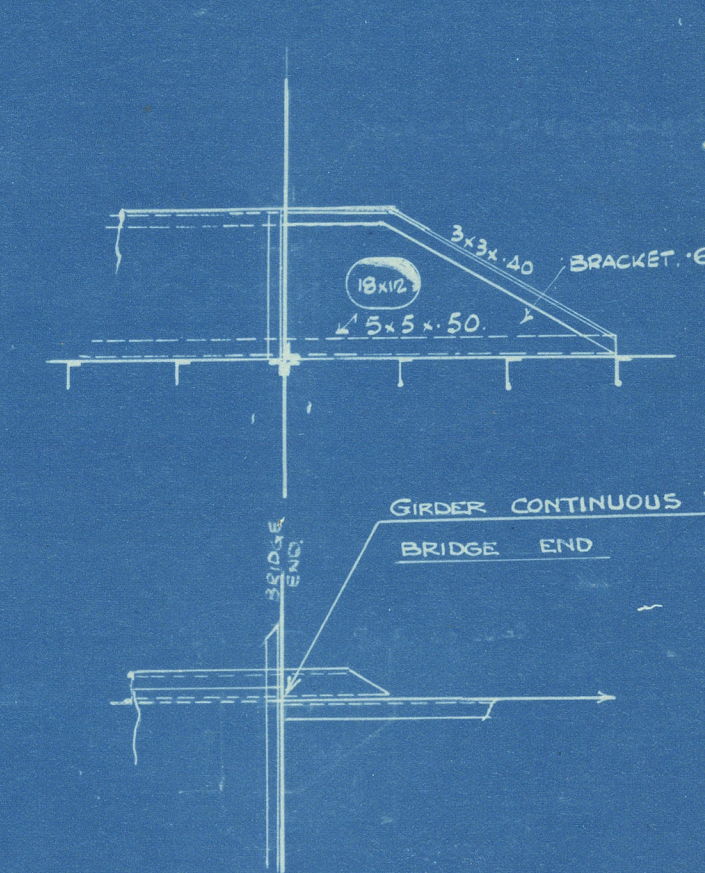


DETAIL OF HATCH SIDE GIRDER
 END AT BRIDGE FRONT.
 SCALE 1" = 10'.

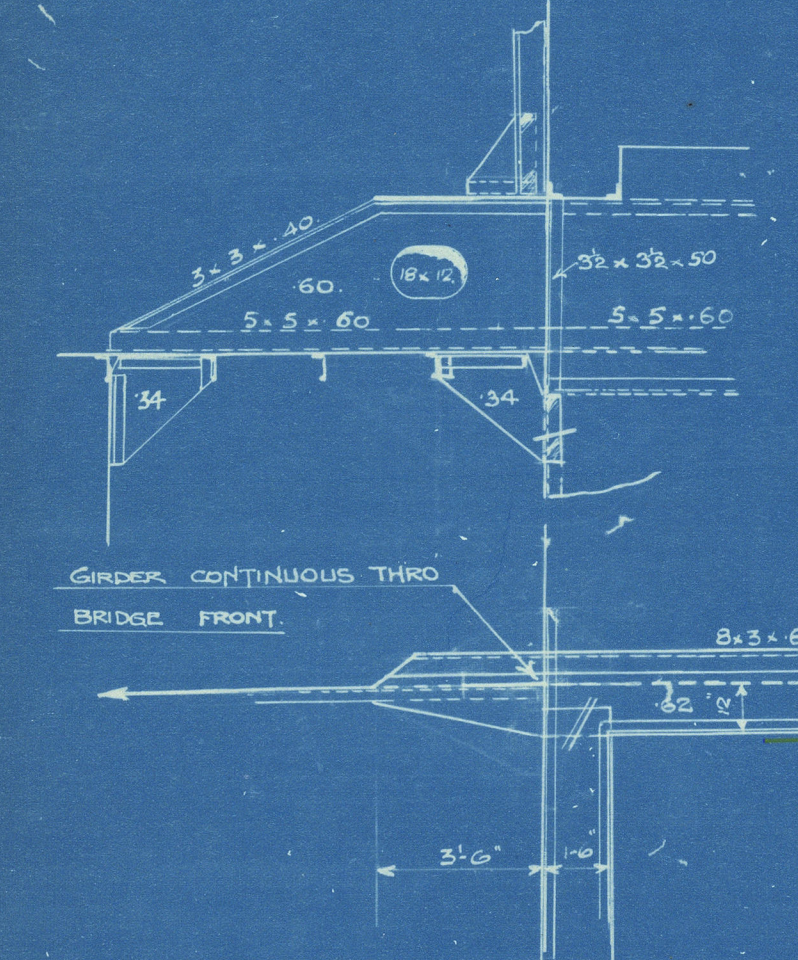

SIDE STRINGER PLATES INTERCOSTAL
 PLATES 1/8" THICK WITH 3/4" x 3/4" x 3/8"
 SINGLE SHELL LUGS AND 5/8" x 3/8"
 SINGLE FACE BAR.

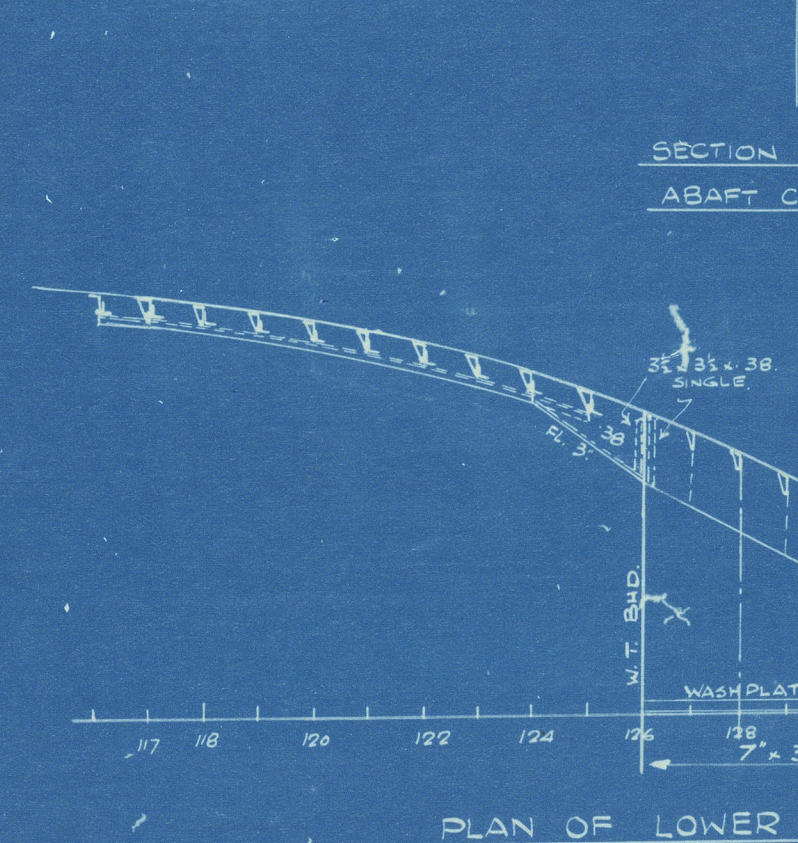




PLAN OF UPPER STRINGER

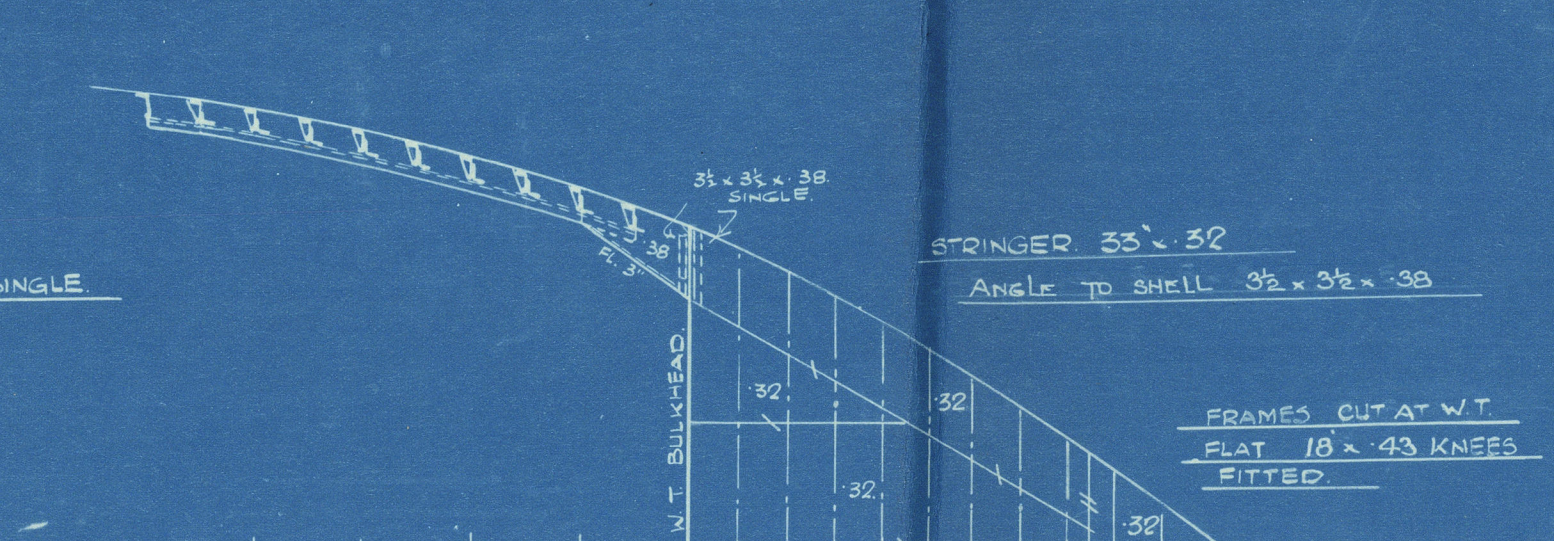

PLAN OF LOWER STRINGER



PLAN OF MIDDLE STRINGER & FORE PEAK TANK TOP

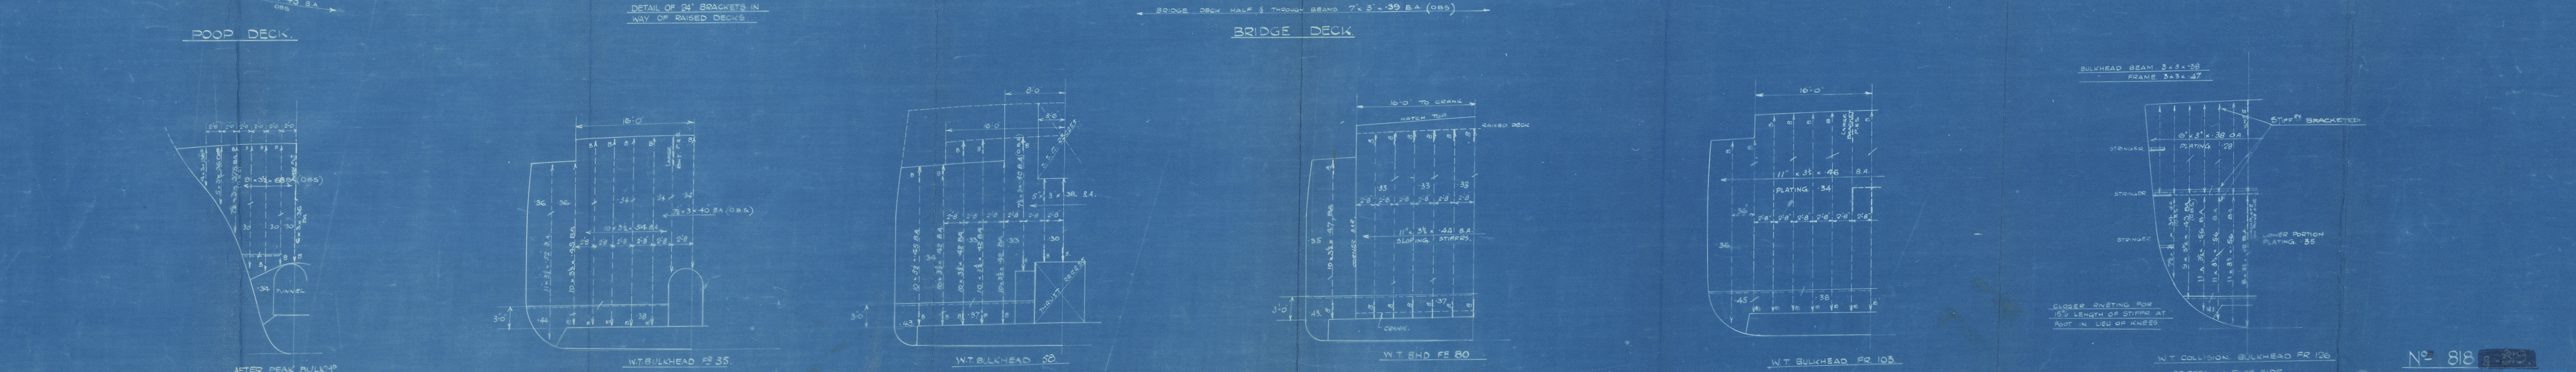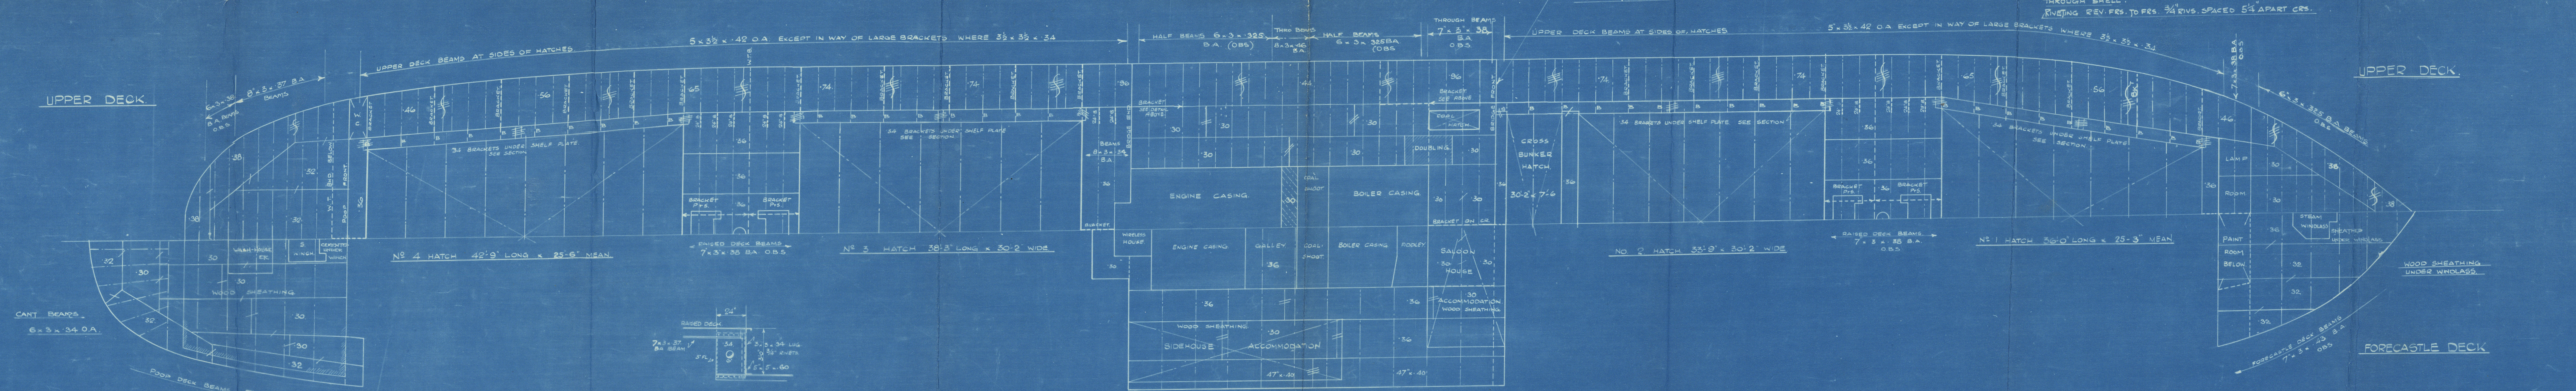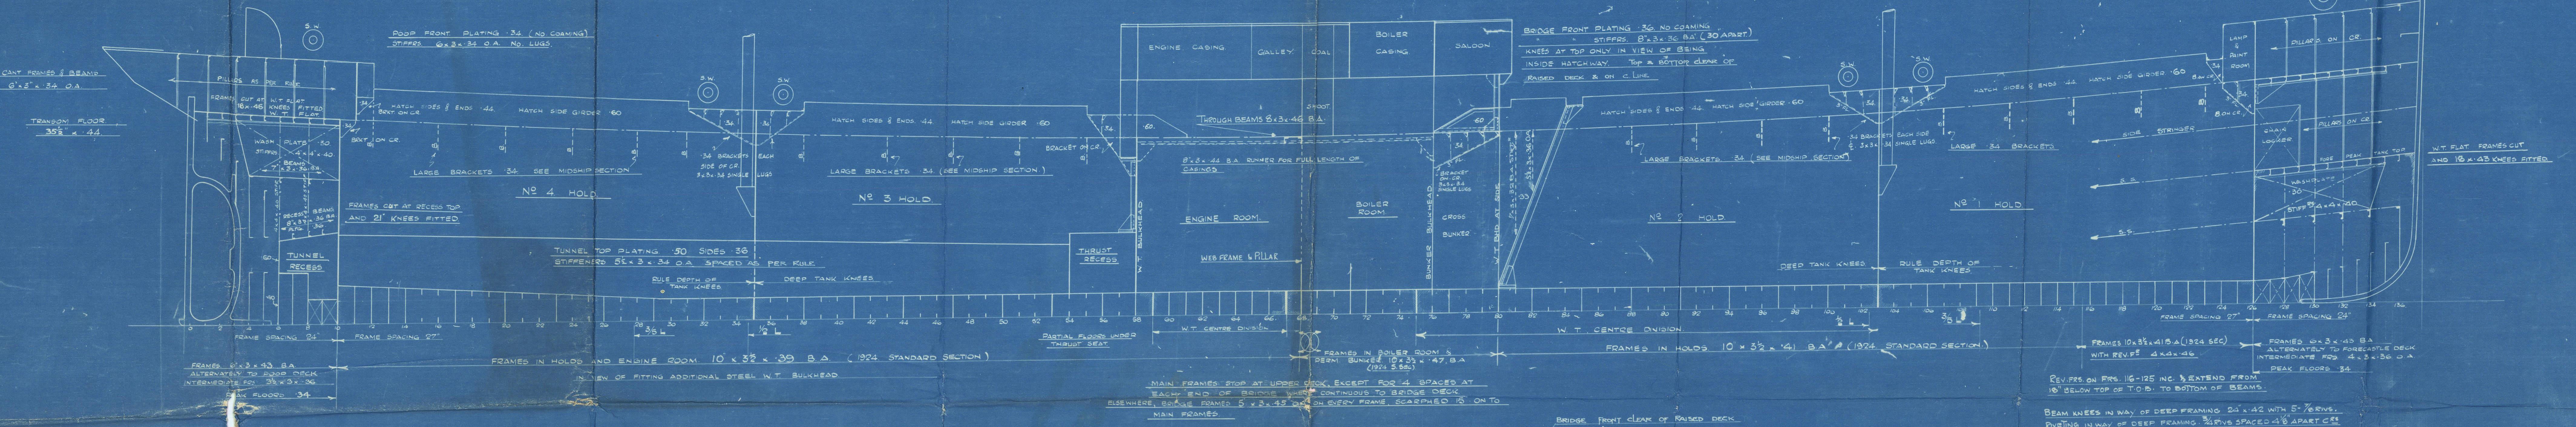

SMITH'S DOCK CO. LTD.
 SHIPBUILDERS & ENGINEERS
 SOUTH BANK ON TEE.

"CHEVYCHASE"

Messrs Smith & Co No 818

Profile and Decks
as built

S.S. Chevy Chase
MDB. RPT. No. 12747

W437-0184



© 2019

Lloyd's Register
Foundation