


Note: It is desired not to have the
OBS. FORSTERKNINGER PAA SKOT
Strengthening on the motor room side
I MOTORRUM SPRES UDGAAT.

looking aft.
MOTORSKOT. (SET FORFRA)
SPT. 25.

Present stiffeners
6 1/2 x 3 x 38
NØYERENDE SKOTSTIVERE: 8 1/4 x 3 1/4 x 44 L
PAA 30' AIST.

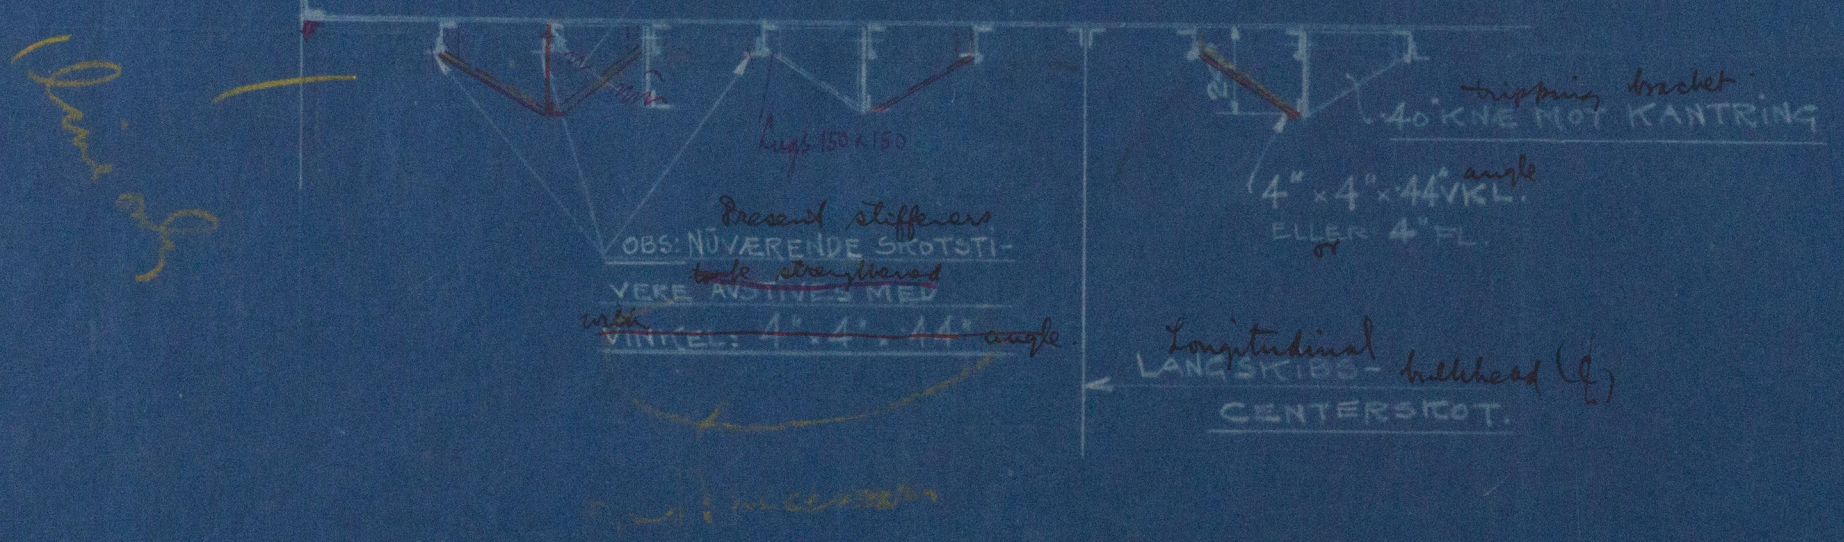

Strengthening of motor room bulkhead (fr. 25)
FORSTERKNING AV MOTORSKOT (SPANT 25)
with ~~webs~~
MED PLATESTIVERE.

14-9-29

1/3 Moss Veret & Dokk.			
M/S "GROSHOLM."			
Motor Room Bulkhead fr. 25.			
Skala: 1/4" = 1' 0"			
TEGN. NR.	TEGNET	DATO:	SPECIALT
5451	8.	3-9-1928	I. 775

M.V. Pioner
~~M.V.~~ (Roskilde)

Doc ref. no. 3593

W473-0116



© 2019

Lloyd's Register
Foundation