


U.D. TONNAGE. 1632.

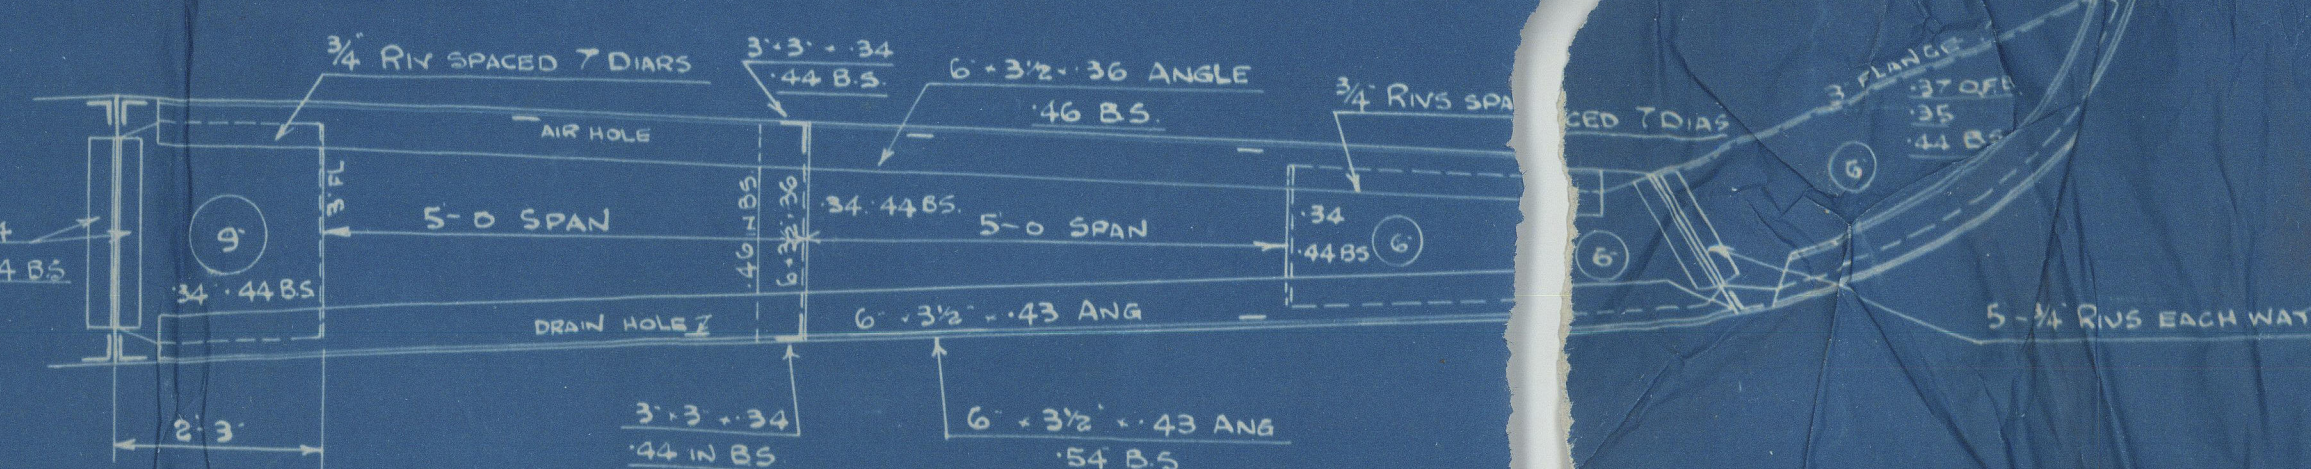

Swan Hunter

1230

Guna

Midship Section
as Built

S. S. Guna.

NEWCASTLE ON TYNE.

Report No. 81484.

W48-0153



© 2020

Lloyd's Register
Foundation