

- S.S. 414-415 416. 417 - - MIDSHIP SECTION -

SCALE 1/2" = 1 FOOT.

SS. "WAZIRISTAN"
SS. "CARLTON"
S.S. "SELVISTAN"
S.S. "KAFIRISTAN"

DIMENSIONS. 389'-6" x 53'-2" x 31'-6" DM.
CLASS 100 A-1, LLOYDS.

OUTFIT.

2 STOCKLESS ANCHORS 60 CWT EACH.
1 " " 50 1/2 "
1 STREAM " 16 1/2 " (EX STOCK).
270 FATHOMS 2 3/16 STD CHAIN CABLE.
90 FATHOMS 4 3/4" STEEL STREAM WIRE.
120 FATHOMS 4 3/4" TONLINE.
2-90 FATHOMS 2 3/4" STEEL HANISERS.
2-90 FATHOMS 7" HEMP HANISERS.

OUTFIT NO

389.5 x 84.666 = 32977
POOP 33
BRIDGE 112.75
FOLE 36
181.75 x 8.3 1/4 = 1090
HOUSES
SALOON HOUSE 20
CASING + ENGRS HOUSE 57
77 x 8.1 1/2 = 308
34375.

BUTTS FOR 1/2" QUADRUPE OVERLAPS
WHERE OVER 60 IN WELLS + TREBLE
IN BRIDGE. TREBLE AT ENDS.

L IN BRIDGE - 62
CLEAR OF BRIDGE 63" x 80" x 44"
INCREASED TO 120 ACROSS BREAK.

BUTTS FOR 1/2" QUADRUPE OVERLAPS
WHERE OVER 60 IN WELLS + TREBLE
IN BRIDGE. TREBLE AT ENDS.

K IN BRIDGE - 62"
IN WELLS 63" x 66" x 45"


SIDE SHELL 65 TO 45 AND
50 WHERE FRAMES SPACED 33"
F.G.H + J 60 MIDSHIPS TO
44 FROM 3/5 L FORD TO STEM

BUTTS OF SHELL FROM
A TO J INCLUSIVE. TREBLE
OVERLAPS THROUGHOUT.

NUMERALS.

D = 31.5
B = 53.166
B + D = 84.666
L x D = 389.5 x 31.5 = 12269
L x (B + D) = 389.5 x 84.666 = 32977
d = 31.6 - 3.9 1/4 = 27.8 3/4
KNEES INCREASED IN DEPTH TO 90. d = 26.77
L = 389.5 = 12.36 TO MAIN DECK.
31.5
389.5 = 9.86 TO BRIDGE DECK.
39.5

PLAN NO 260

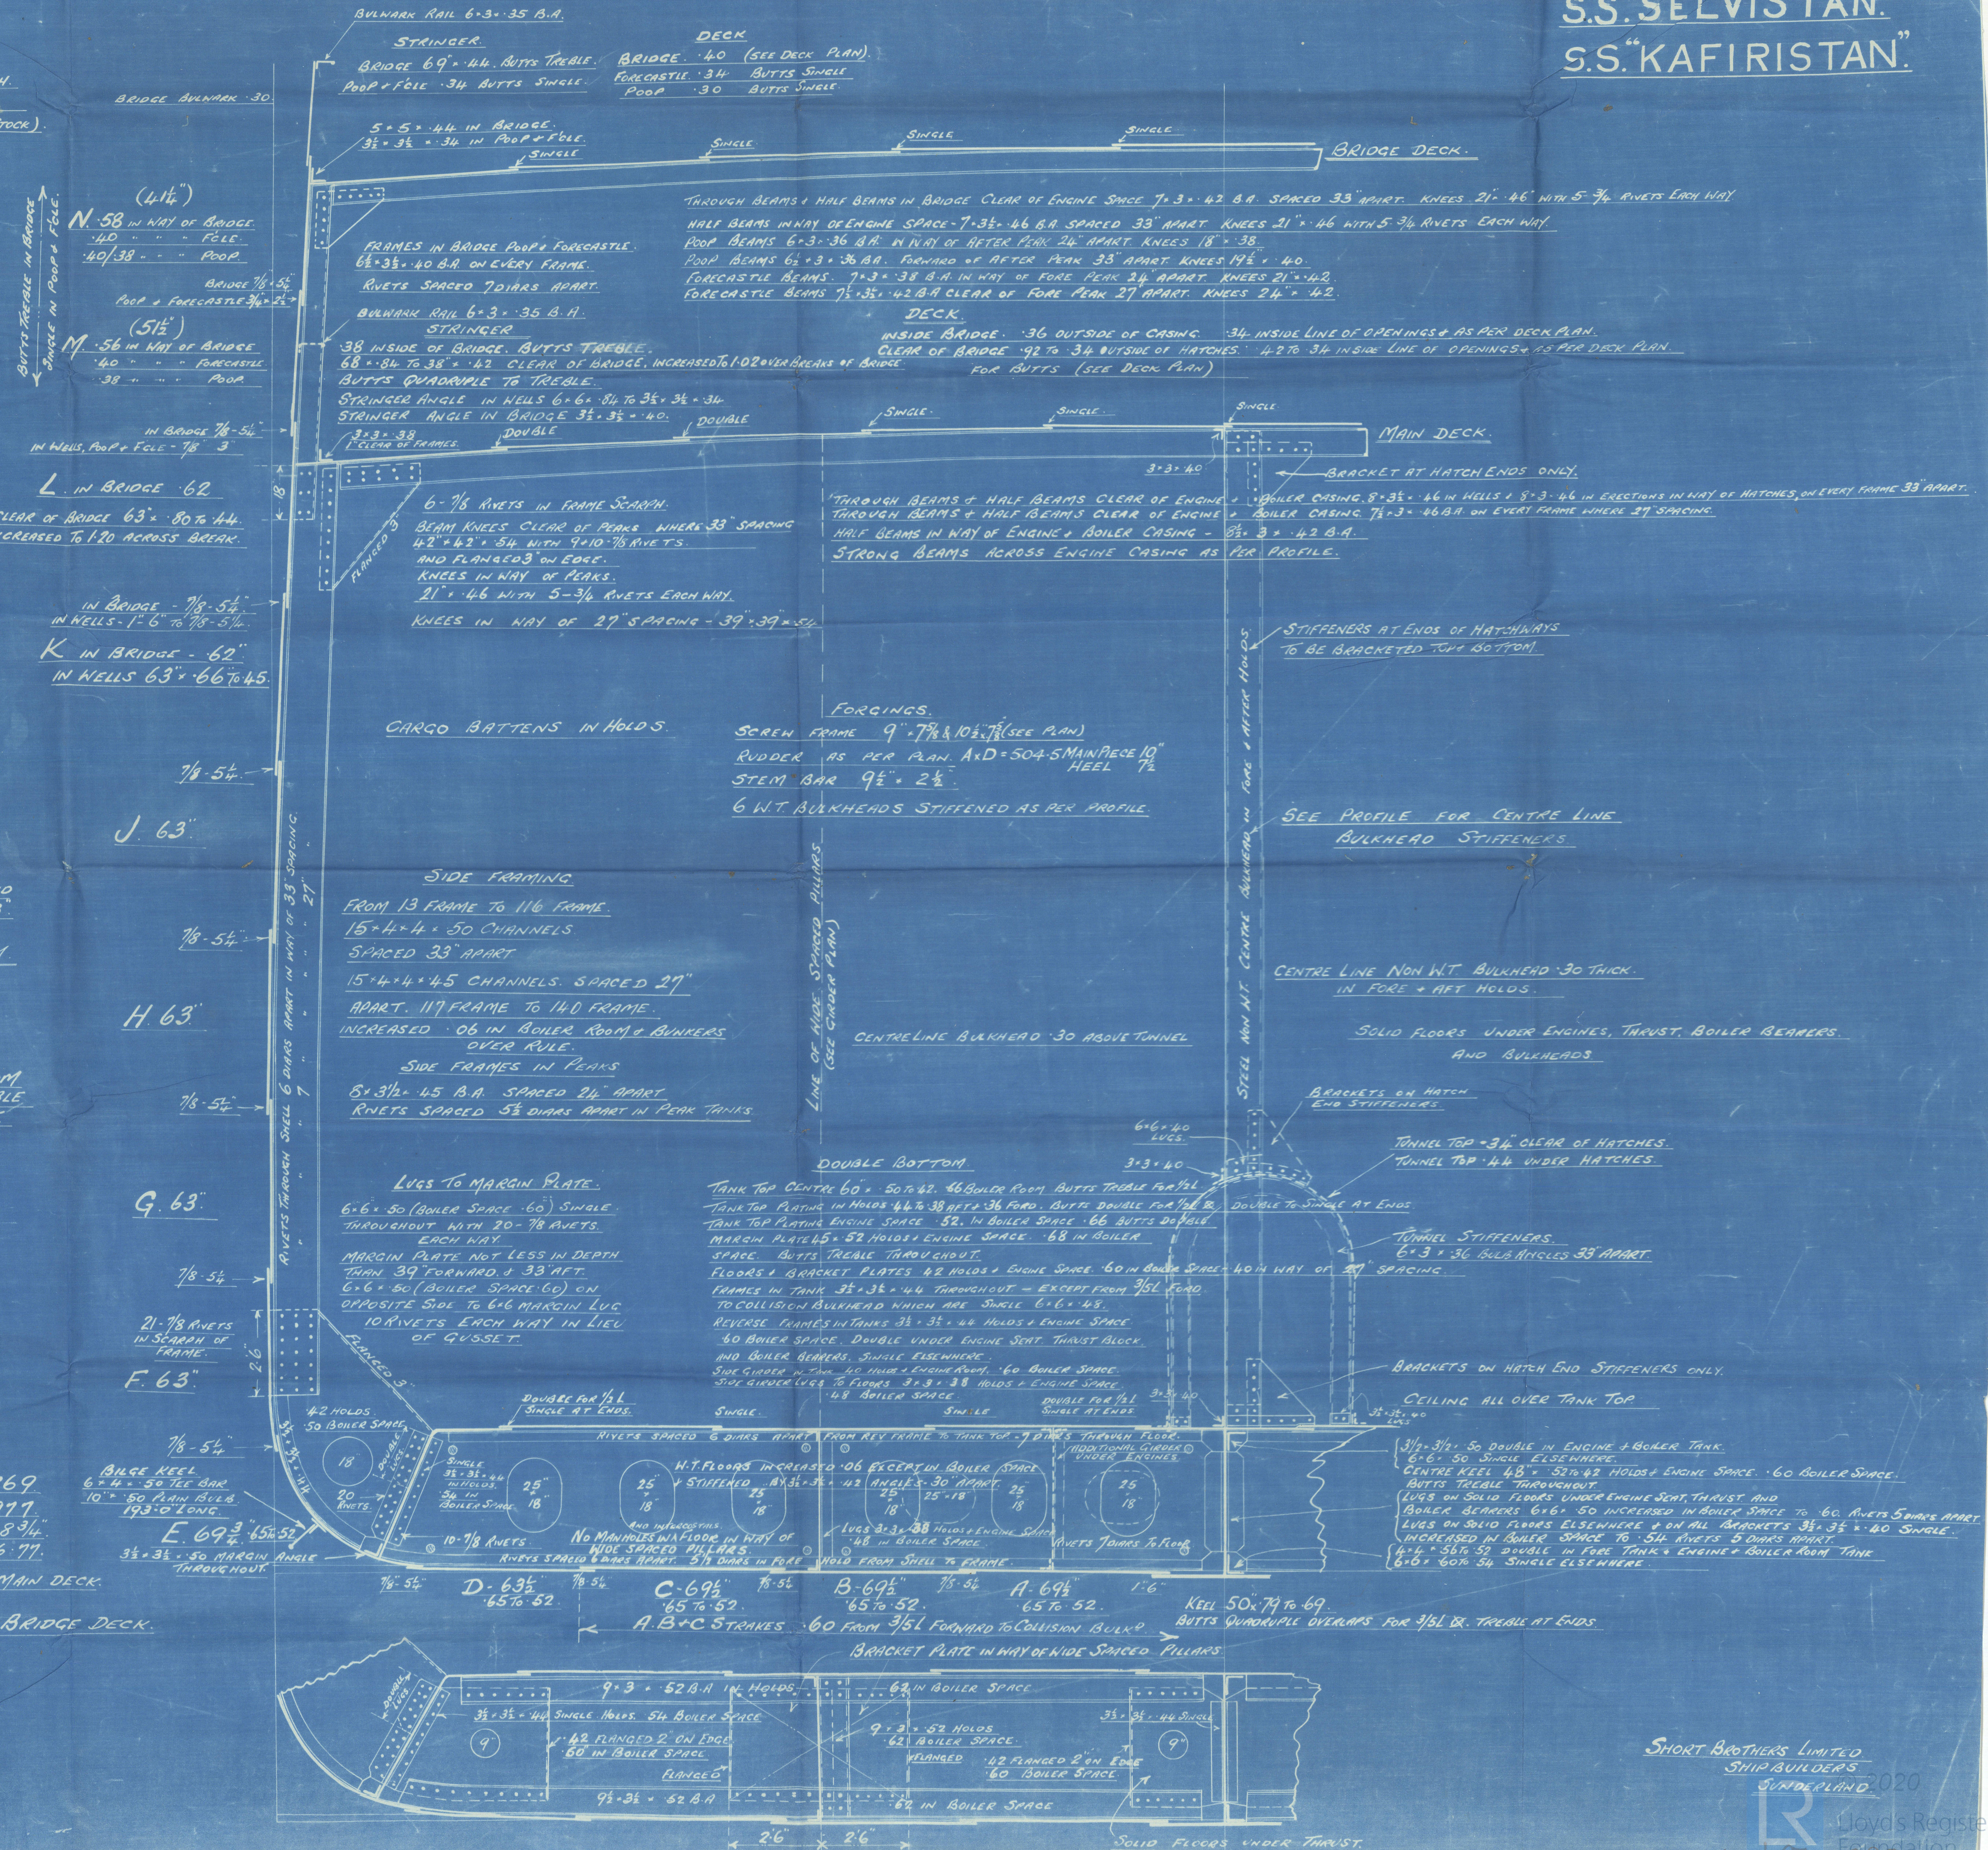

SHORT BROTHERS LIMITED
SHIP BUILDERS
SUNDERLAND

Lloyd's Register
Foundation
W487-0256

Section

(as built-)

N^o 417

Messrs. Short Bros & Co.

Sunderland

S.S. "KAFIRISTAN"

SUNDERLAND RPT. NO. 28901

RETAIN



© 2020

Lloyd's Register
Foundation

W487-0256