


EQUIPMENT			
2 BOWERS	56 1/4 CWT	STOCKLESS	
1 "	47 1/2 CWT		"
1 STREAM	15 CWT	EX STOCK	
1 KEDGE	8 1/2 CWT		" "
270 FATHOMS	2 1/2	STUD CHAIN CABLE	
90 "	4 1/2	MOORING WIRE	
120 "	4 1/2	STEEL TOWLINE	
2 OF 90	7	MANILLA HANSER	
2 OF 90	7	" WARP	

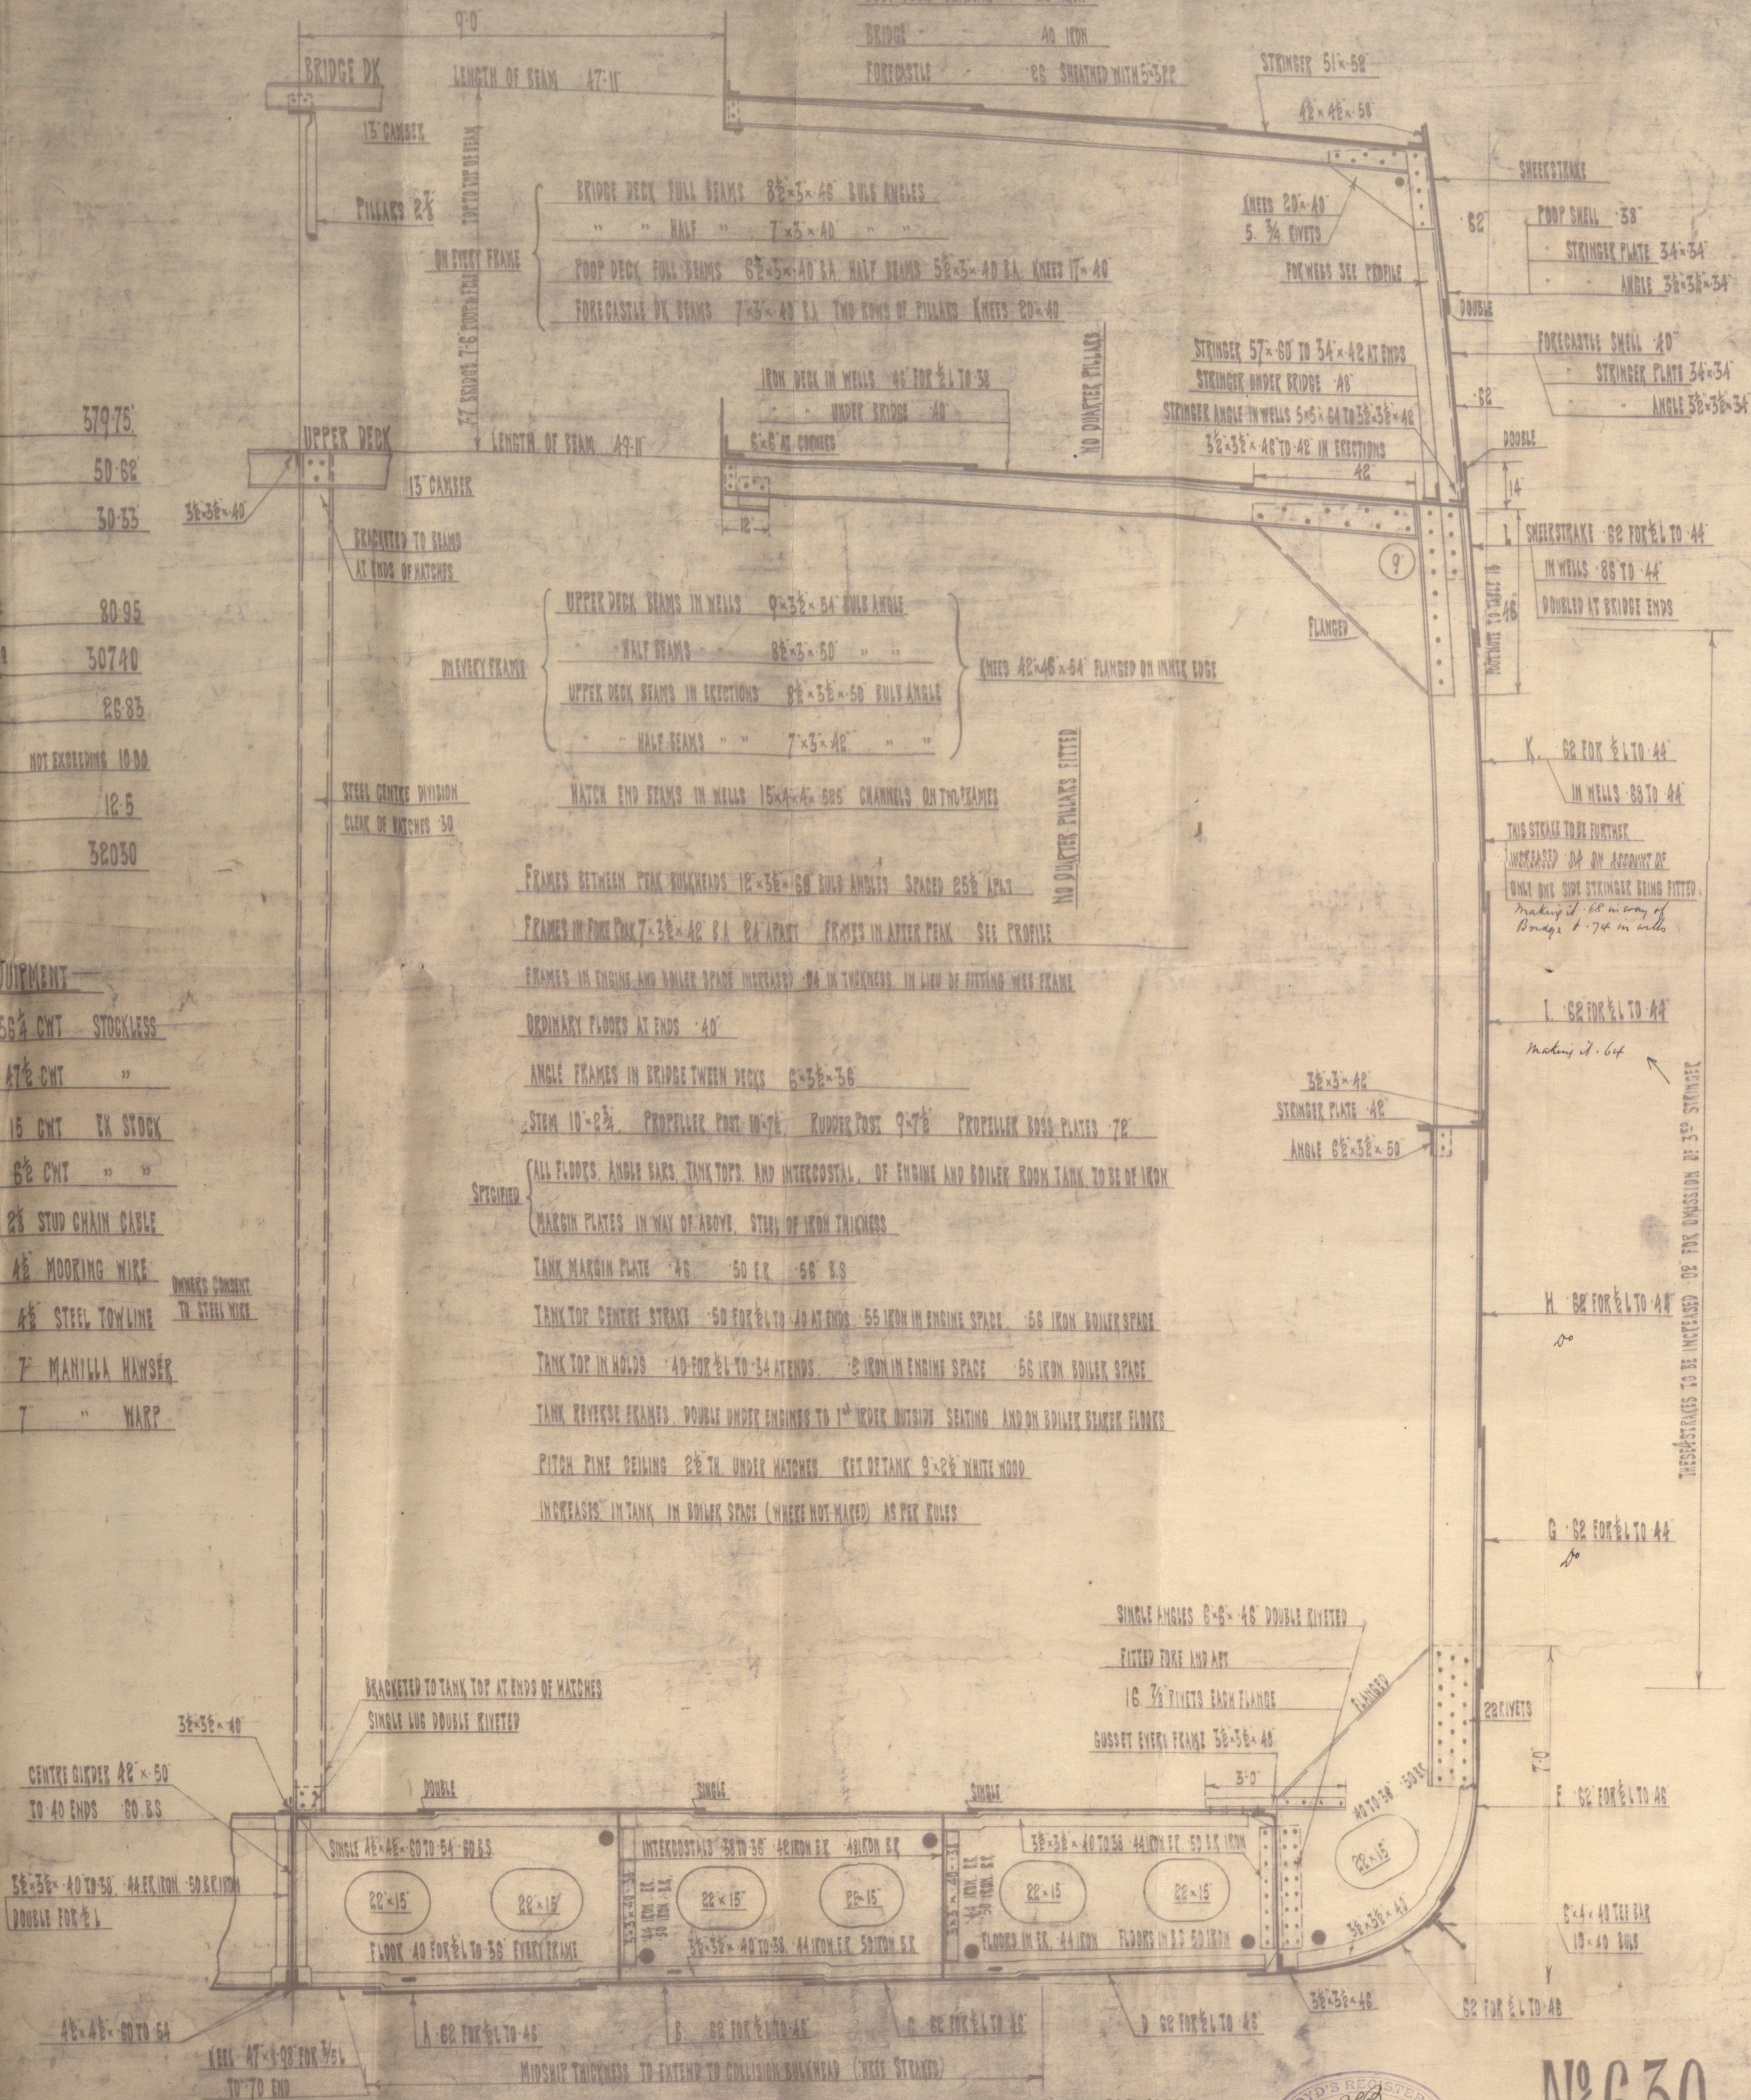

RICHARDSON DUCK & CO LTD  
SHIPBUILDERS

STOCKTON-ON-TEES TR. NO. 3098.  
MAR 29<sup>TH</sup> 1913

LLOYD'S REGISTER OF  
MIDDLESBROUGH  
29.3.13  
SHIPPING

Nº 630

© 2019  
4497-0181  
Moyos Register  
Foundation



Miss Richardson Duck House  
No 30


Mid: Sec:

as Built

Sp. Barkmen

Lab. Report 9841

RETAIN

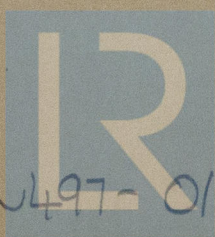

© 2019

Lloyd's Register  
Foundation

W497-0181