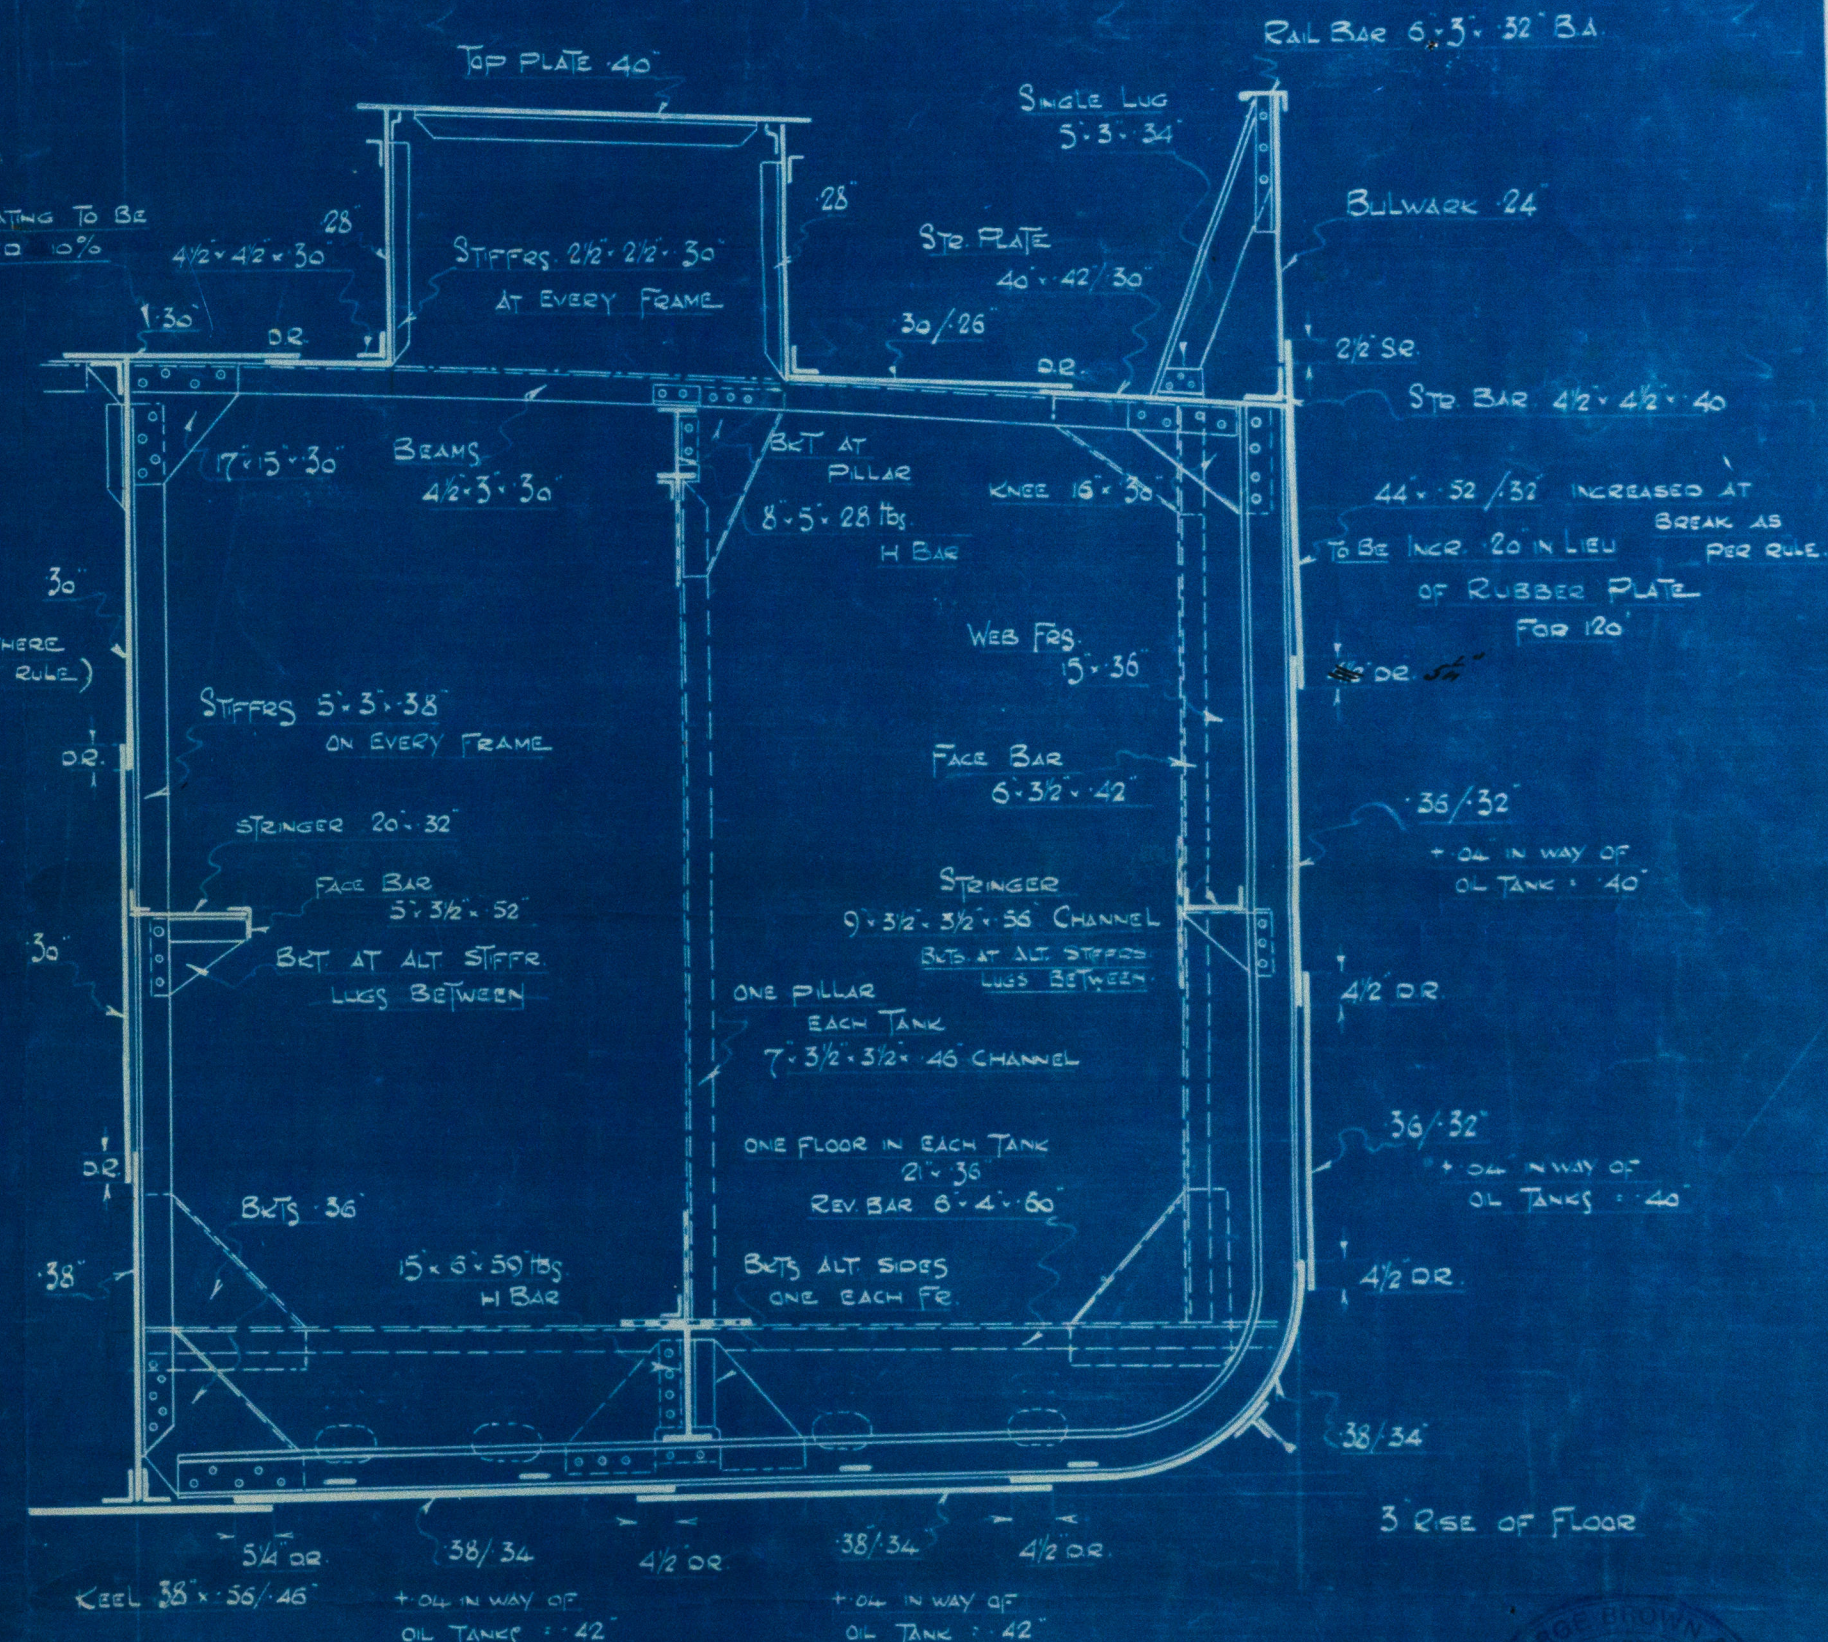


SCALE: ~ $\frac{1}{2}$ inch = 1 foot.

7278

$$\frac{172.5}{16} = 10.7$$


SECTION IN WAY OF OIL TANK.

Geo. Brown & Co
S.S. PURACITY
N^o 149.

Midship Section
as Built

Genl. Regt. N^o. 18476.

WS-0030

