

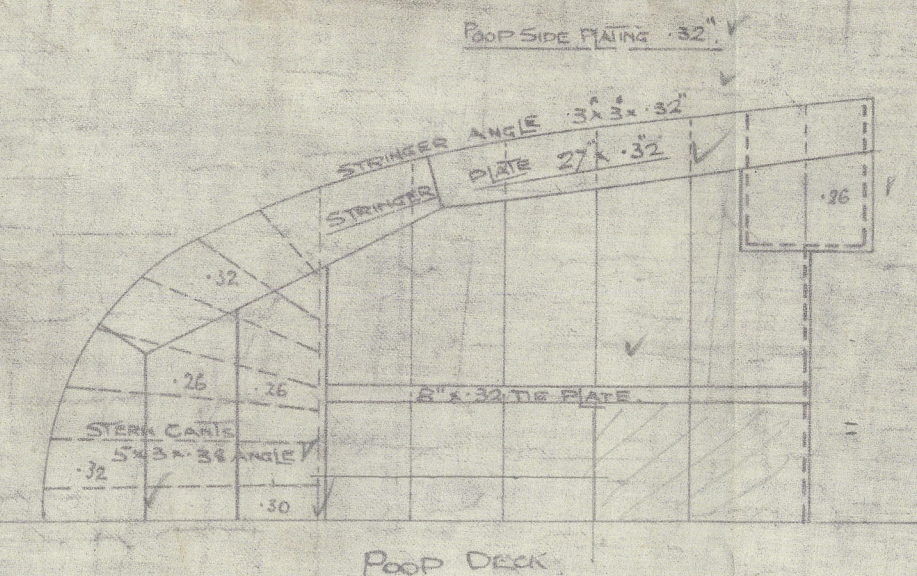




Lloyd's  
Stamp  
12.6.19

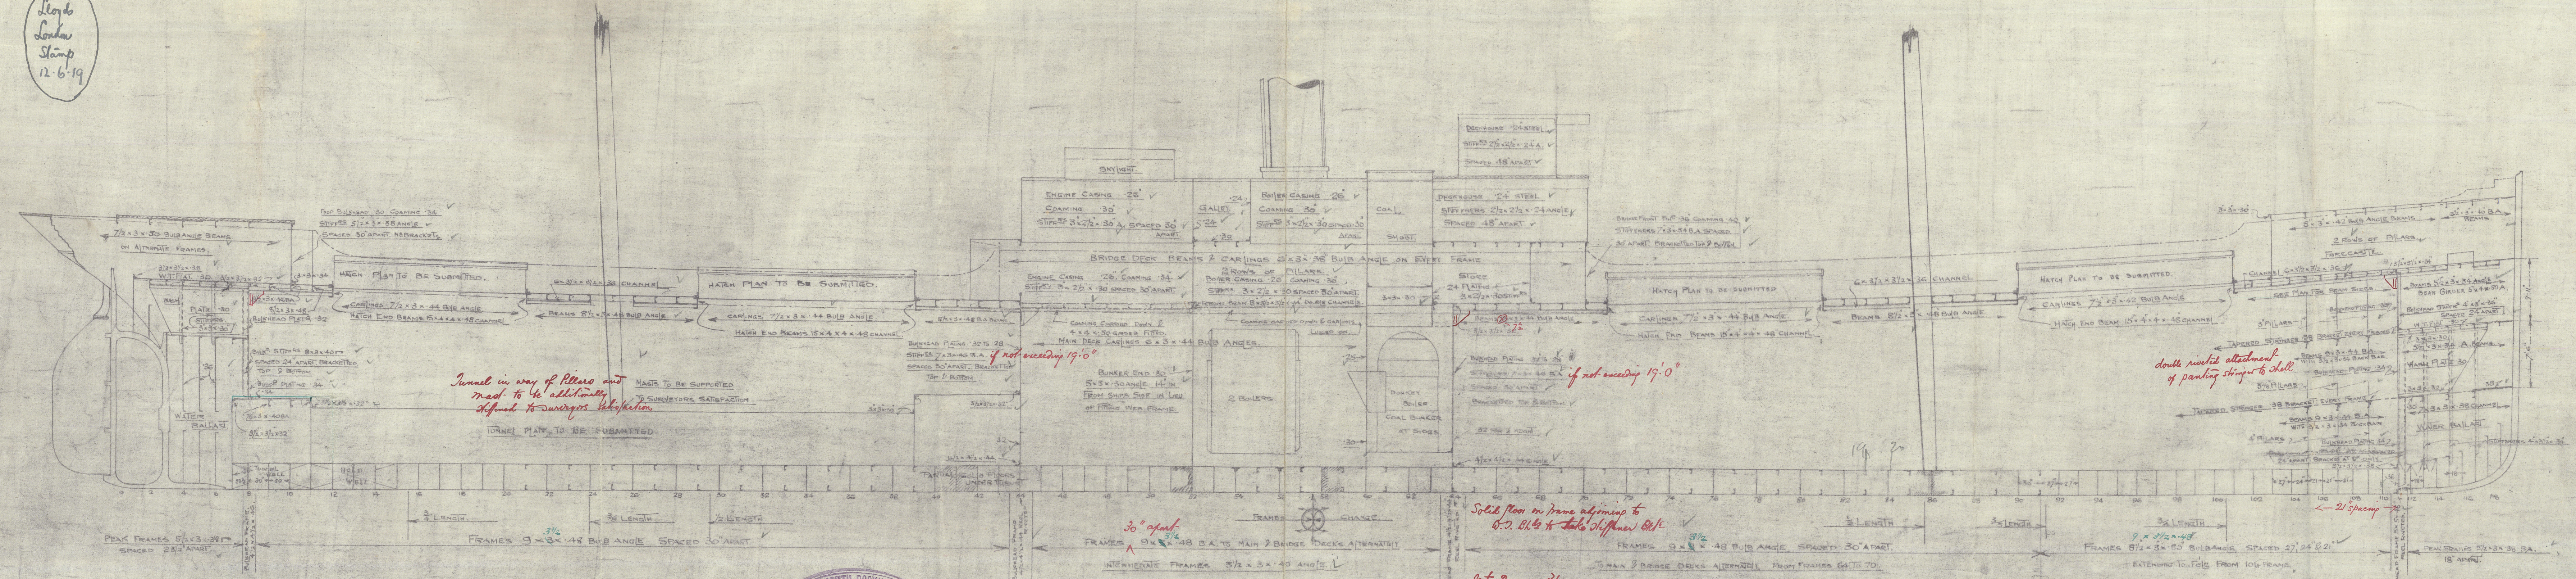

N° 400  
**PROFILE & DECK PLANS.**  
DIMENSIONS — 280'-0" BP x 41'-8" MP x 20'-9 1/2" MD TO MAIN D.  
27'-9 1/2" MD TO BRIDGE D.  
SCALE 1/8" = 1 FOOT.  
TO CLASS LOCAL AT LLOYDS  
Amendment in green by builders.

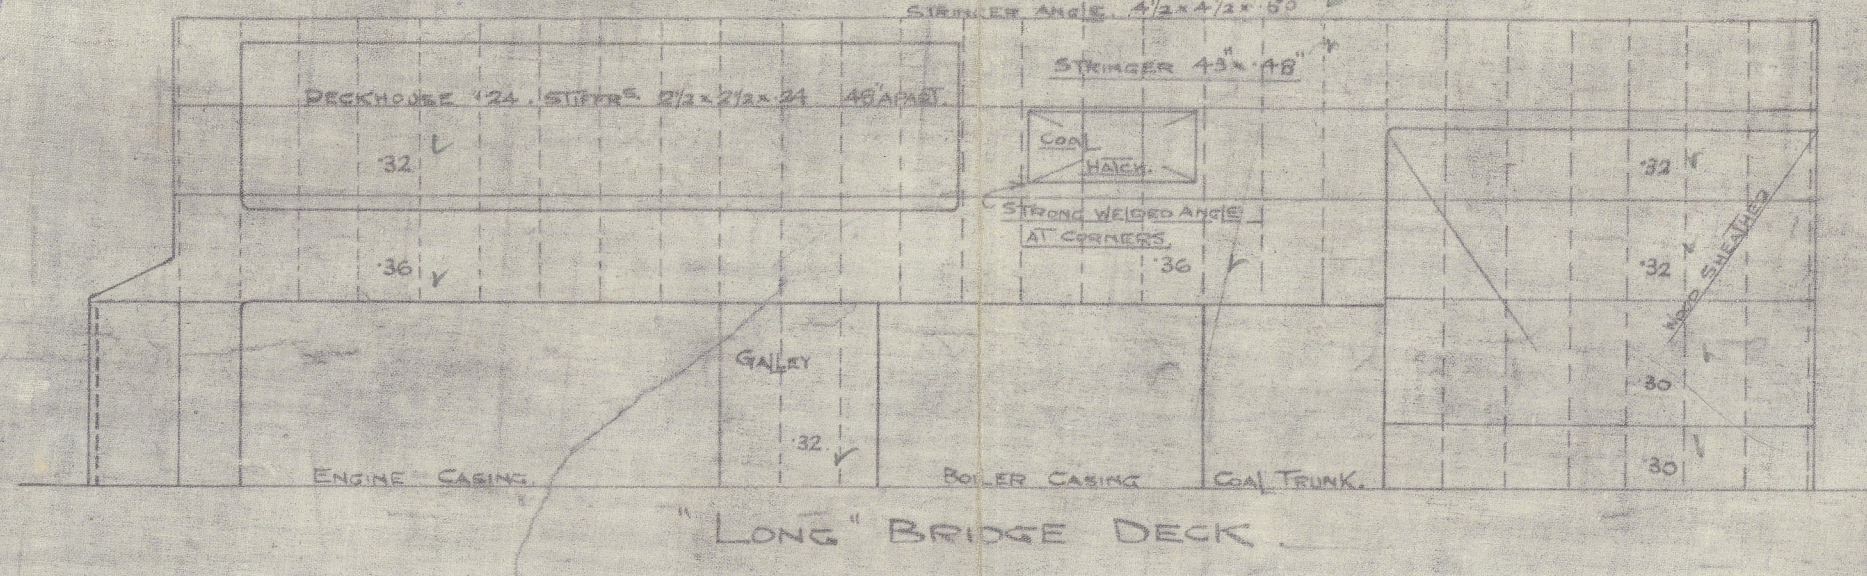

NOTE: THESE SCANTLING'S SHOWN TO BE THE MINIMUM, ANY REDUCTIONS TO BE INDICATED ON PLAN. ERRORS & OMISSIONS EXCEPTED.

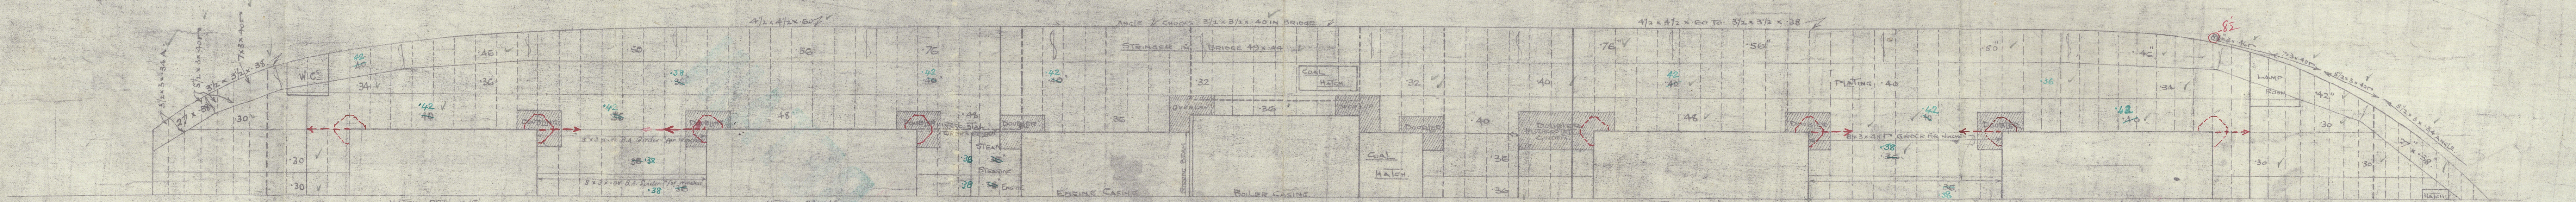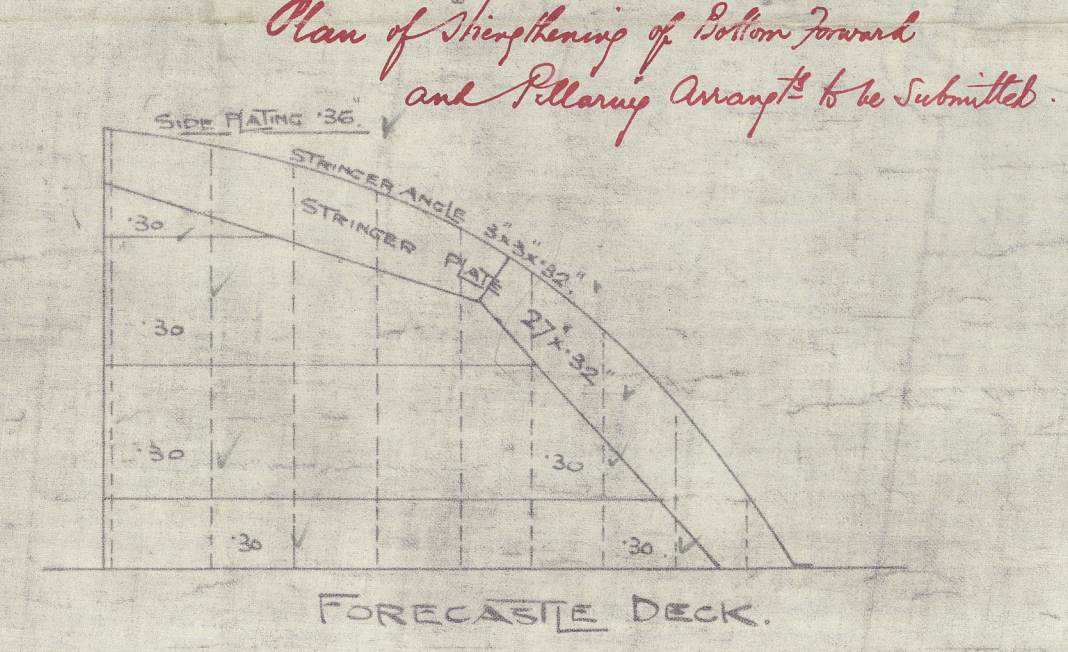

Copy of plan appd 12.6.19  
R.M.M.  
23.2.20.

(Sd) R.M.M.  
12.6.19



Glasgow Wkyd. Co. Ltd.

No. 400


Profile deck plans.

MON MAR. 22 1910

S. S. "Fairpark"  
(as built)

GLASGOW REPORT No. 40094

RETAIN

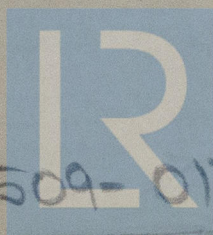

© 2021

Lloyd's Register  
Foundation

W509-0175