



SCALE $\frac{1}{8}$ " = 1 FOOT

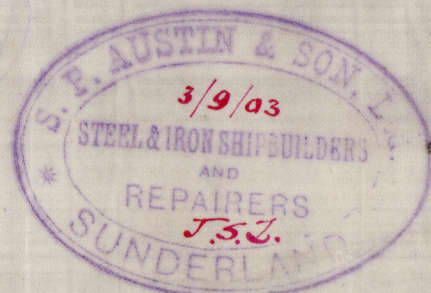

No 223
S. Agnes
Profile of
Decks
as built
Sunderland J.E. 21473

Sunderland. J.E. 21473

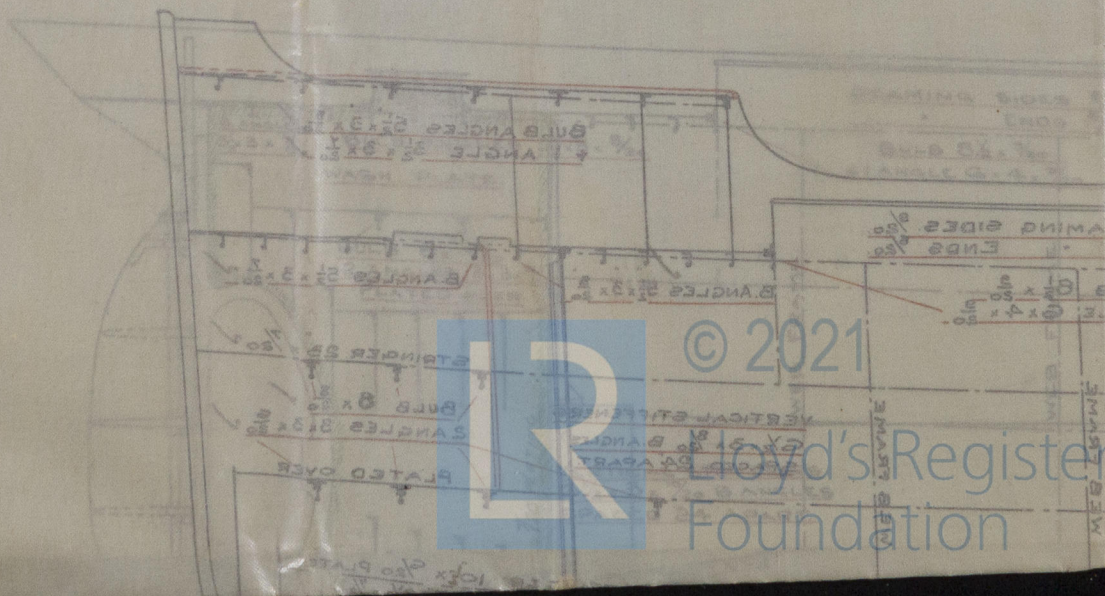

WS38-0310

Lloyd's Register
Foundation