


No. 343.
PROFILE + DECK.

SCALE 1/8" = 1. FOOT.

CLASS 100. A. 1. LLOYDS. SPECIAL SURVEY.

s.s. Goodwood.

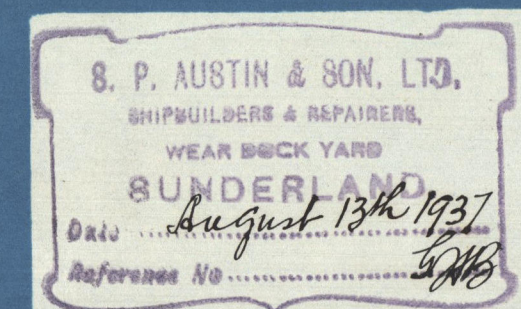


AFTER HATCHES + WINCH DECK.

FORWARD HATCHES + WINCH DECK.

FREEBOARD PARTICULARS.

LENGTH ON L.W. LINE.	305.80'	SHEER AFT.	3'-9"
BREADTH MOULDED.	44.25'	" FORD.	7'-10"
DEPTH	21.50'	PARABOLIC CURVE TO RULE.	
85% "	18.275'		
MOULDED DISPLACEMENT AT 85% DEPTH MOULDED.	5465.		
DISPLACEMENT COEFF.	.7749.		
RAISED QUARTER DECK.	176'-8" x 4'-9"		
FORECASTLE.	34'-4" x 7'-3"		

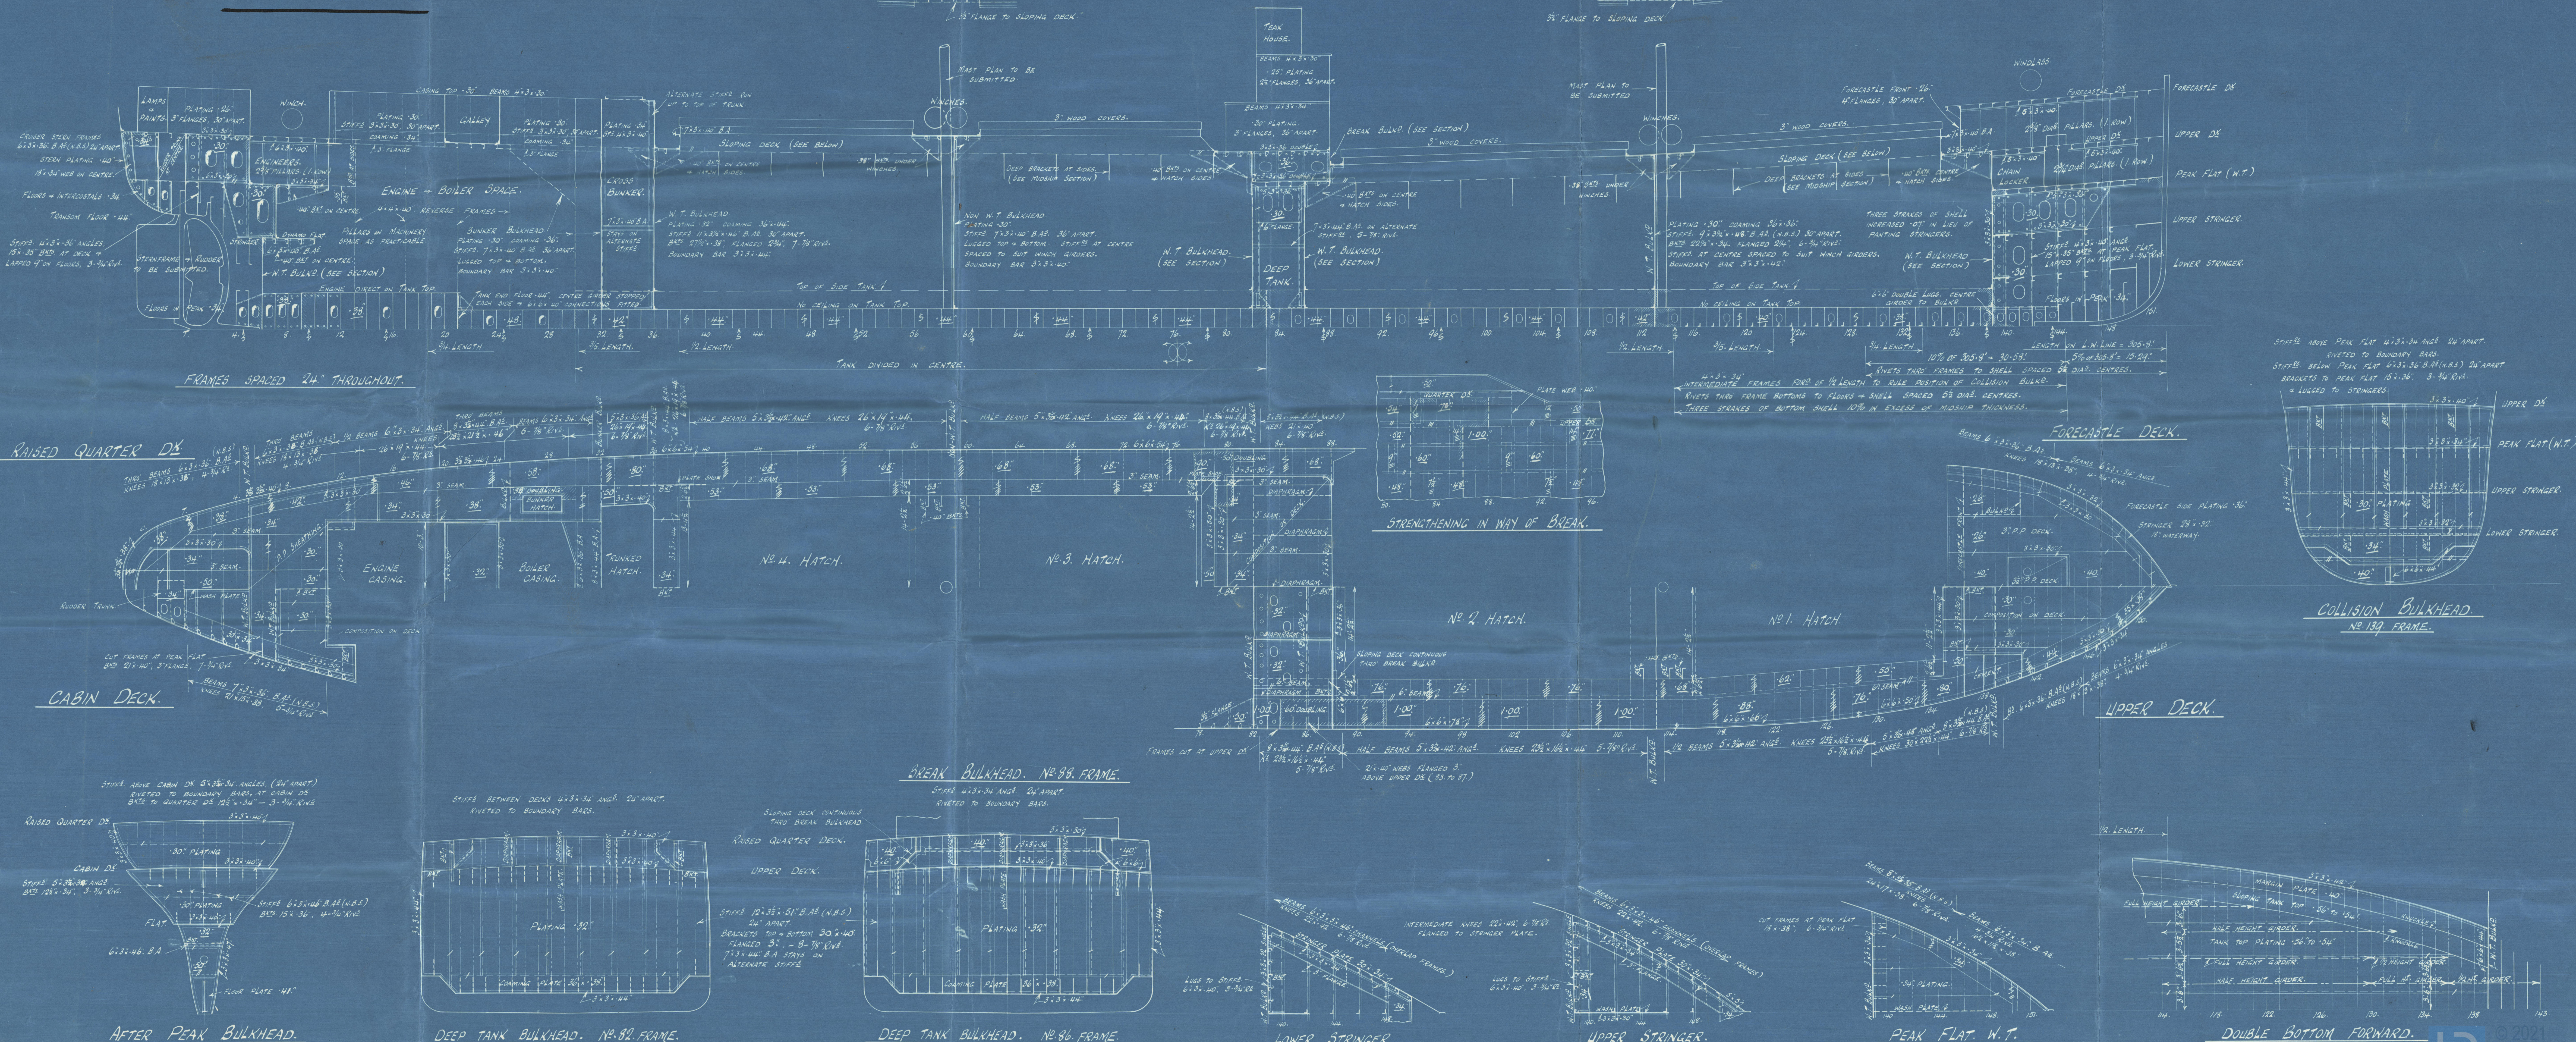

AFTER PEAK BULKHEAD.

DEEP TANK BULKHEAD. NO. 82. FRAME.

DEEP TANK BULKHEAD. NO. 86. FRAME.

LOWER STRINGER.

UPPER STRINGER.

PEAK FLAT. W.T.

DOUBLE BOTTOM FORWARD.

S.S. "Goodwood"


Profile & Decks,

As Built

S.P. Austin's 343.

SUNDERLAND RPT. NO. 32173

RETAIN

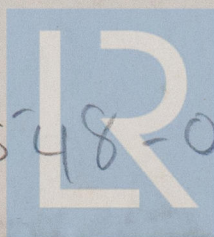

© 2021

W548-0166

Lloyd's Register
Foundation